
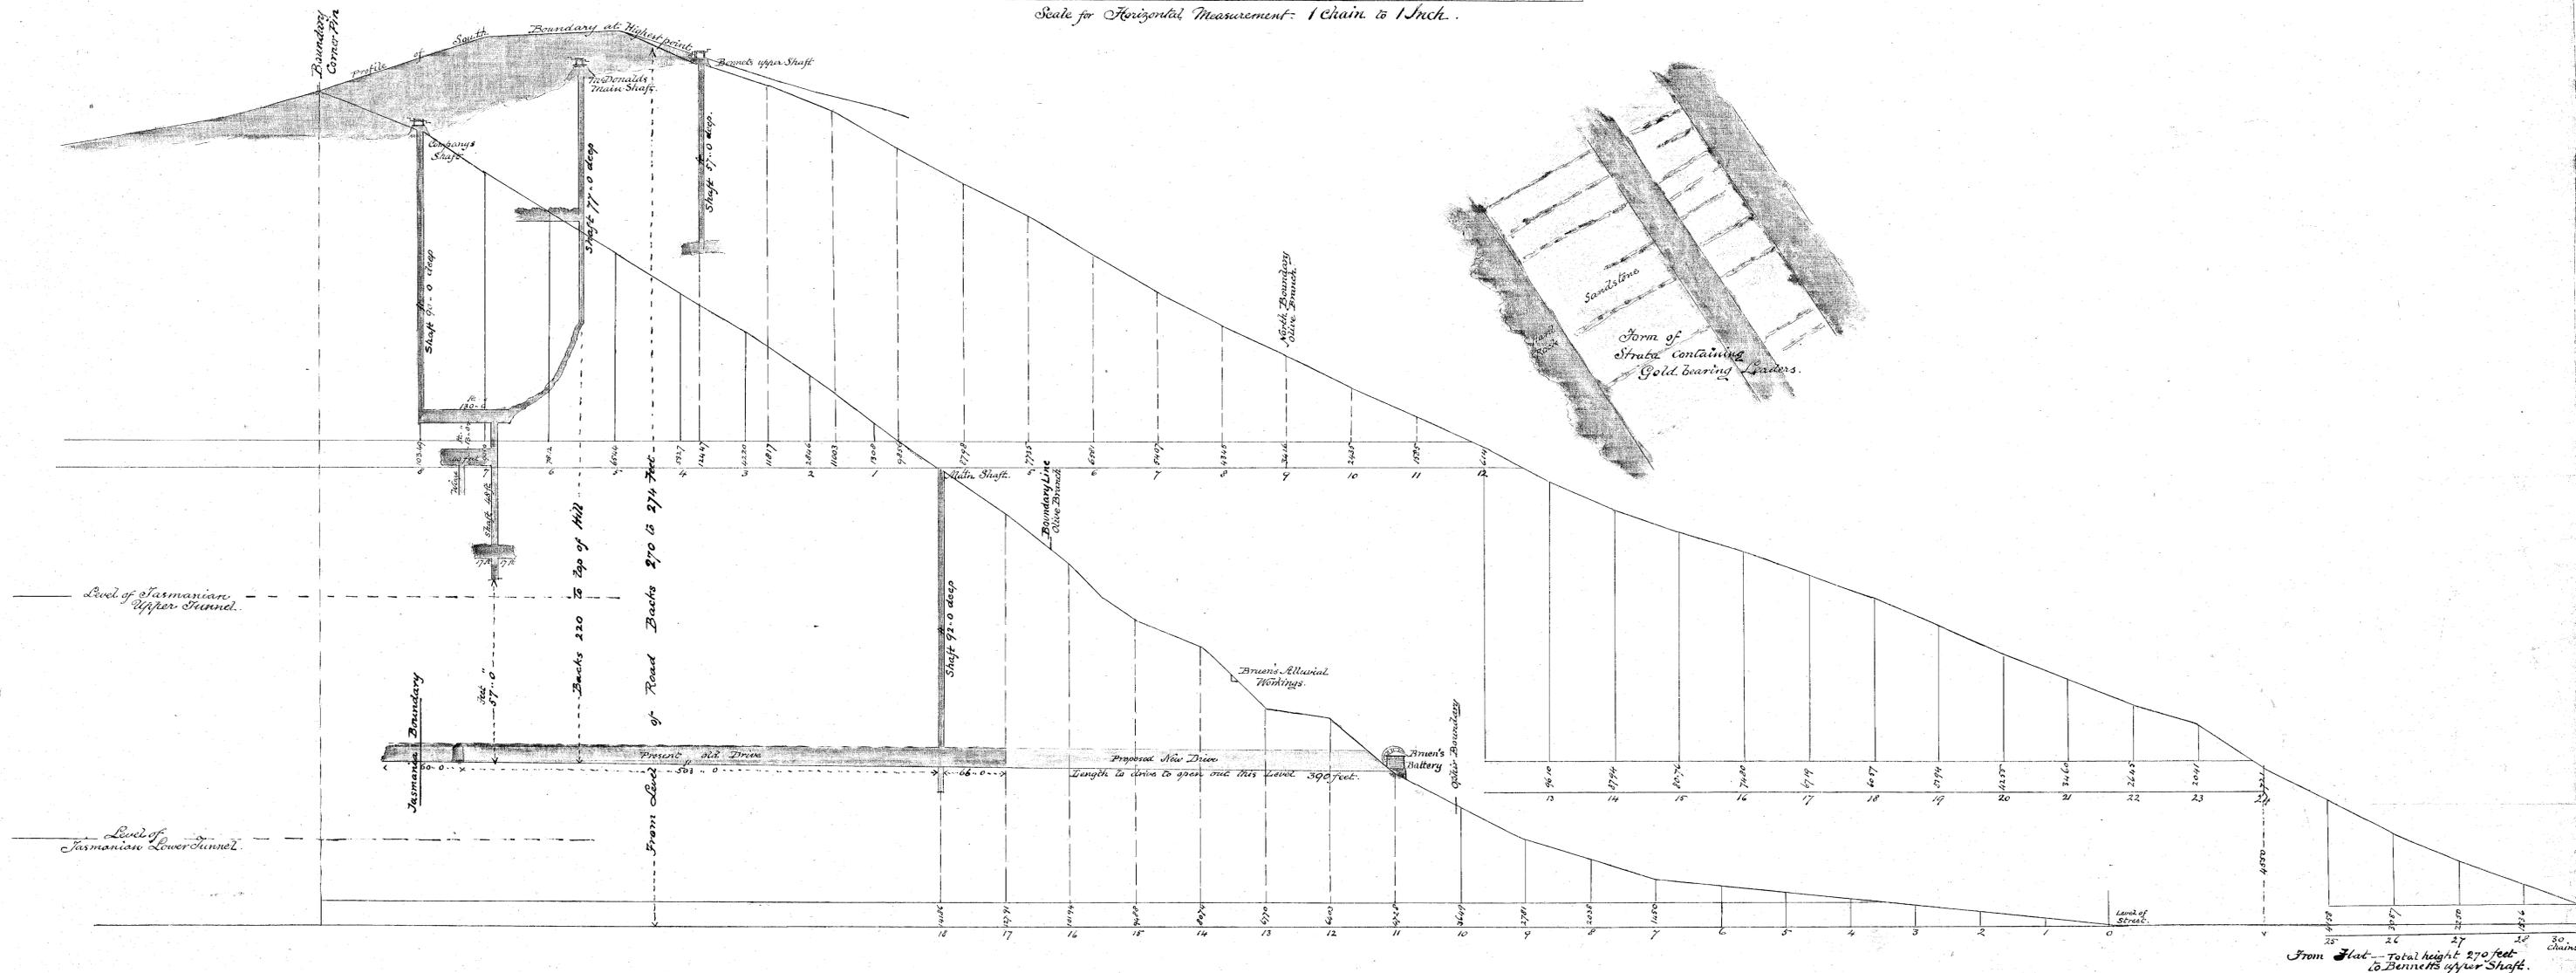


N^o 2.

OLIVE BRANCH GOLD MINING CO.

SECTION showing LEVELS DEPTHS of shafts and present Workings on the Company's Claim at Beaconsfield.

Taken June 1881.

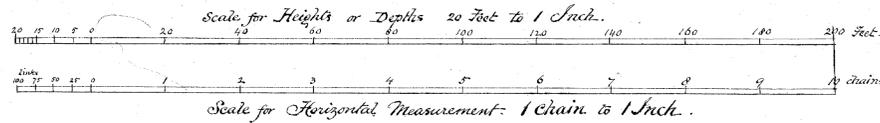

From Flat - Total height 270 feet to Bennetts upper Shaft.

Handwritten notes:
1000 ft above sea level
1000 ft above sea level

112-07

5 cm

112-07