
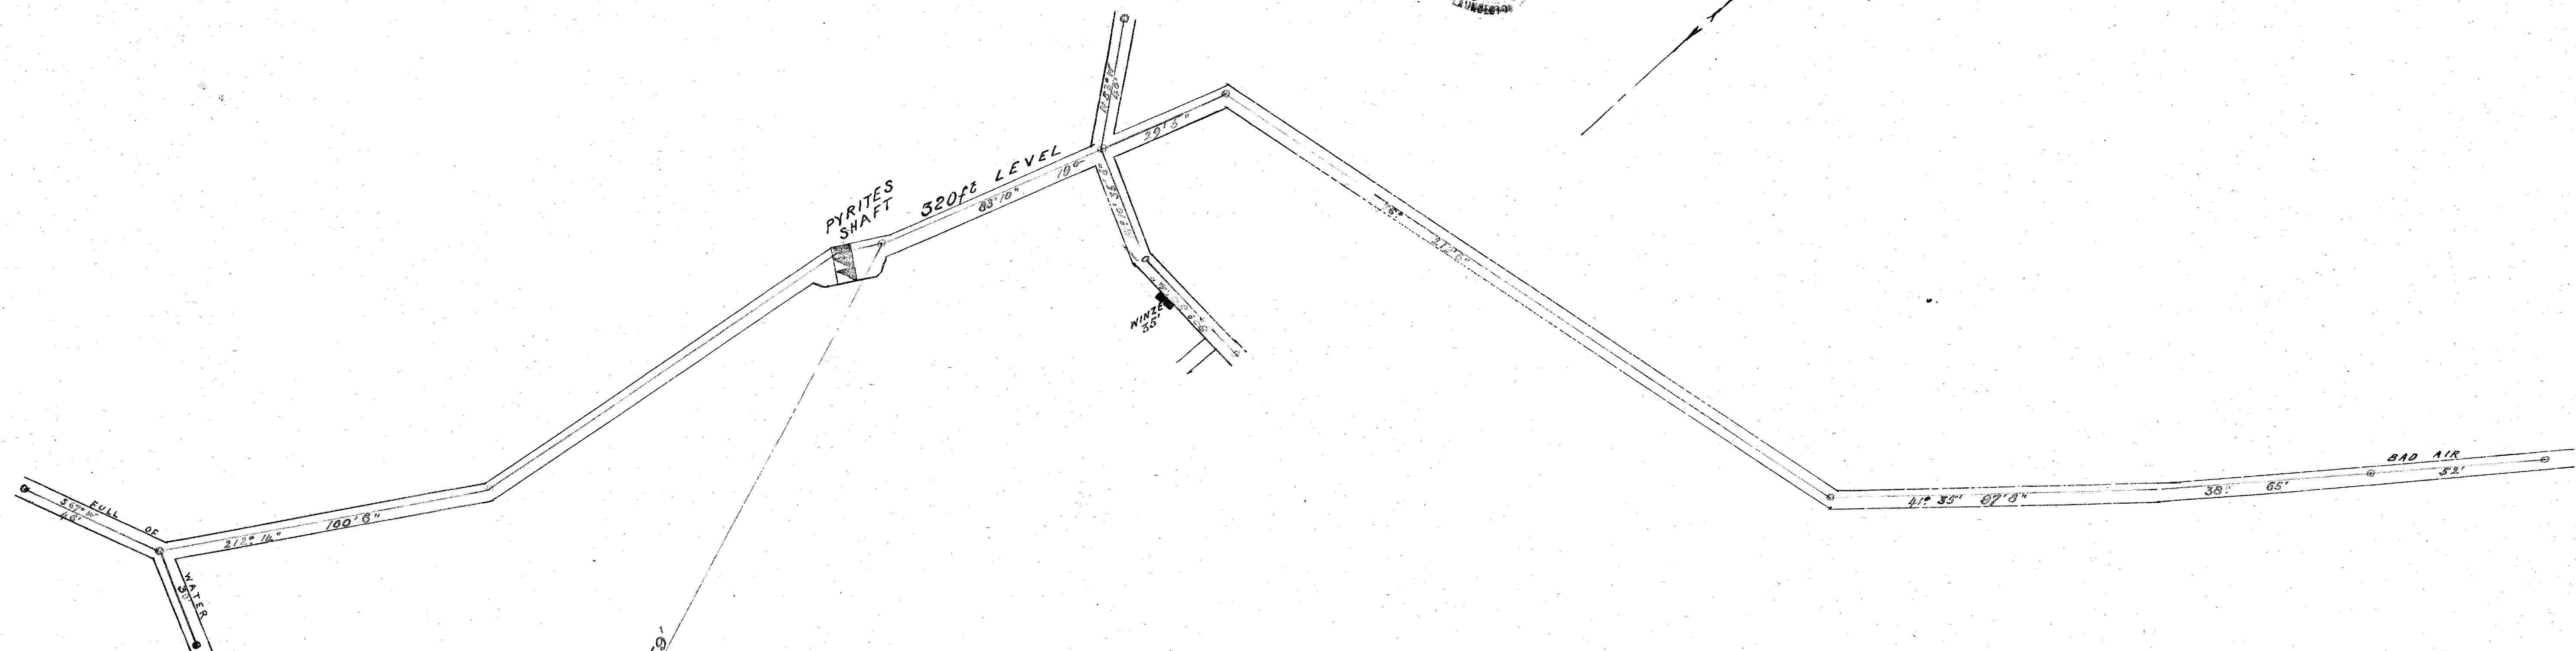


LITTLE WONDER C.M.

Scale 25 ft. to 1 inch.

RECEIVED OF MINE DEPT.
1897

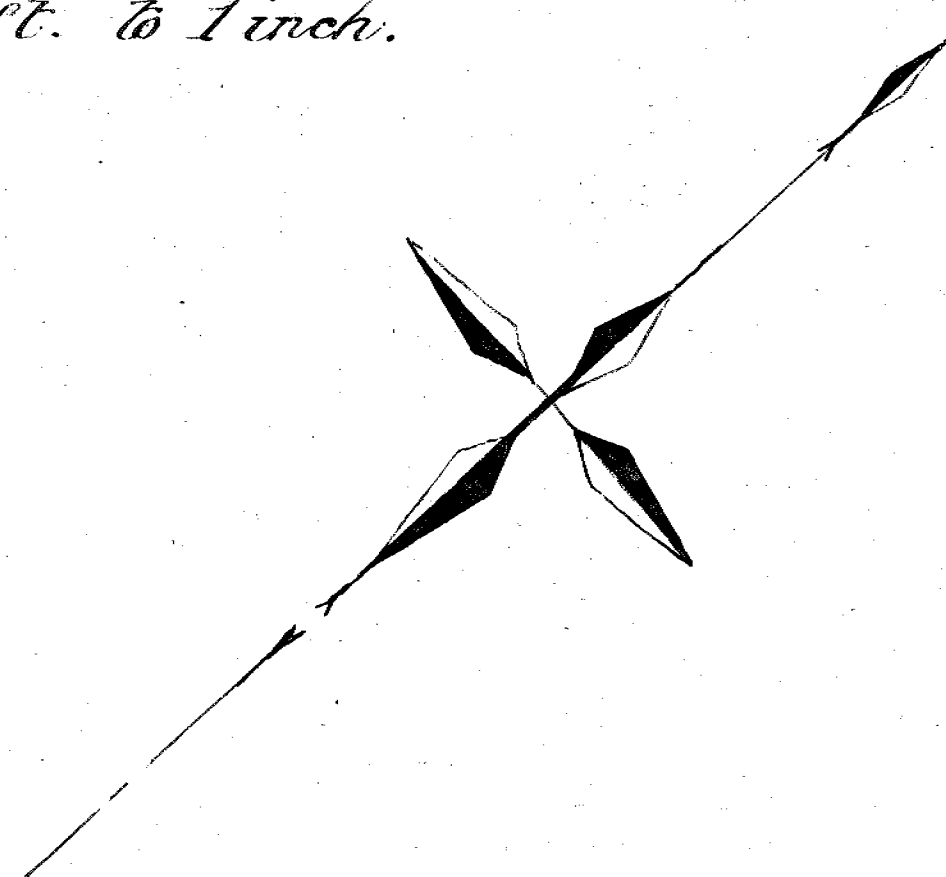

MOONLIGHT C.M.

Verified correct copy
of plan of work shown
during year 1896
C. Bingle & Co.
Feb 3rd 1897.

RECEIVED OF MINE DEPT.
1897

113-01

5 cm

113-01