
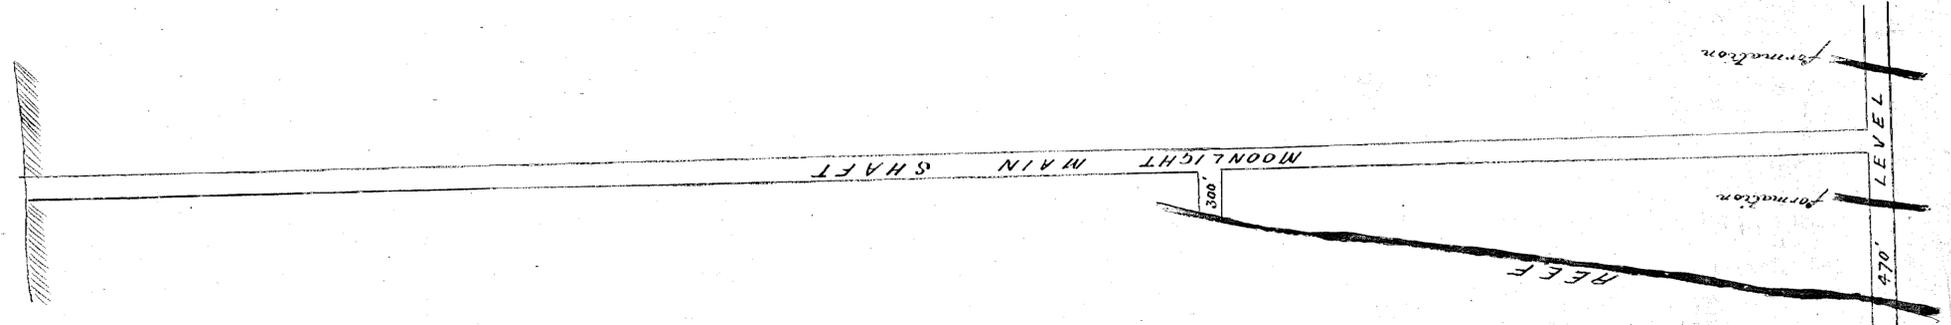


**PLAN**  
*Showing work done in 1897.*  
*Scale 25ft to 1 inch.*

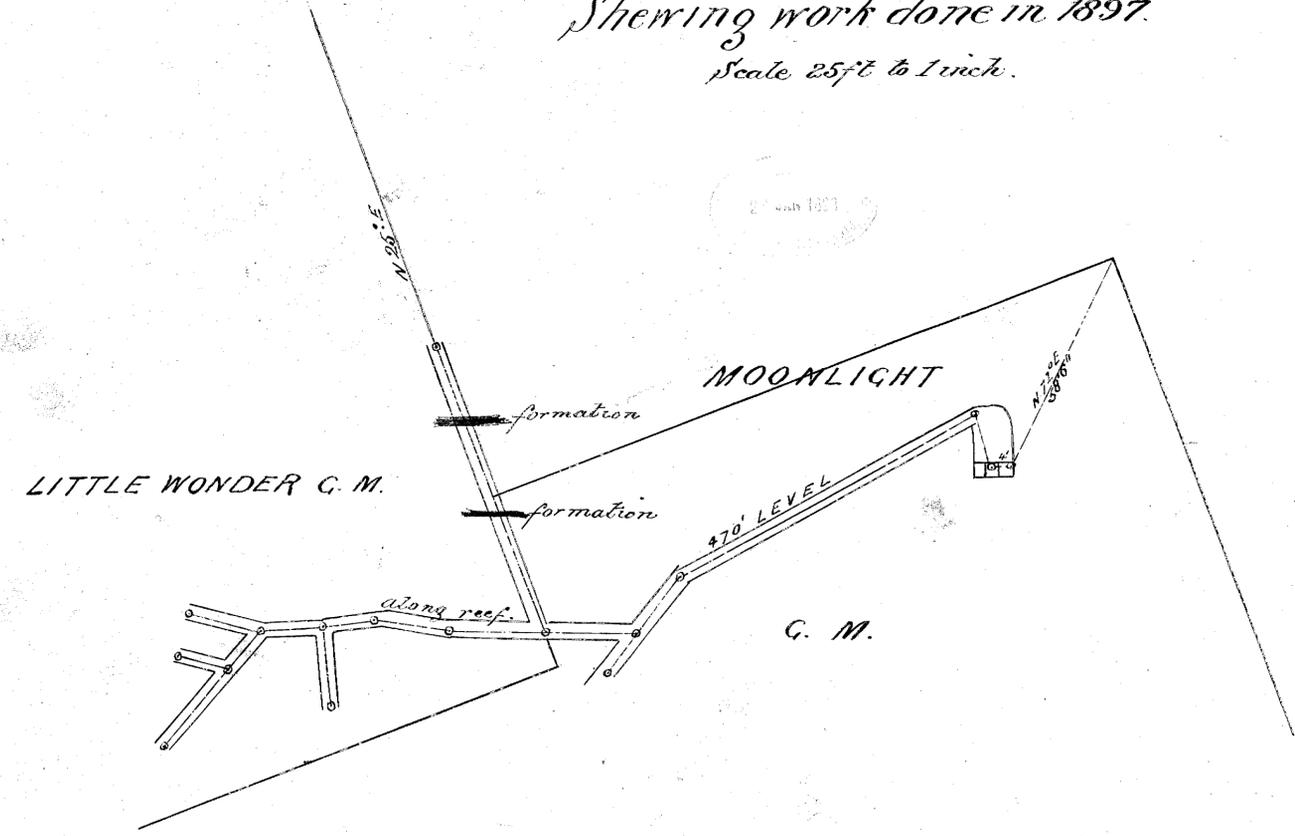

*Work done during 1897  
 compared from data by  
 former manager  
 full of fault over  
 E. P. Newby  
 24/2/98*

113-02

5 cm

*113-02*

113-02