


PLAN

Shewing work done in the
LITTLE WONDER C.M.

during the year 1898
Scale 25ft to one inch.

50m

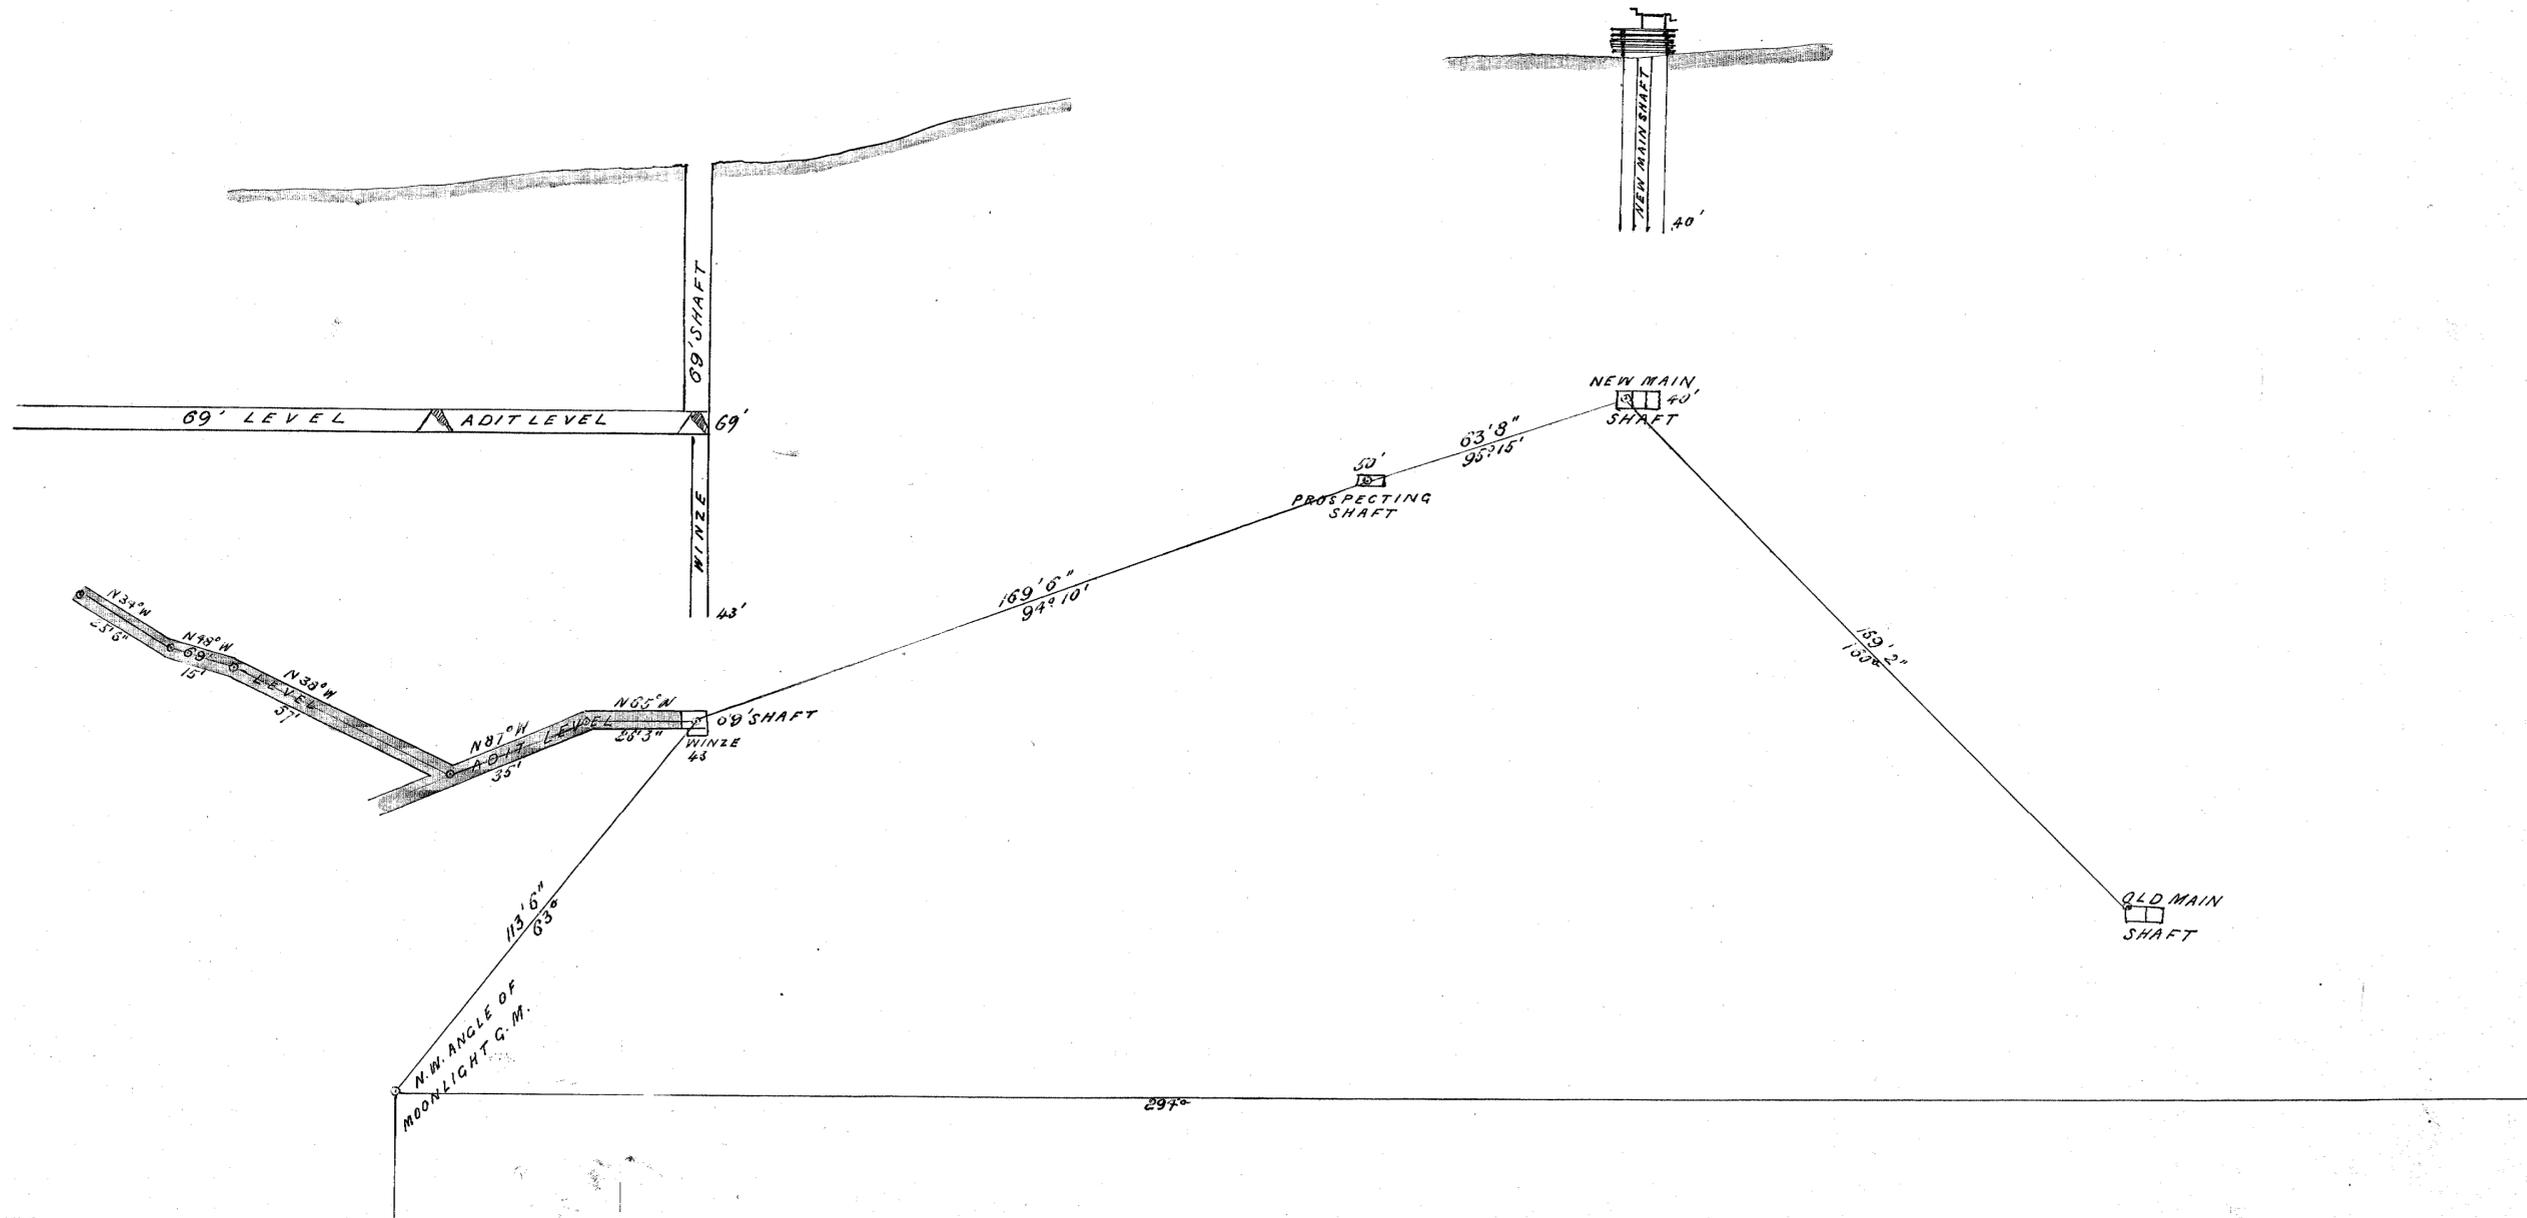

Verified correct copy of
 plan of work done during
 1898. Surveyed with
 exception of 69' level
 @ Prince of Wales
 Creek Survey
 29/1/99