



113-04

— PLAN AND SECTION —

— LITTLE WONDER GOLD MINE —

— BEACONSFIELD —

— SCALE 25 FEET TO 1 INCH —

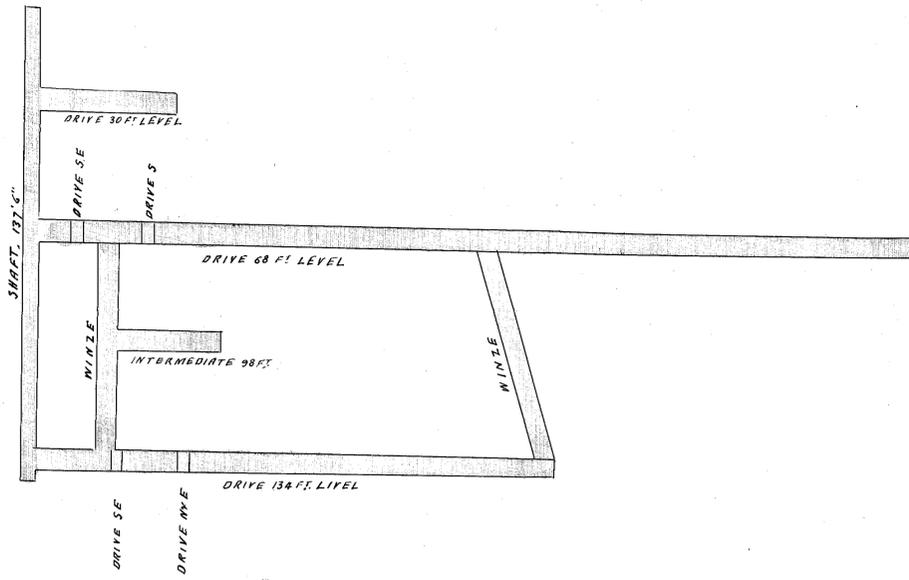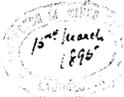

— LITTLE WONDER GOLD MINE —

232
87 G

— 5 . 0 . 0 —


— LITTLE WONDER GOLD MINE —

337

— 4 . 2 . 0 —

— LITTLE WONDER GOLD MINE —

— 294 —

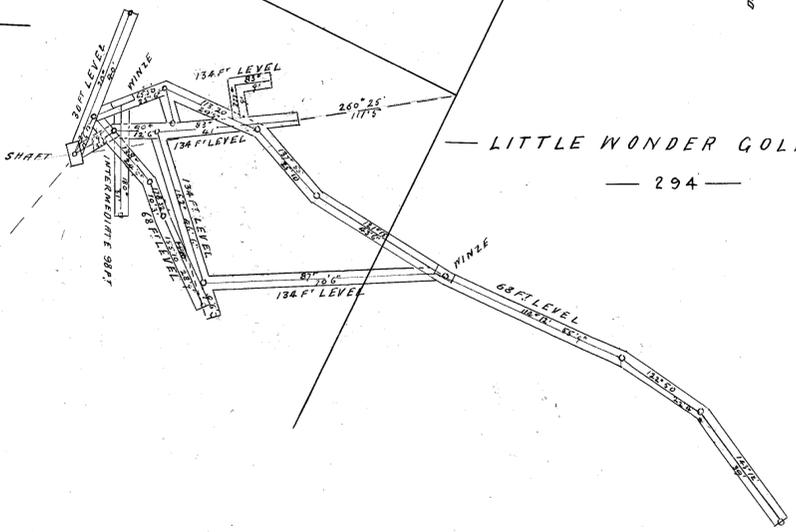

113-04

W. J. Burrows
ENGINEER
15/2/95
Заведующий
КАПТОМ ТЕХНИЧЕСКОГО
Д. И. П.

