


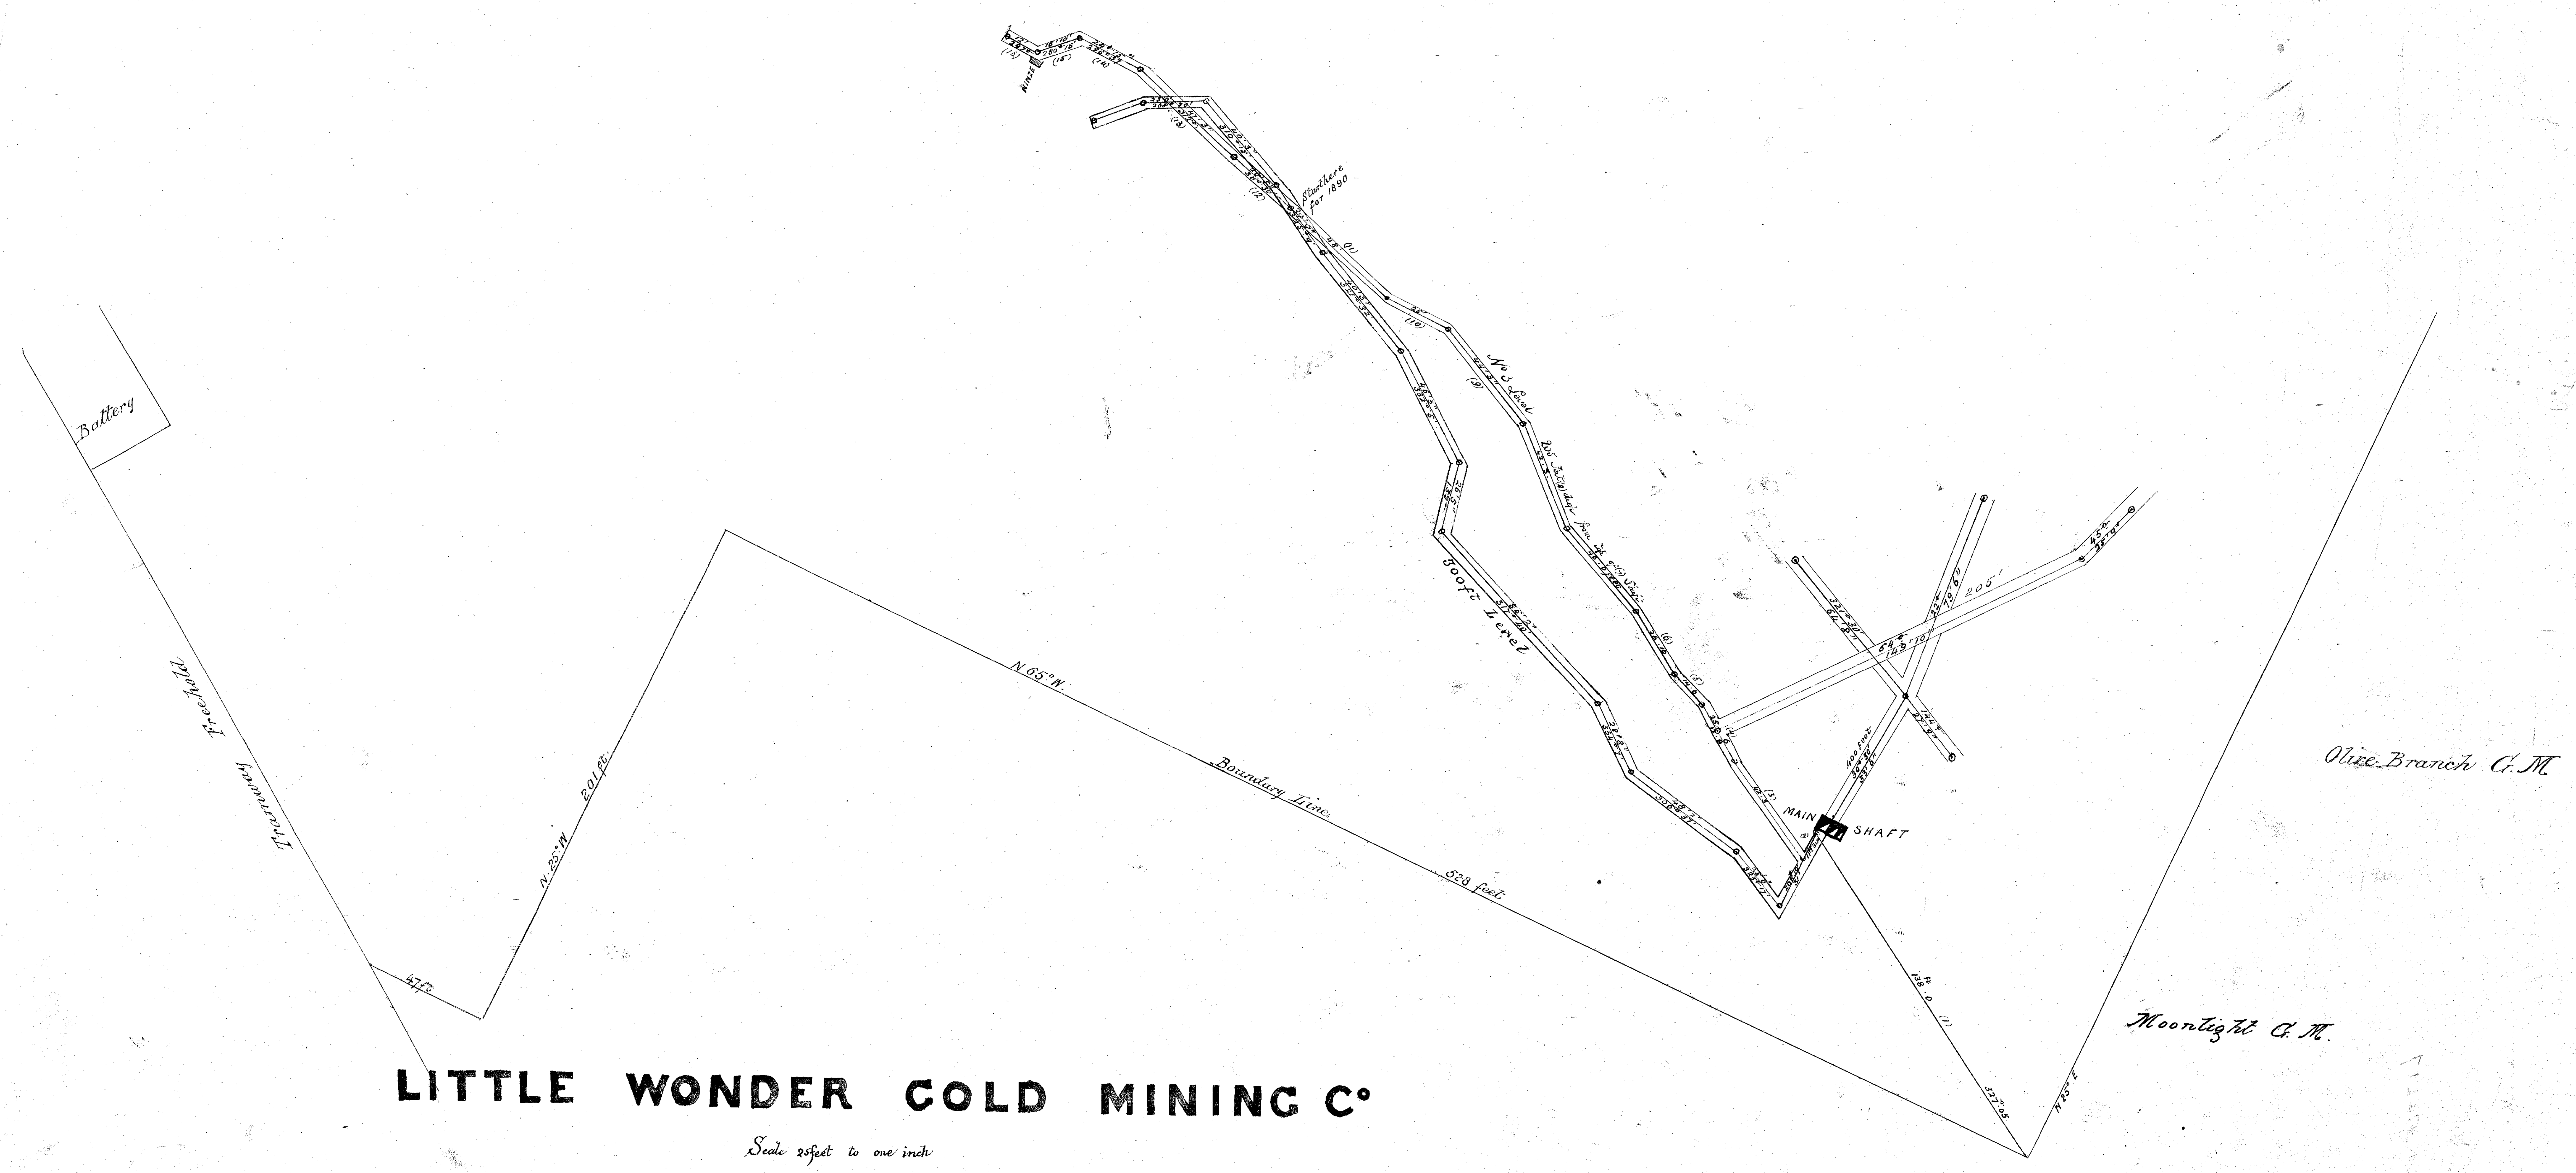

LITTLE WONDER GOLD MINING CO

Scale 20 feet to one inch

50-2-11
5 cm