
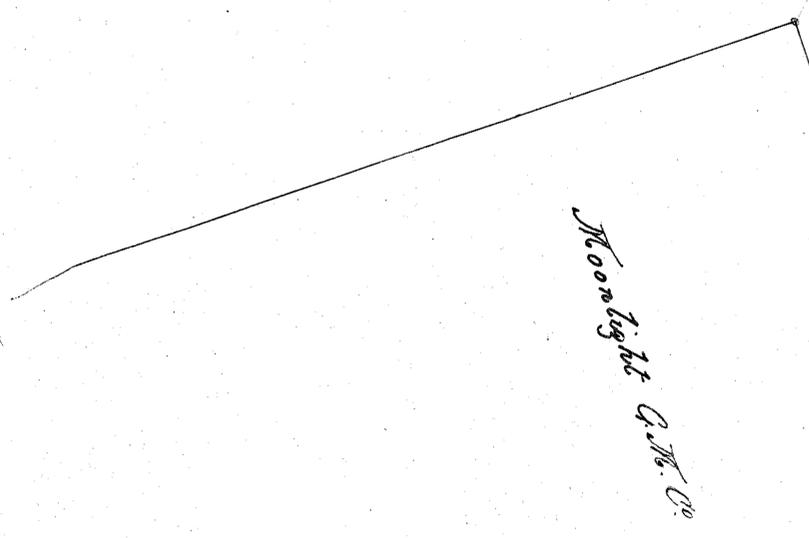


113-06

LITTLE WONDER G.M.

Scale 25ft. to 1 in.

21st Jan
1896.

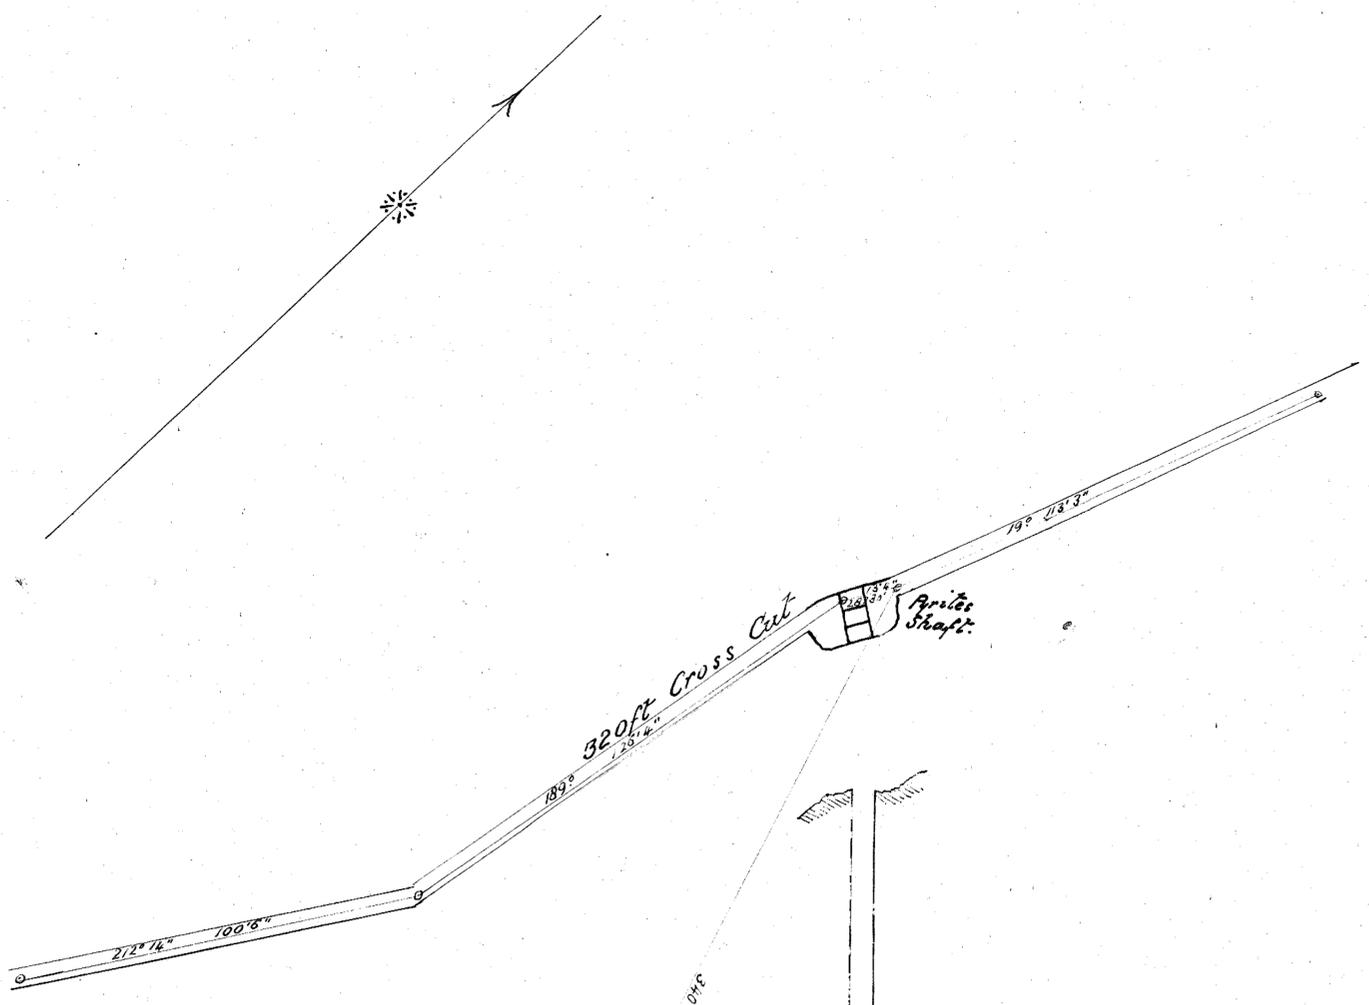

Pringle Watson
Auth. Survey
Jan 9th 1896

320ft.