
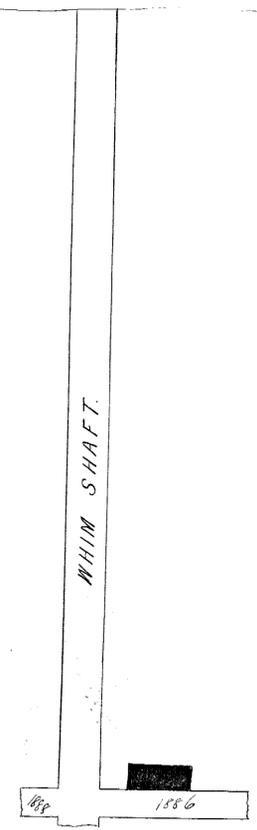


113-07

LITTLE WONDER G.M.

Scale 100 ft. to 4 inches.

5 cm

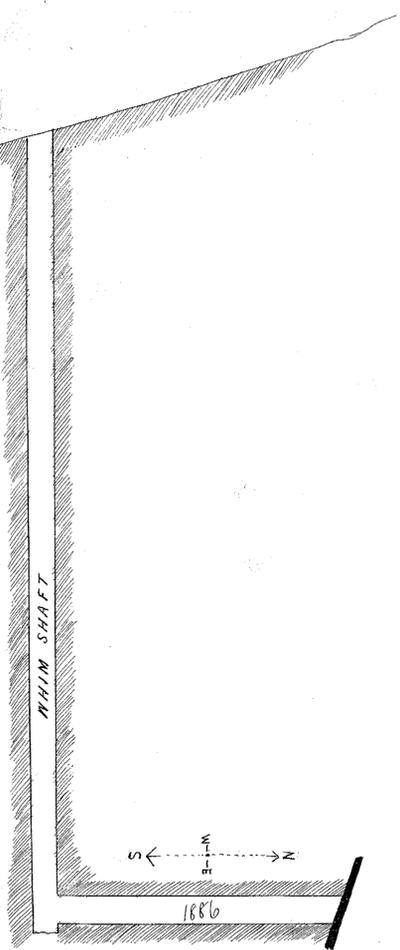

W. B. ...
W. B. ...
 1886