


Boundary Little Wonder



LITTLE WONDER GOLD MINING CO

Survey plan Shewing extent of Workings carried out during the Year 1889.

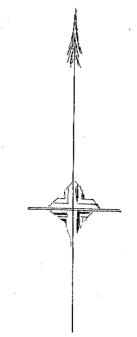

| | | |
|------------|---------|---|
| Line (11) | 48.0 | 312°24' |
| Line (10) | 25.0 | 116° |
| Line (9) | 44.3 | 327°04' |
| Line 8 | 42.3 | 158°04' |
| Line (7) | 40.0 | 318°43' |
| Line (6) | 26.10 | 148°50' |
| Line (5) | 14.6 | 316°53' |
| Line (4) | 25.6 | 150°21' |
| Line (3) | 42.3 | 324°55' |
| Line (2) | 64.0 | From S W angle of Shaft To junction of drive with Chamber |
| Line (1) | 11.9 | No 3 Level |
| No 5 Level | 16.55 | From S W angle of Main Shaft |
| Line (1) | 138.0 | To S West angle of Main Shaft |
| Line (1) | 327°05' | From S East Corner of Claim west Moonlight |
| Line (1) | 360 | |

Field Notes
Scale of 25 Feet to the Inch

Olive Branch
Gold Mining Co

Moonlight
Gold Mining Co

Joshua Tiggs
Authorized Surveyor
January 1890