
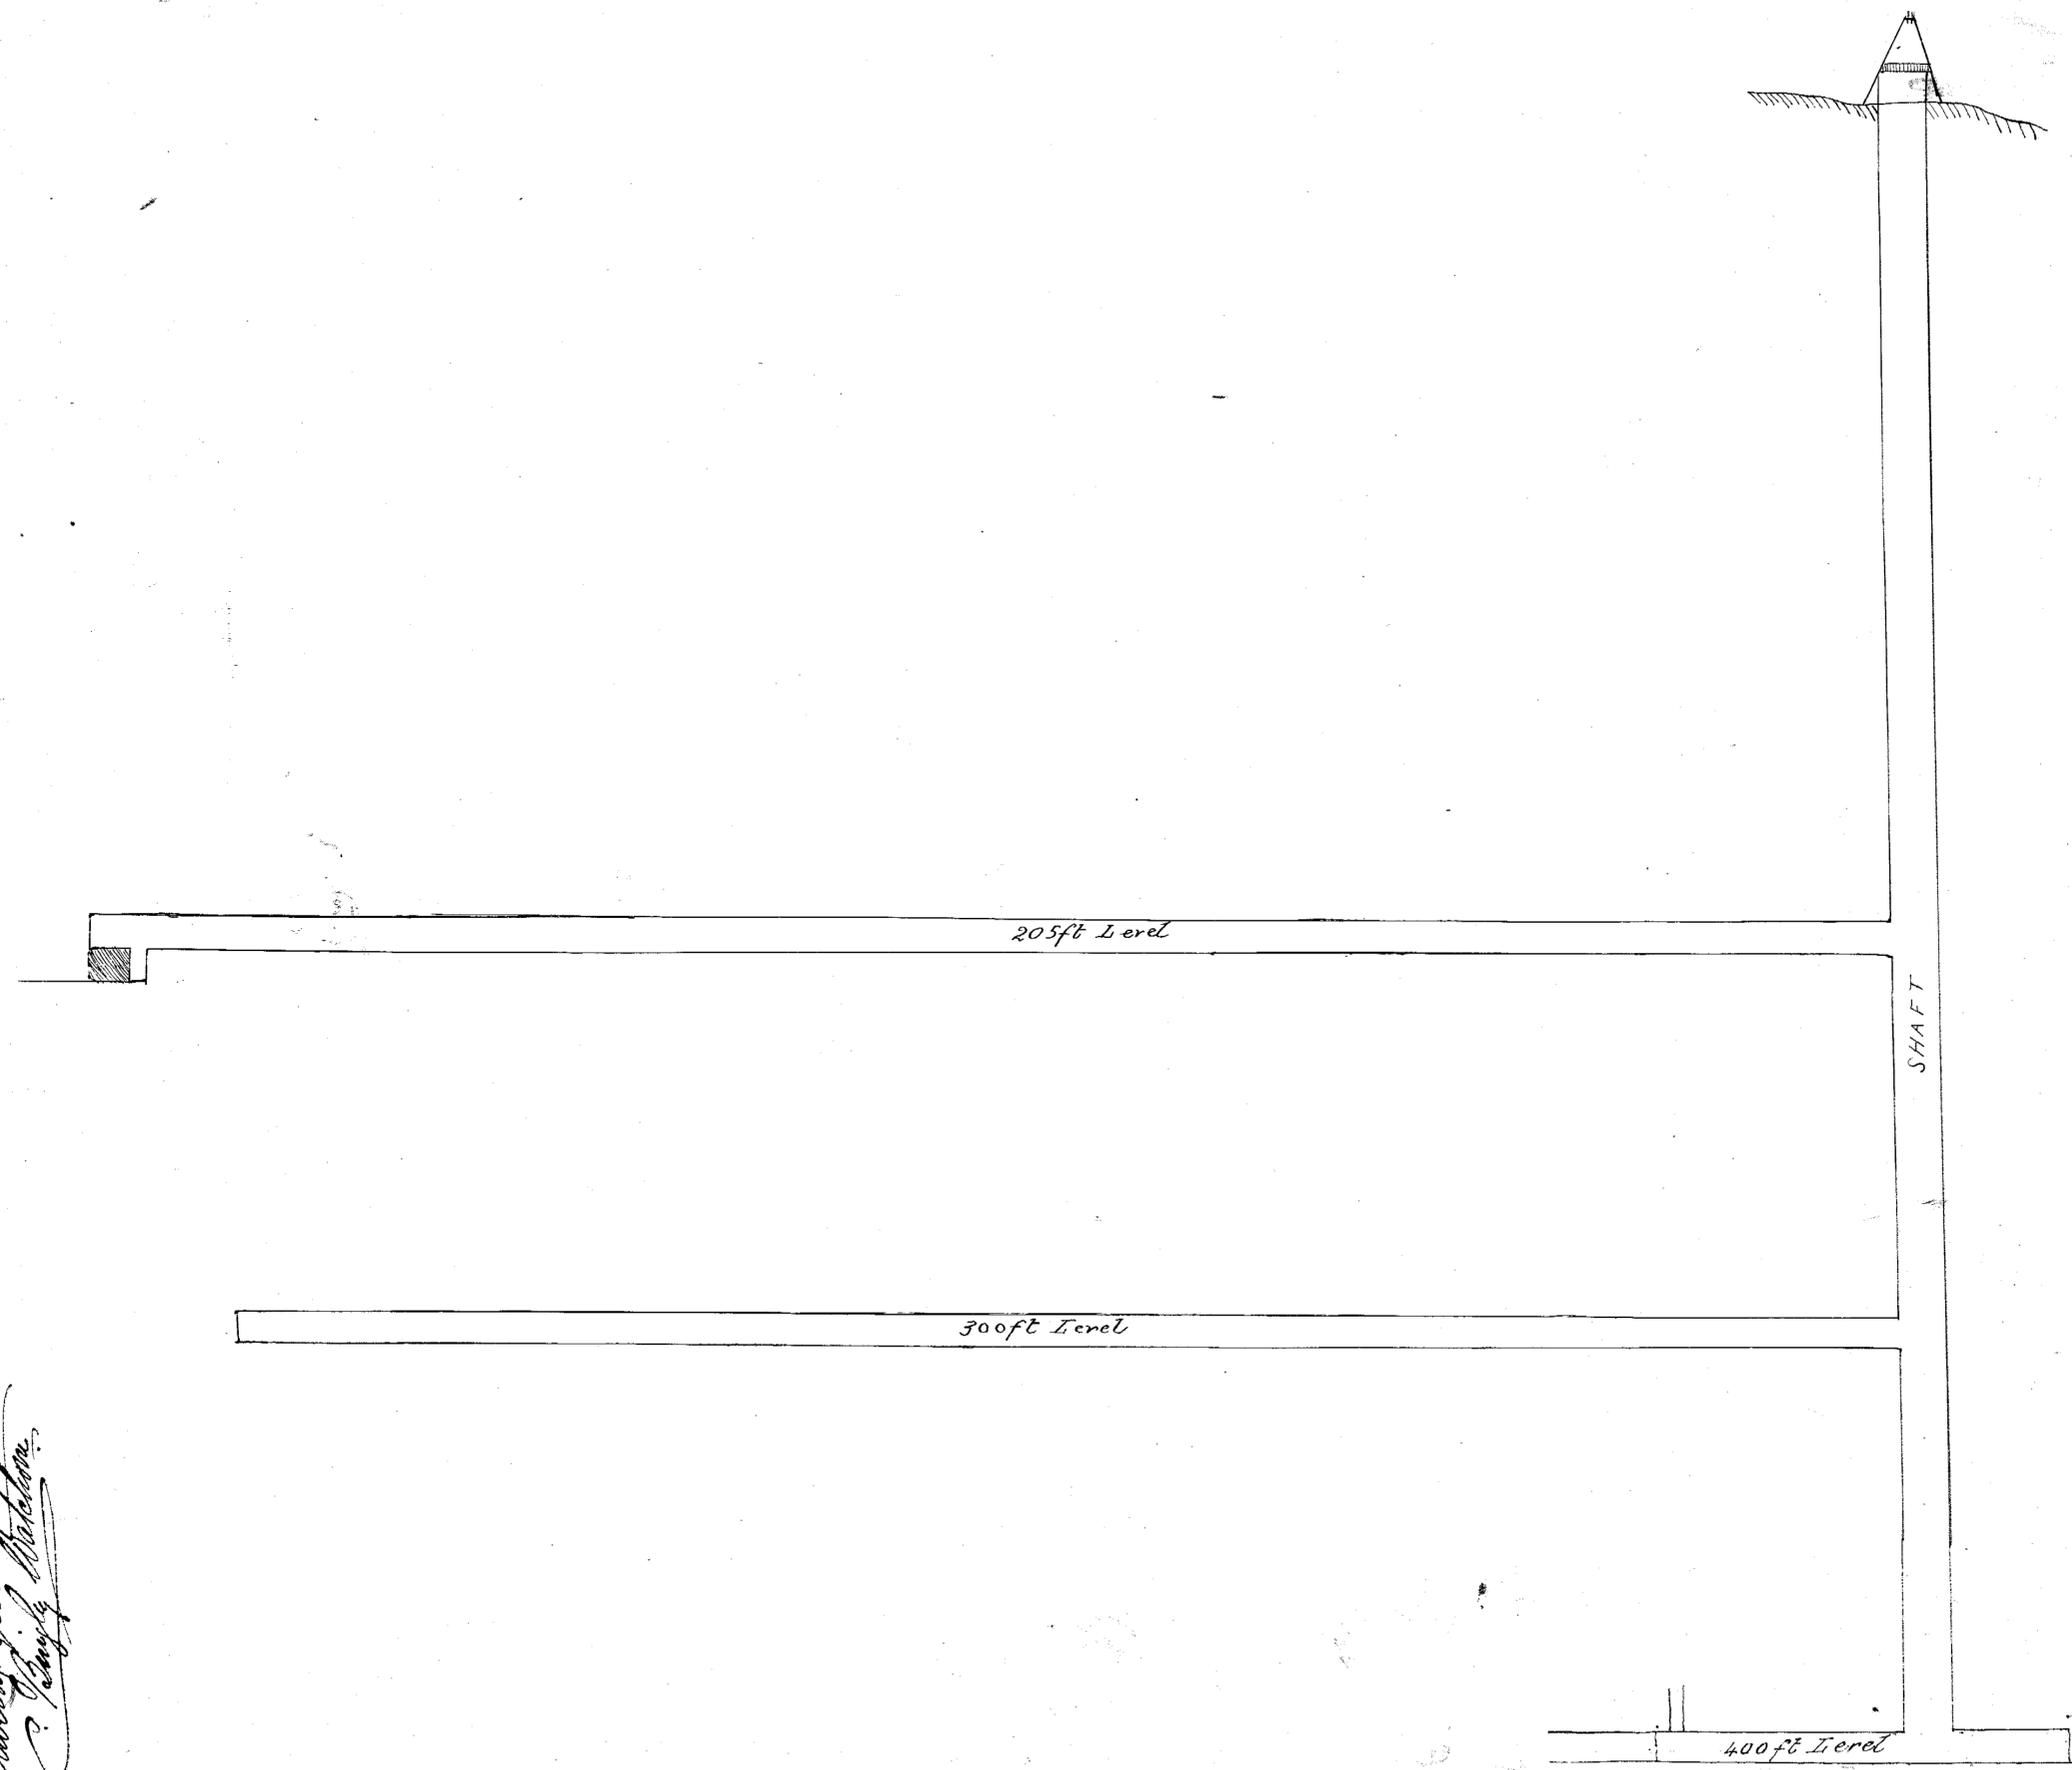


113-10

# LITTLE WONDER G.M.

*Longitudinal Section  
Scale 25 ft to an inch*

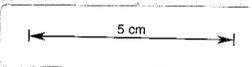

*Verified correct copy  
of plan of mine from  
Harvey's year 1890  
C. King's Blotter*