



114-02

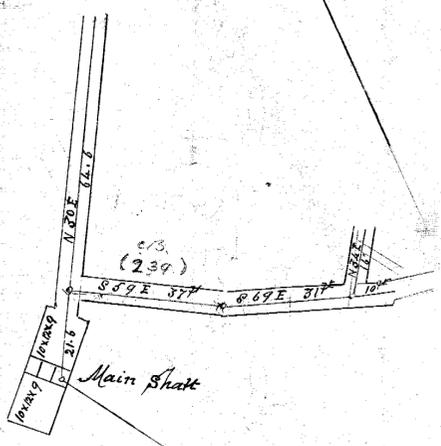


Surface

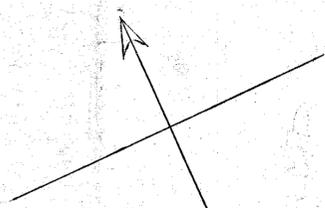

180
59
239

Main Shaft

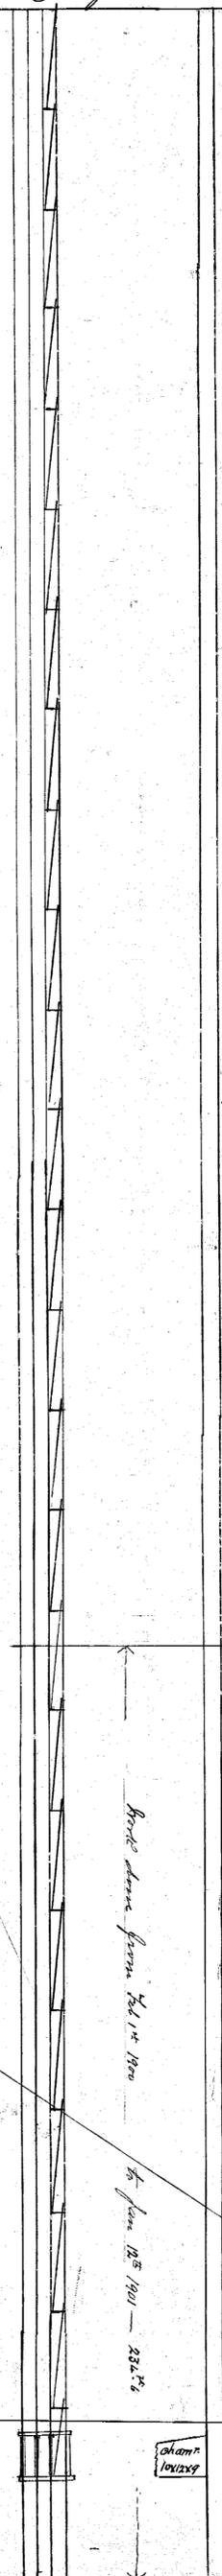

Bore done from Feb 1st 1900 to June 12th 1901 - 232' 6"

Little Wonder - Sect 294


Moonlight - Sect 295
874

Moonlight-cum-Wonder 4. M. Co

Scale 25' to 1"

L. Neavey M.M.

Jan 12th 1901

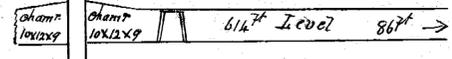

Moonlight - Sect 349

Vertical text on right margin