

114-03


114-03

5 cm

MOONLIGHT C.M.

LONGITUDINAL SECTION.

Scale 25 feet to an Inch.

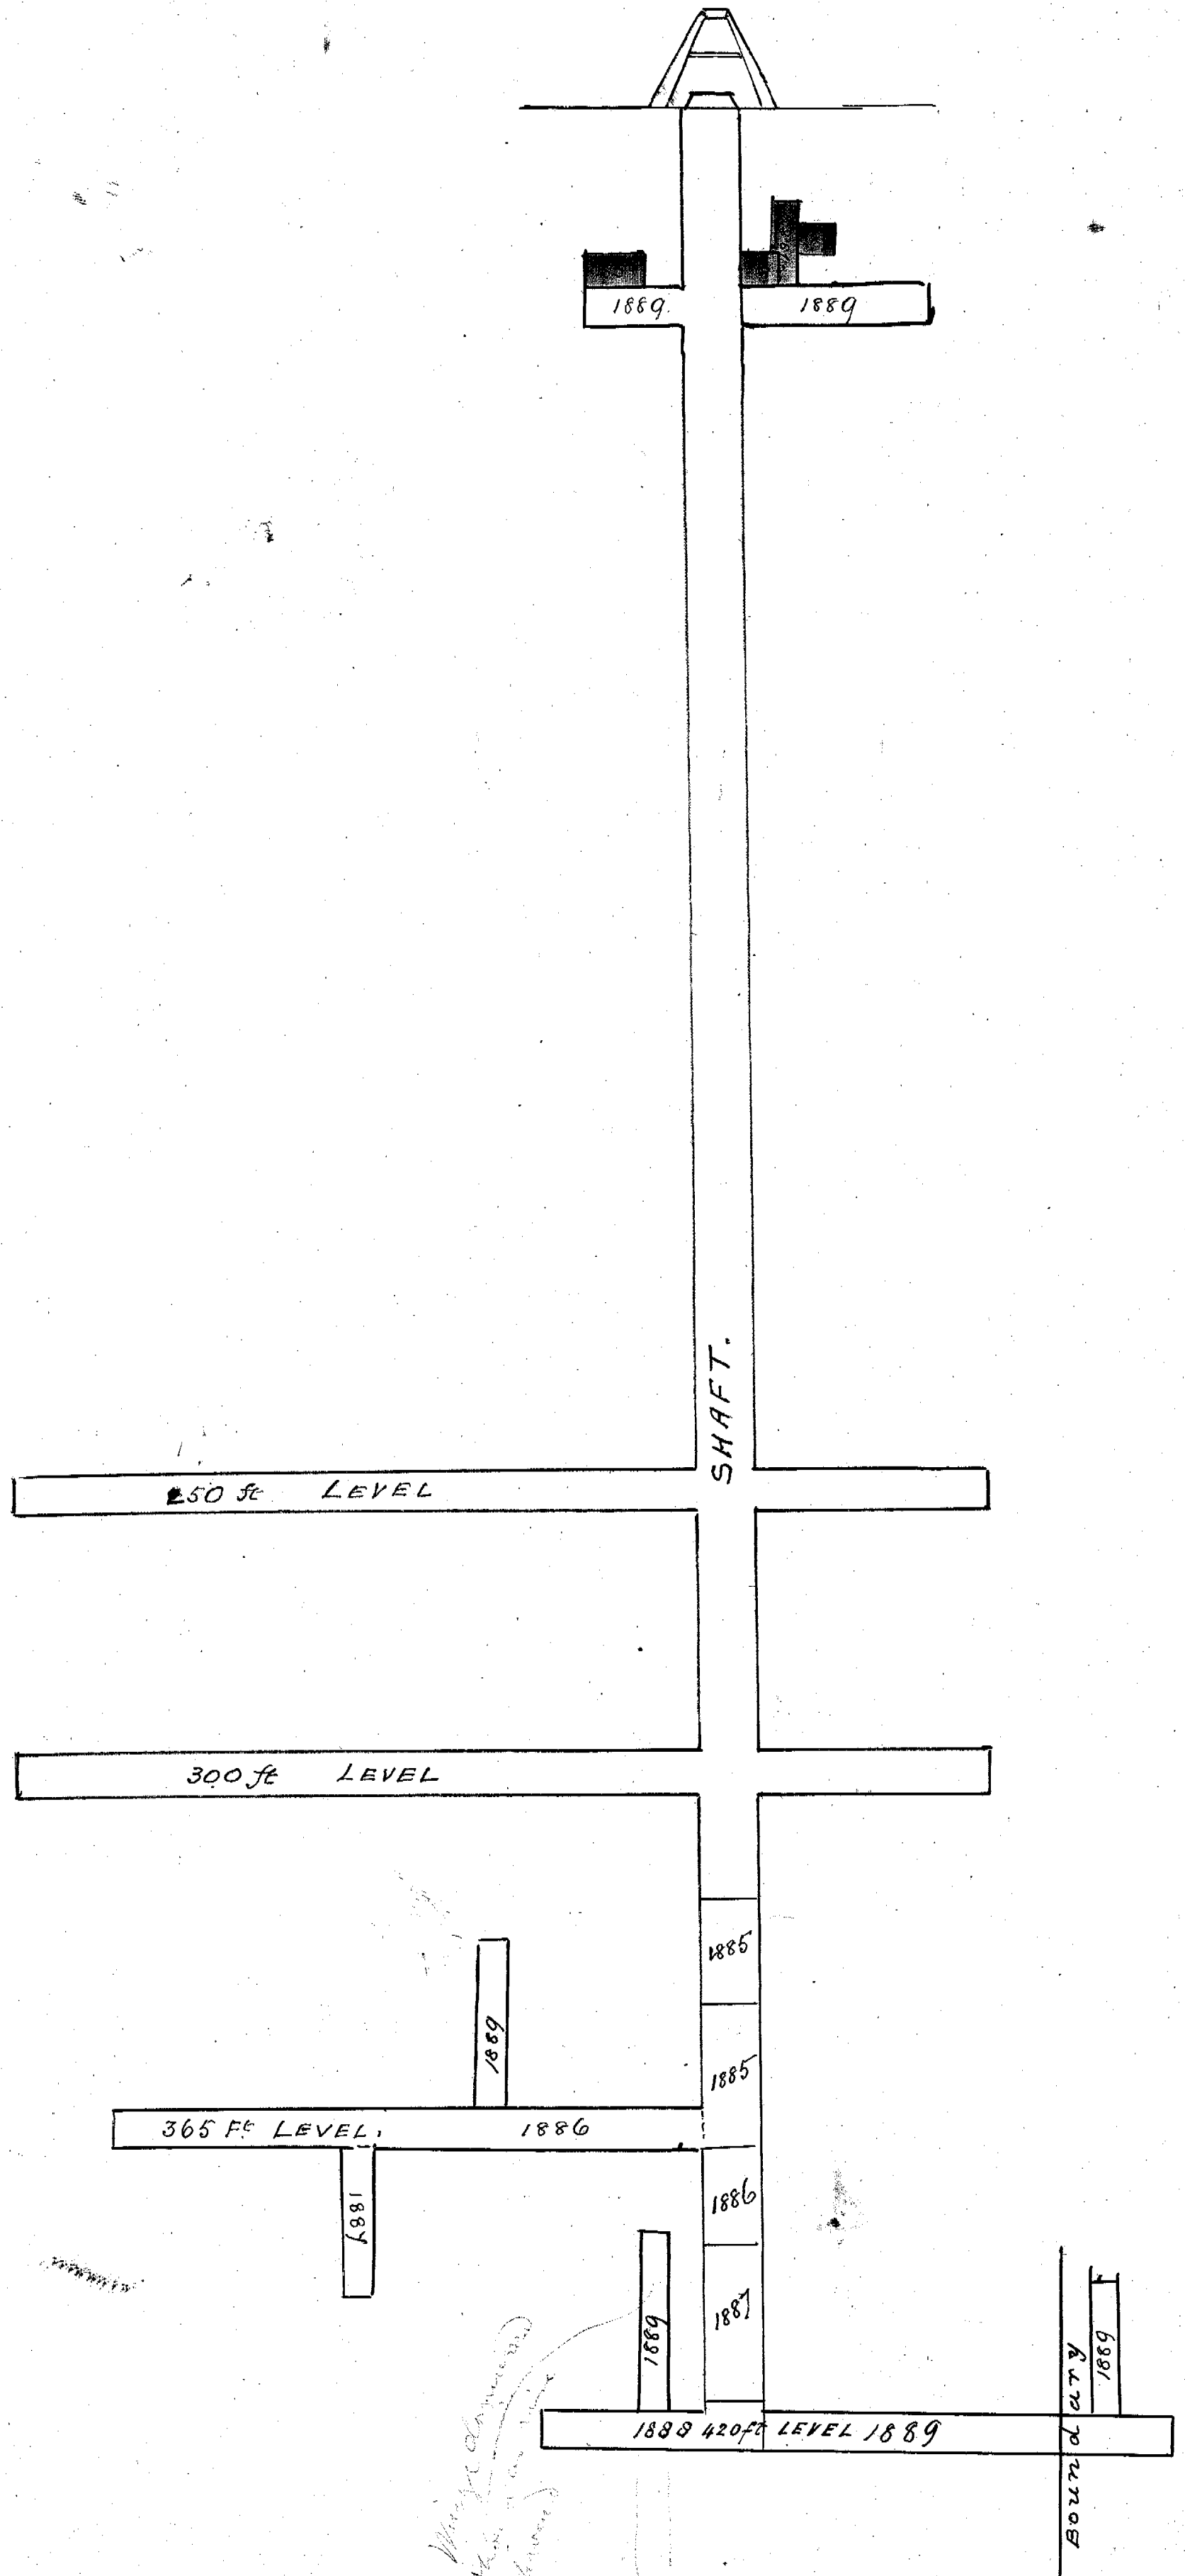

Corrected
Plan in Managers Office
C. R. B. Watson

2/1/89