


114-06

5 cm

Moonlight Main

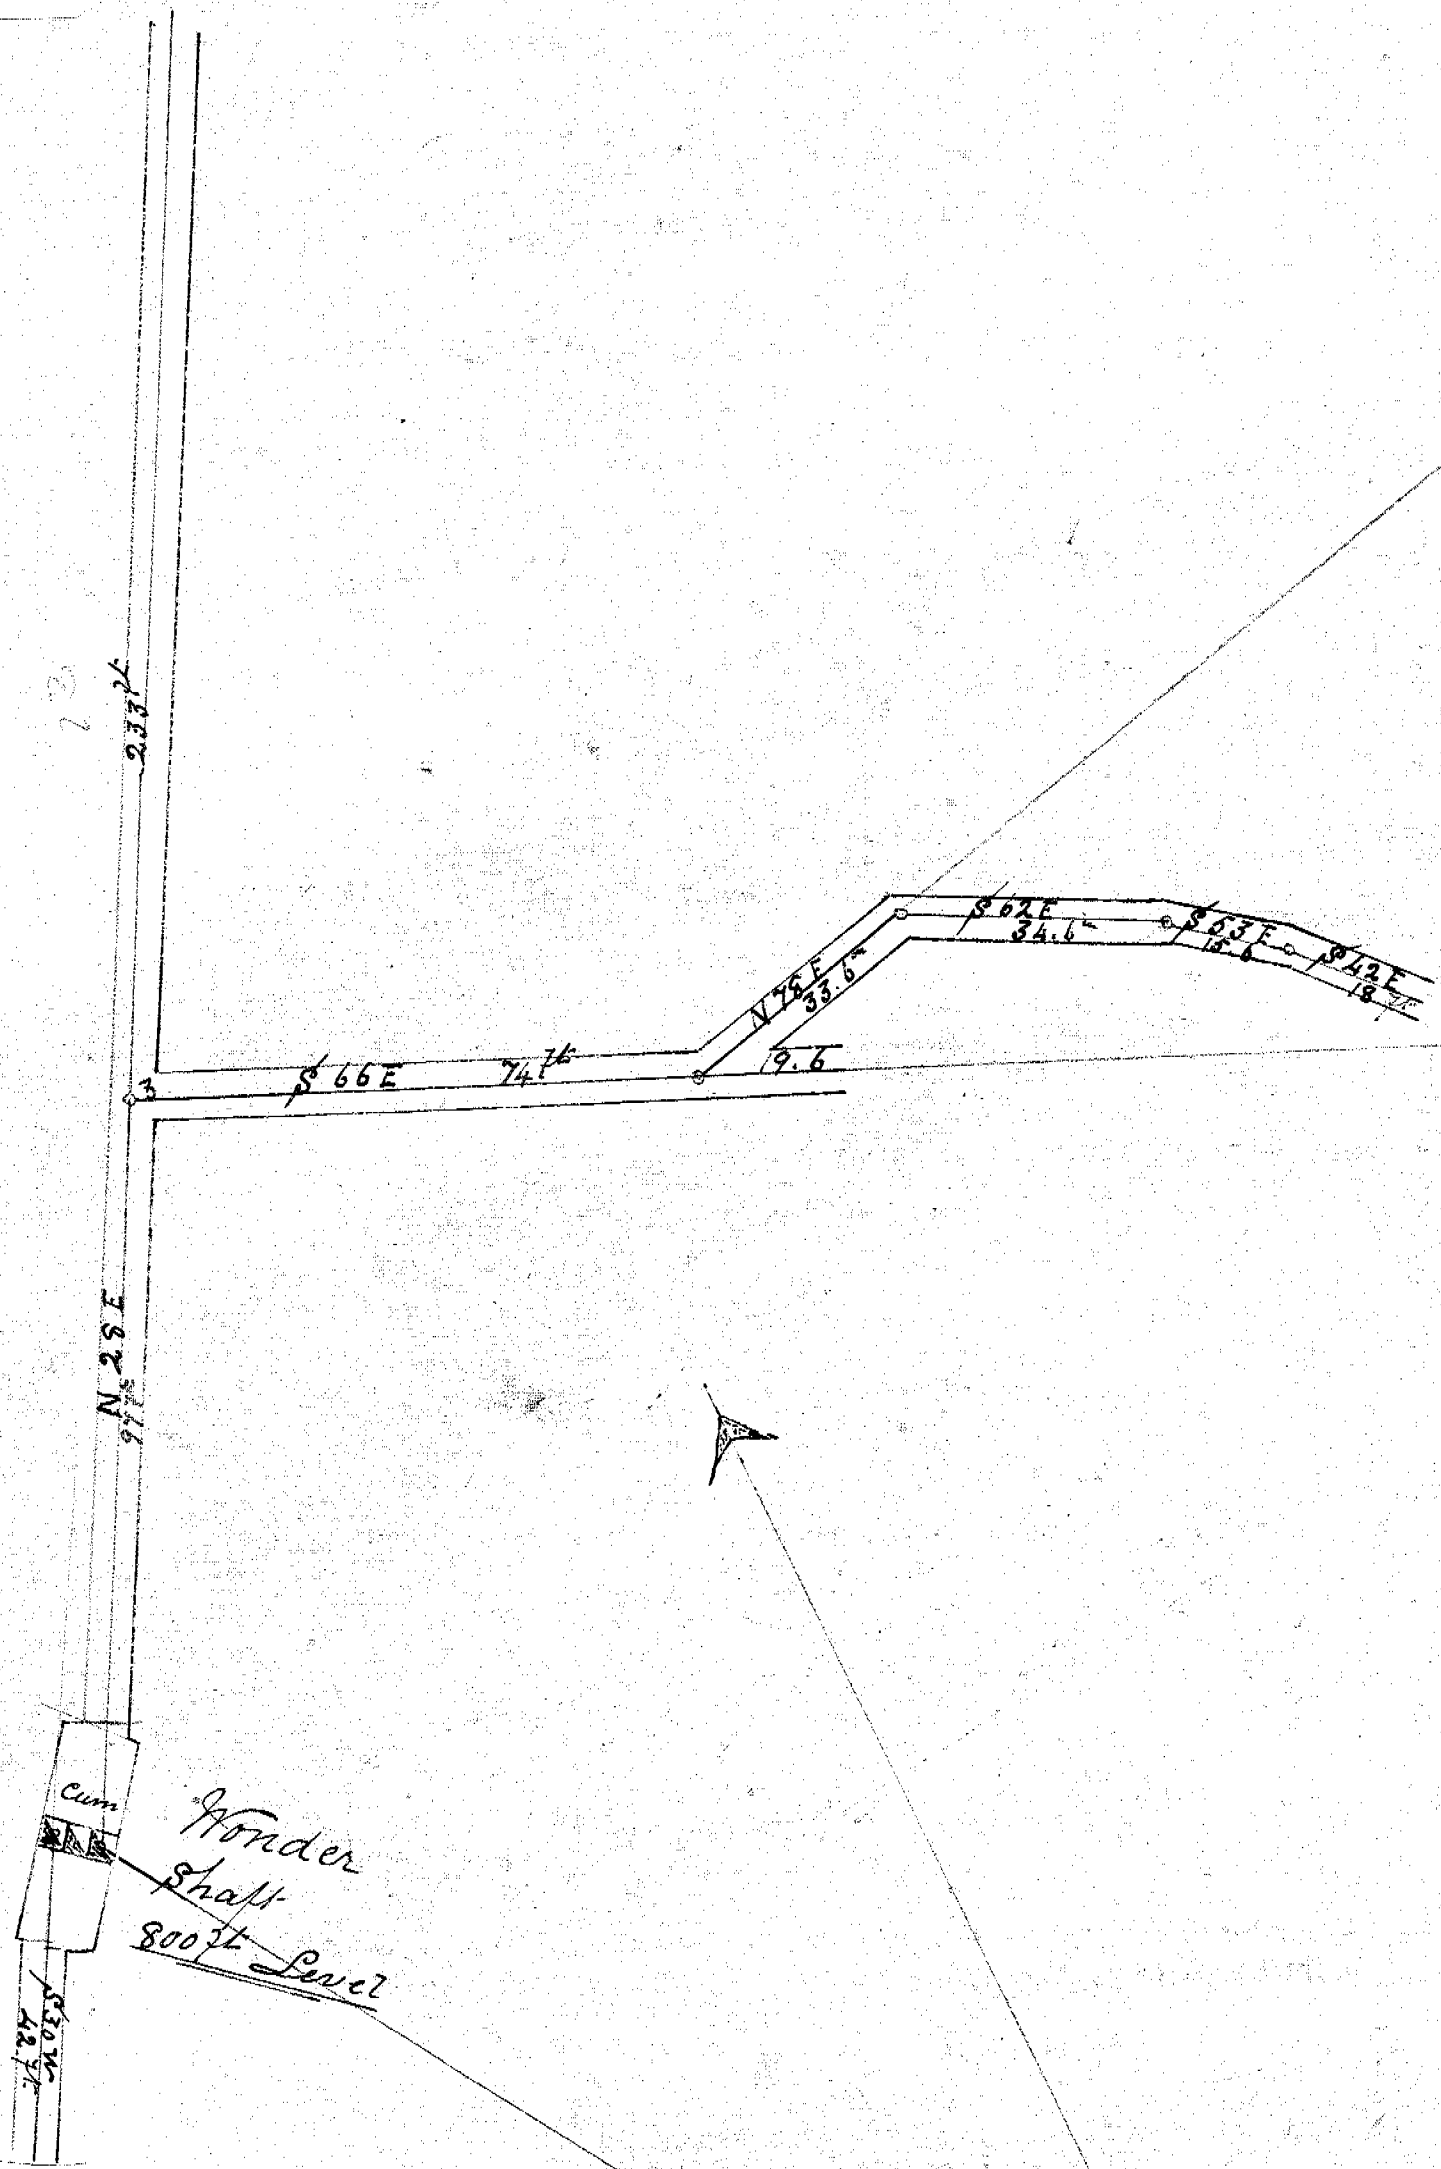

Moonlight cum Wonder G.M.C.

Scale 25 ft to 1 in

L. Neavey

Peasefields 15th Jan 1902



Little Wonder. Sect 274

Moonlight. Sect 274

Moonlight. Sect 349