




*Boonaham*

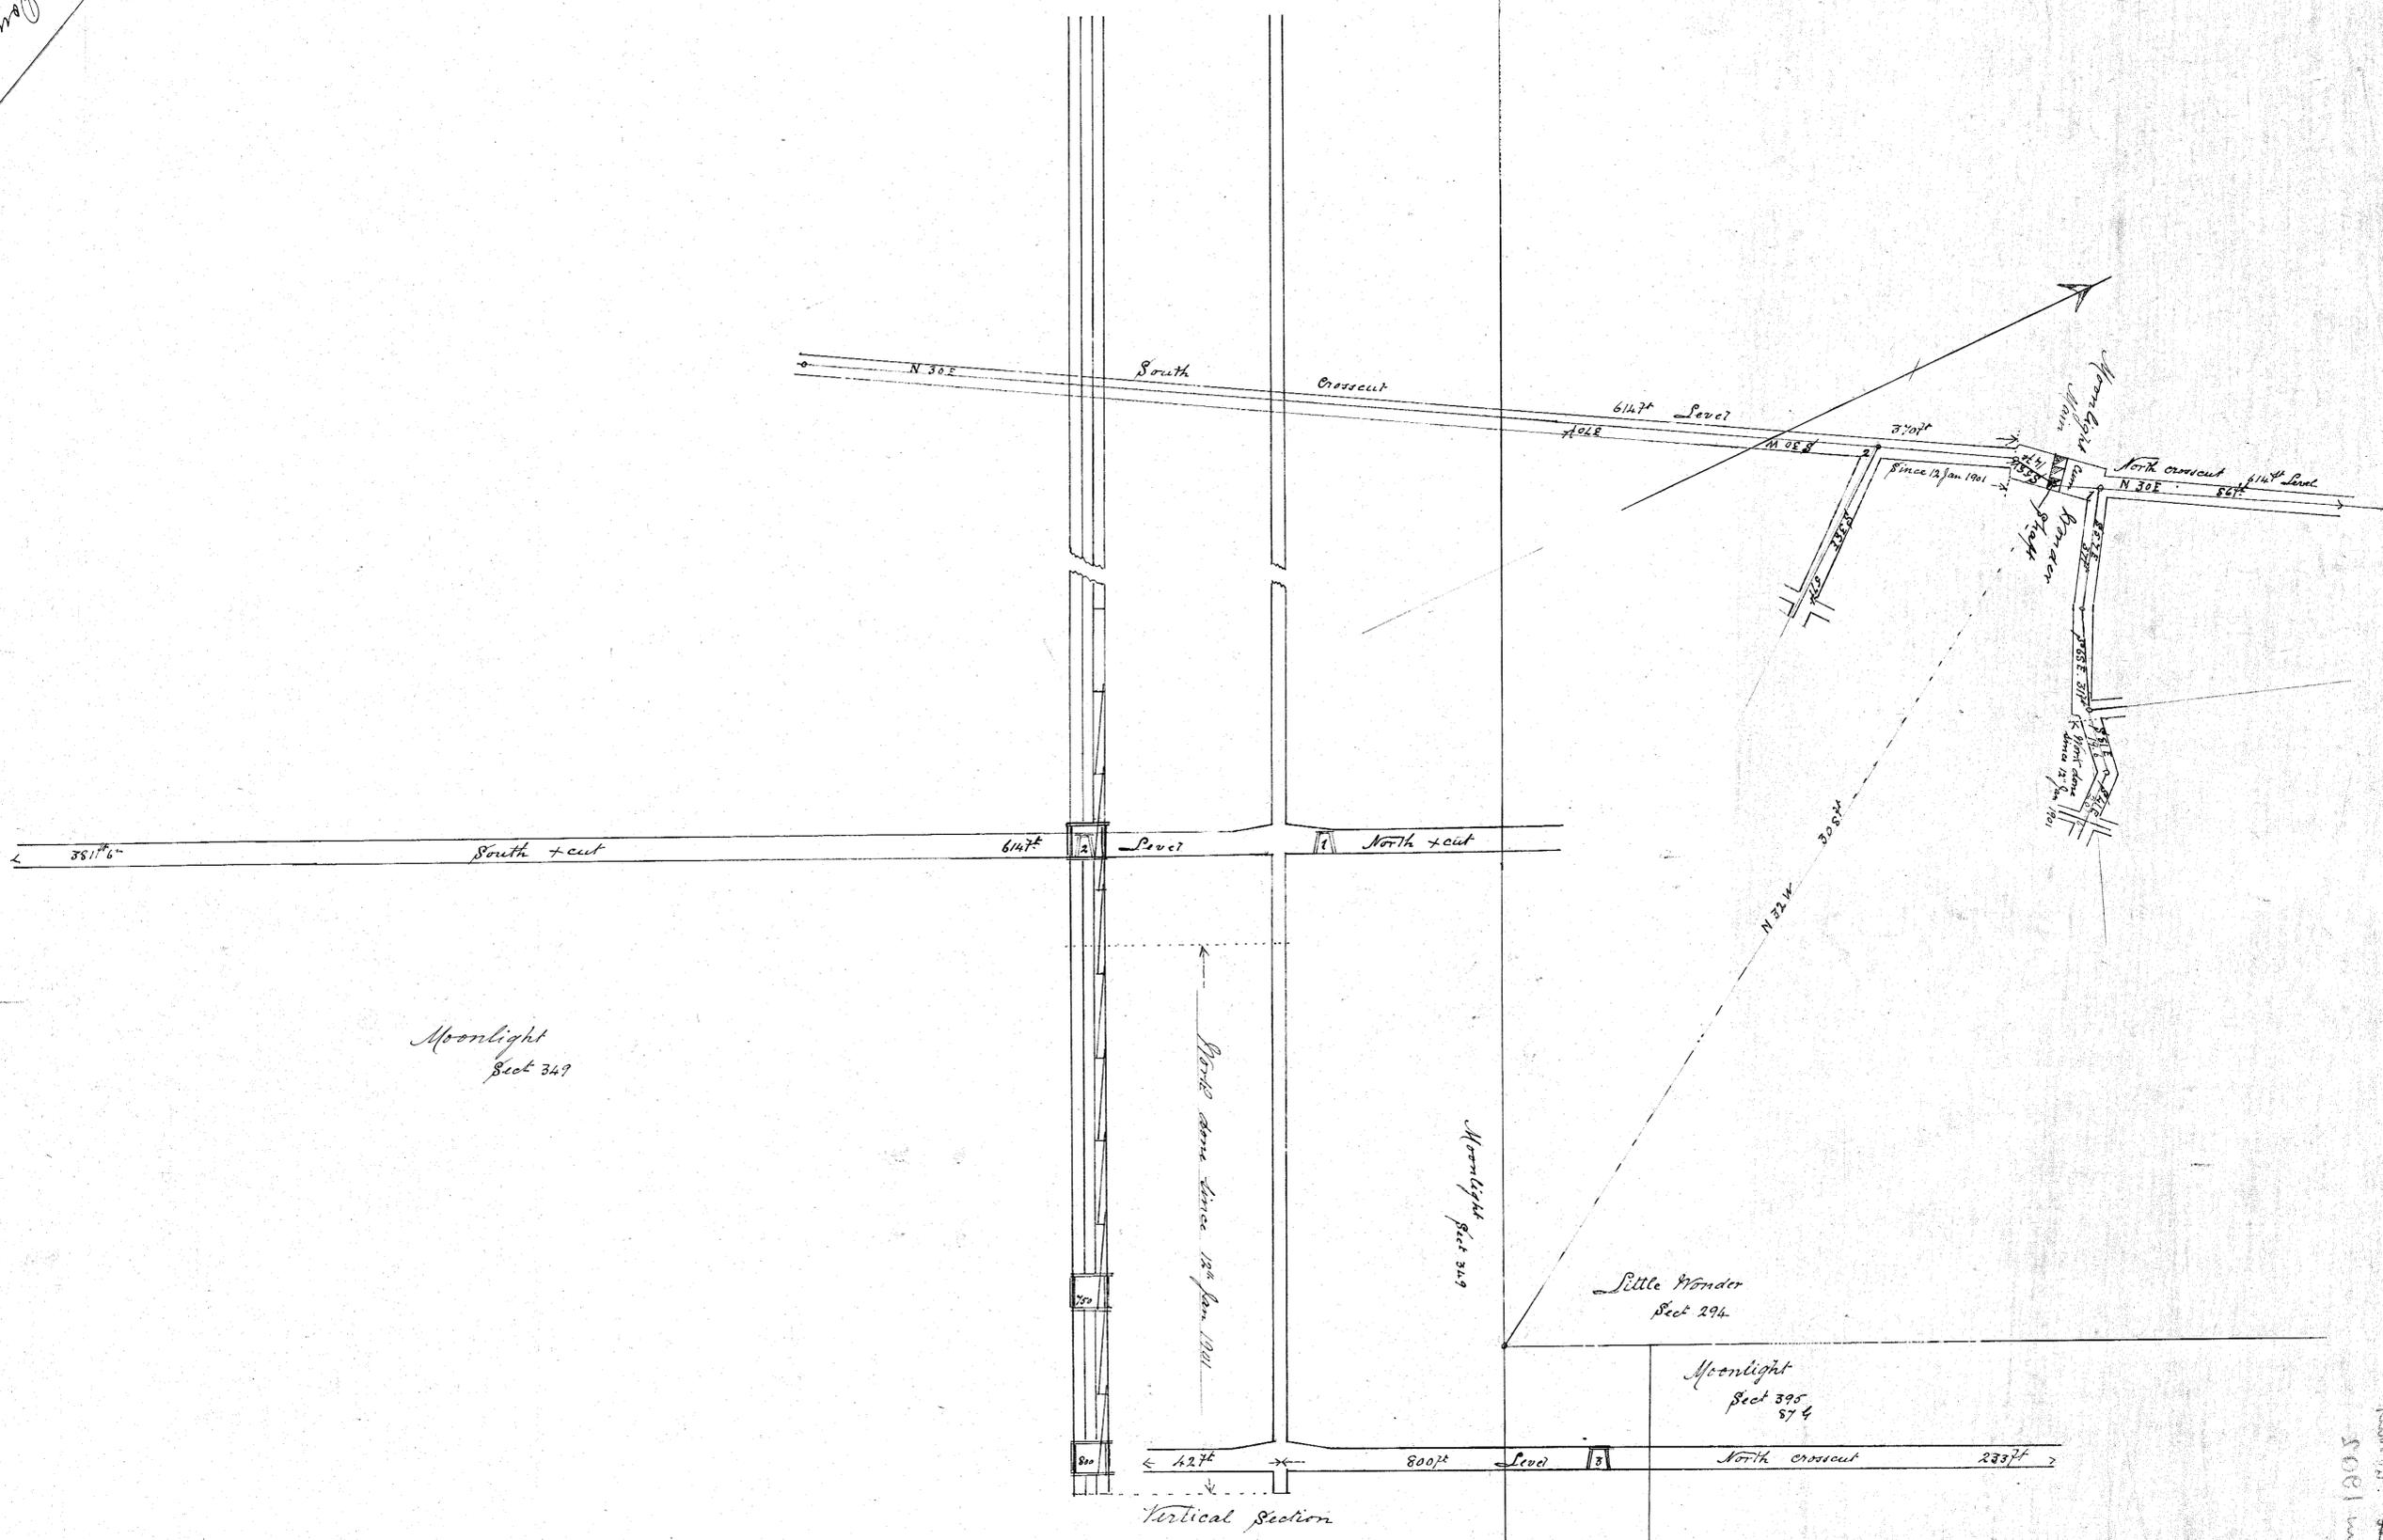

*Moonlight Sect 349*

*Moonlight Sect 349*

*Little Wonder Sect 294*

*Moonlight Sect 395*

*Vertical Section*

*Moonlight cum Wonder G. M. C.*  
*Scale 25' to 1"*

*L. H. H. H.*  
*Jan. 15 - 1902*



*Moonlight Shaft*

*18d Jan 1905*