



114-08

114-08

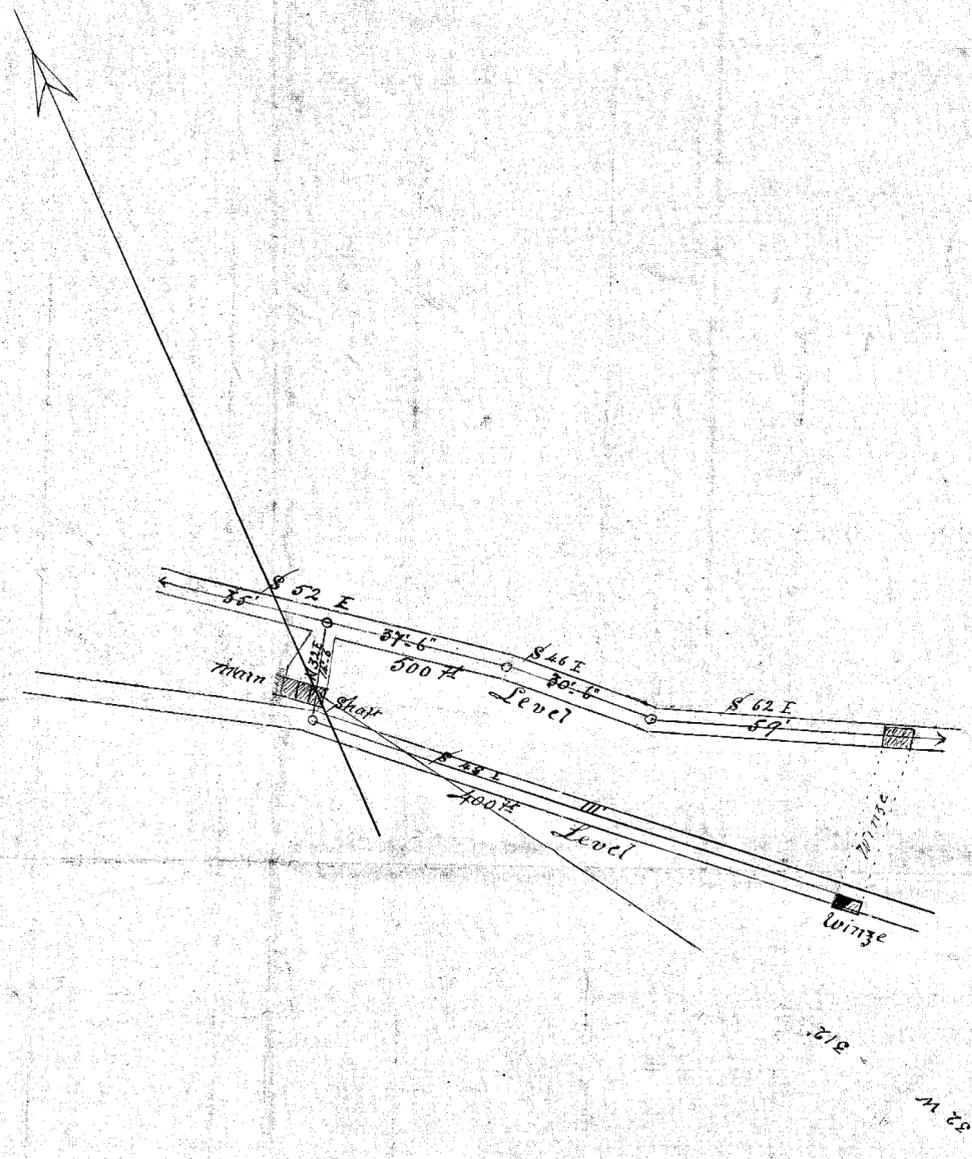

Moonlight cum Wonder L.M.C.
 Scale 25' to 1 inch
 L. Steerey Per. Dy.
 A. G. Jeff 1903

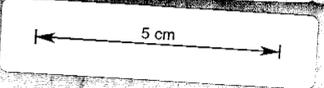

Moonlight cum Wonder L.M.C.