



TWILIGHT MINE

PLAN

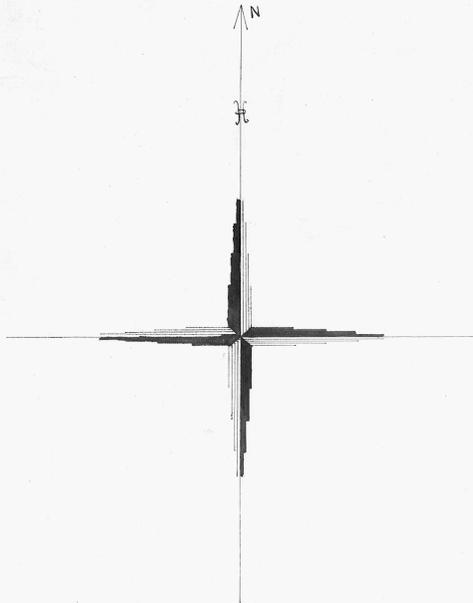

238
83G

237
83G

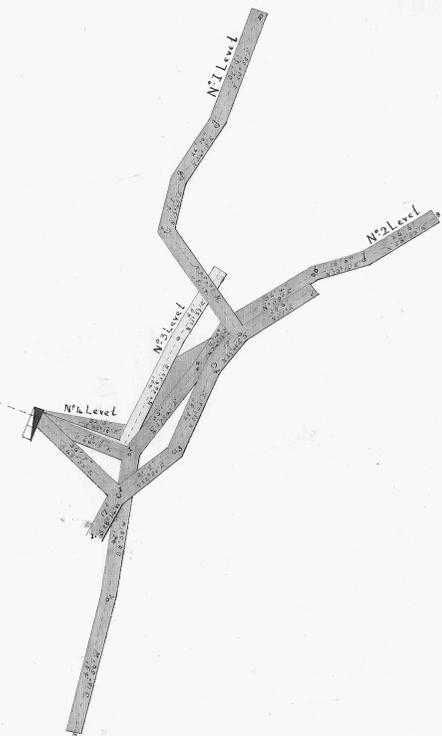

5 cm

115-01



SCALE 2.5 FEET = 1 INCH

Surveyed and drawn by
A. Dickinson A.R.S.M. and G.R. Jones
Instrument used Theodolite