


115-02

# CROSS SECTION

WEST

EAST

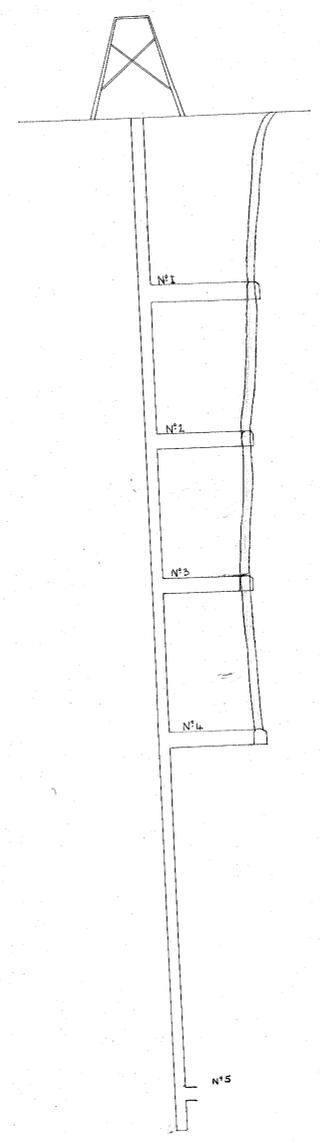


115-02

# LONGITUDINAL SECTION

SOUTH

NORTH

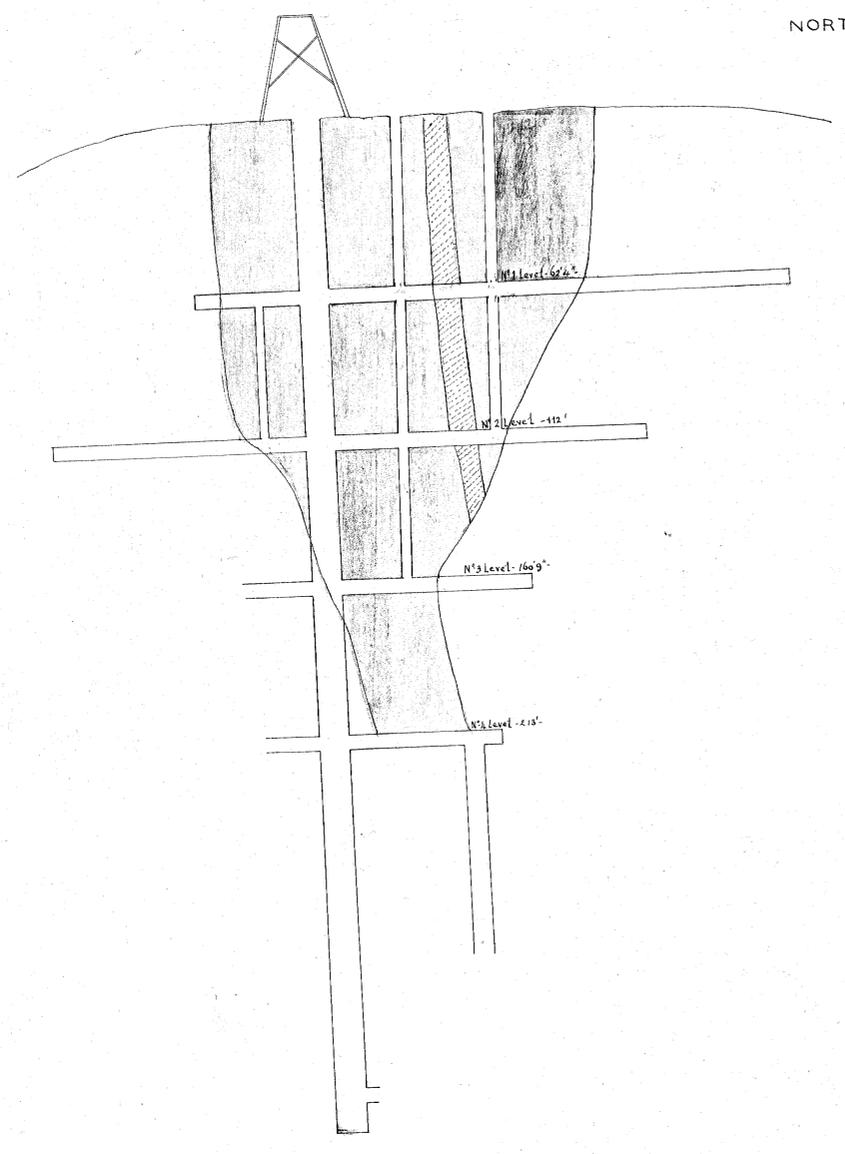

2/4/72

123  
1000  
AMERICAN