



115-03

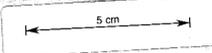


*Rec'd 28/1/1900*

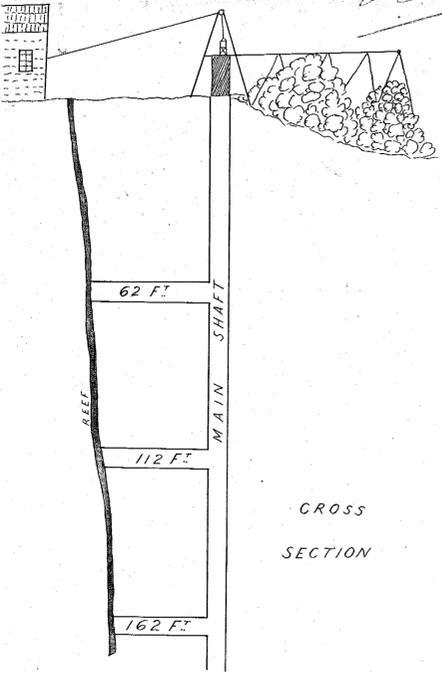

CROSS SECTION

# TWILIGHT G.M.

Scale 25 Feet to an Inch.

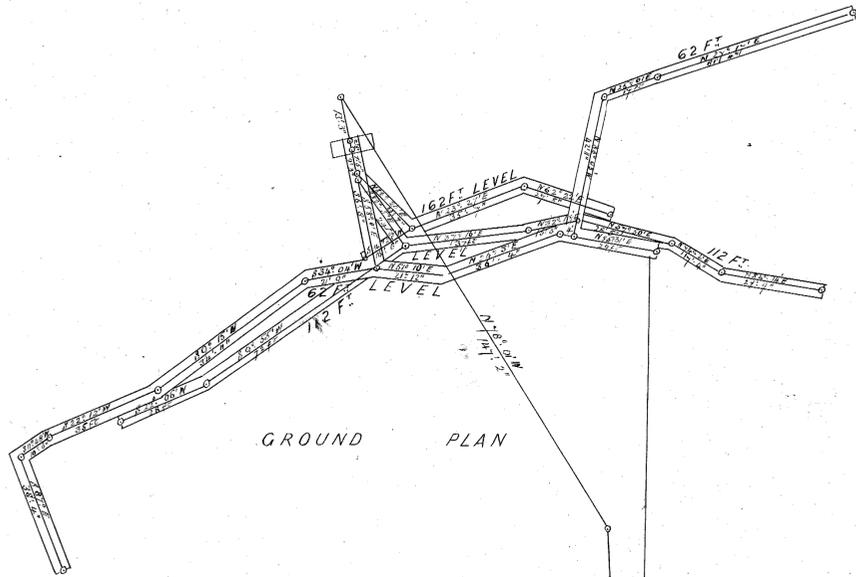


GROUND PLAN

Section No.  $\frac{238}{88}$   
 $\frac{237}{88}$  *all*

$\frac{238}{88}$  *all*

## LONGITUDINAL SECTION

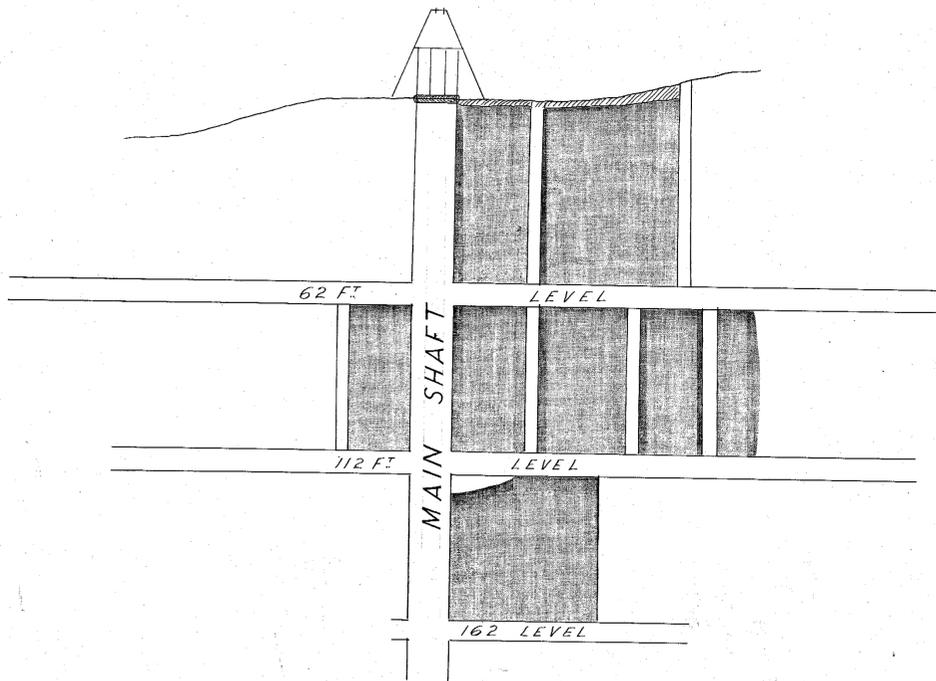

*Certified correct copy of  
Plan in manager's office  
of work done up to end of year  
1889  
C. B. Watson*