


115-06



TWILIGHT MINE

PLAN

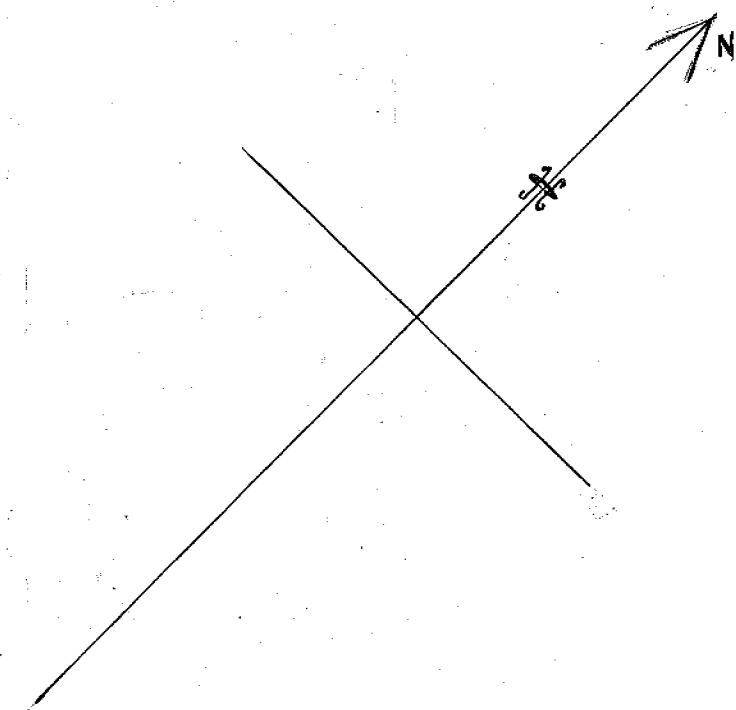

237
83G


238
83G

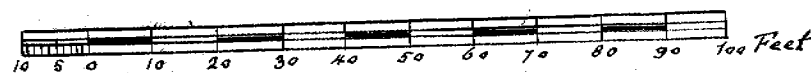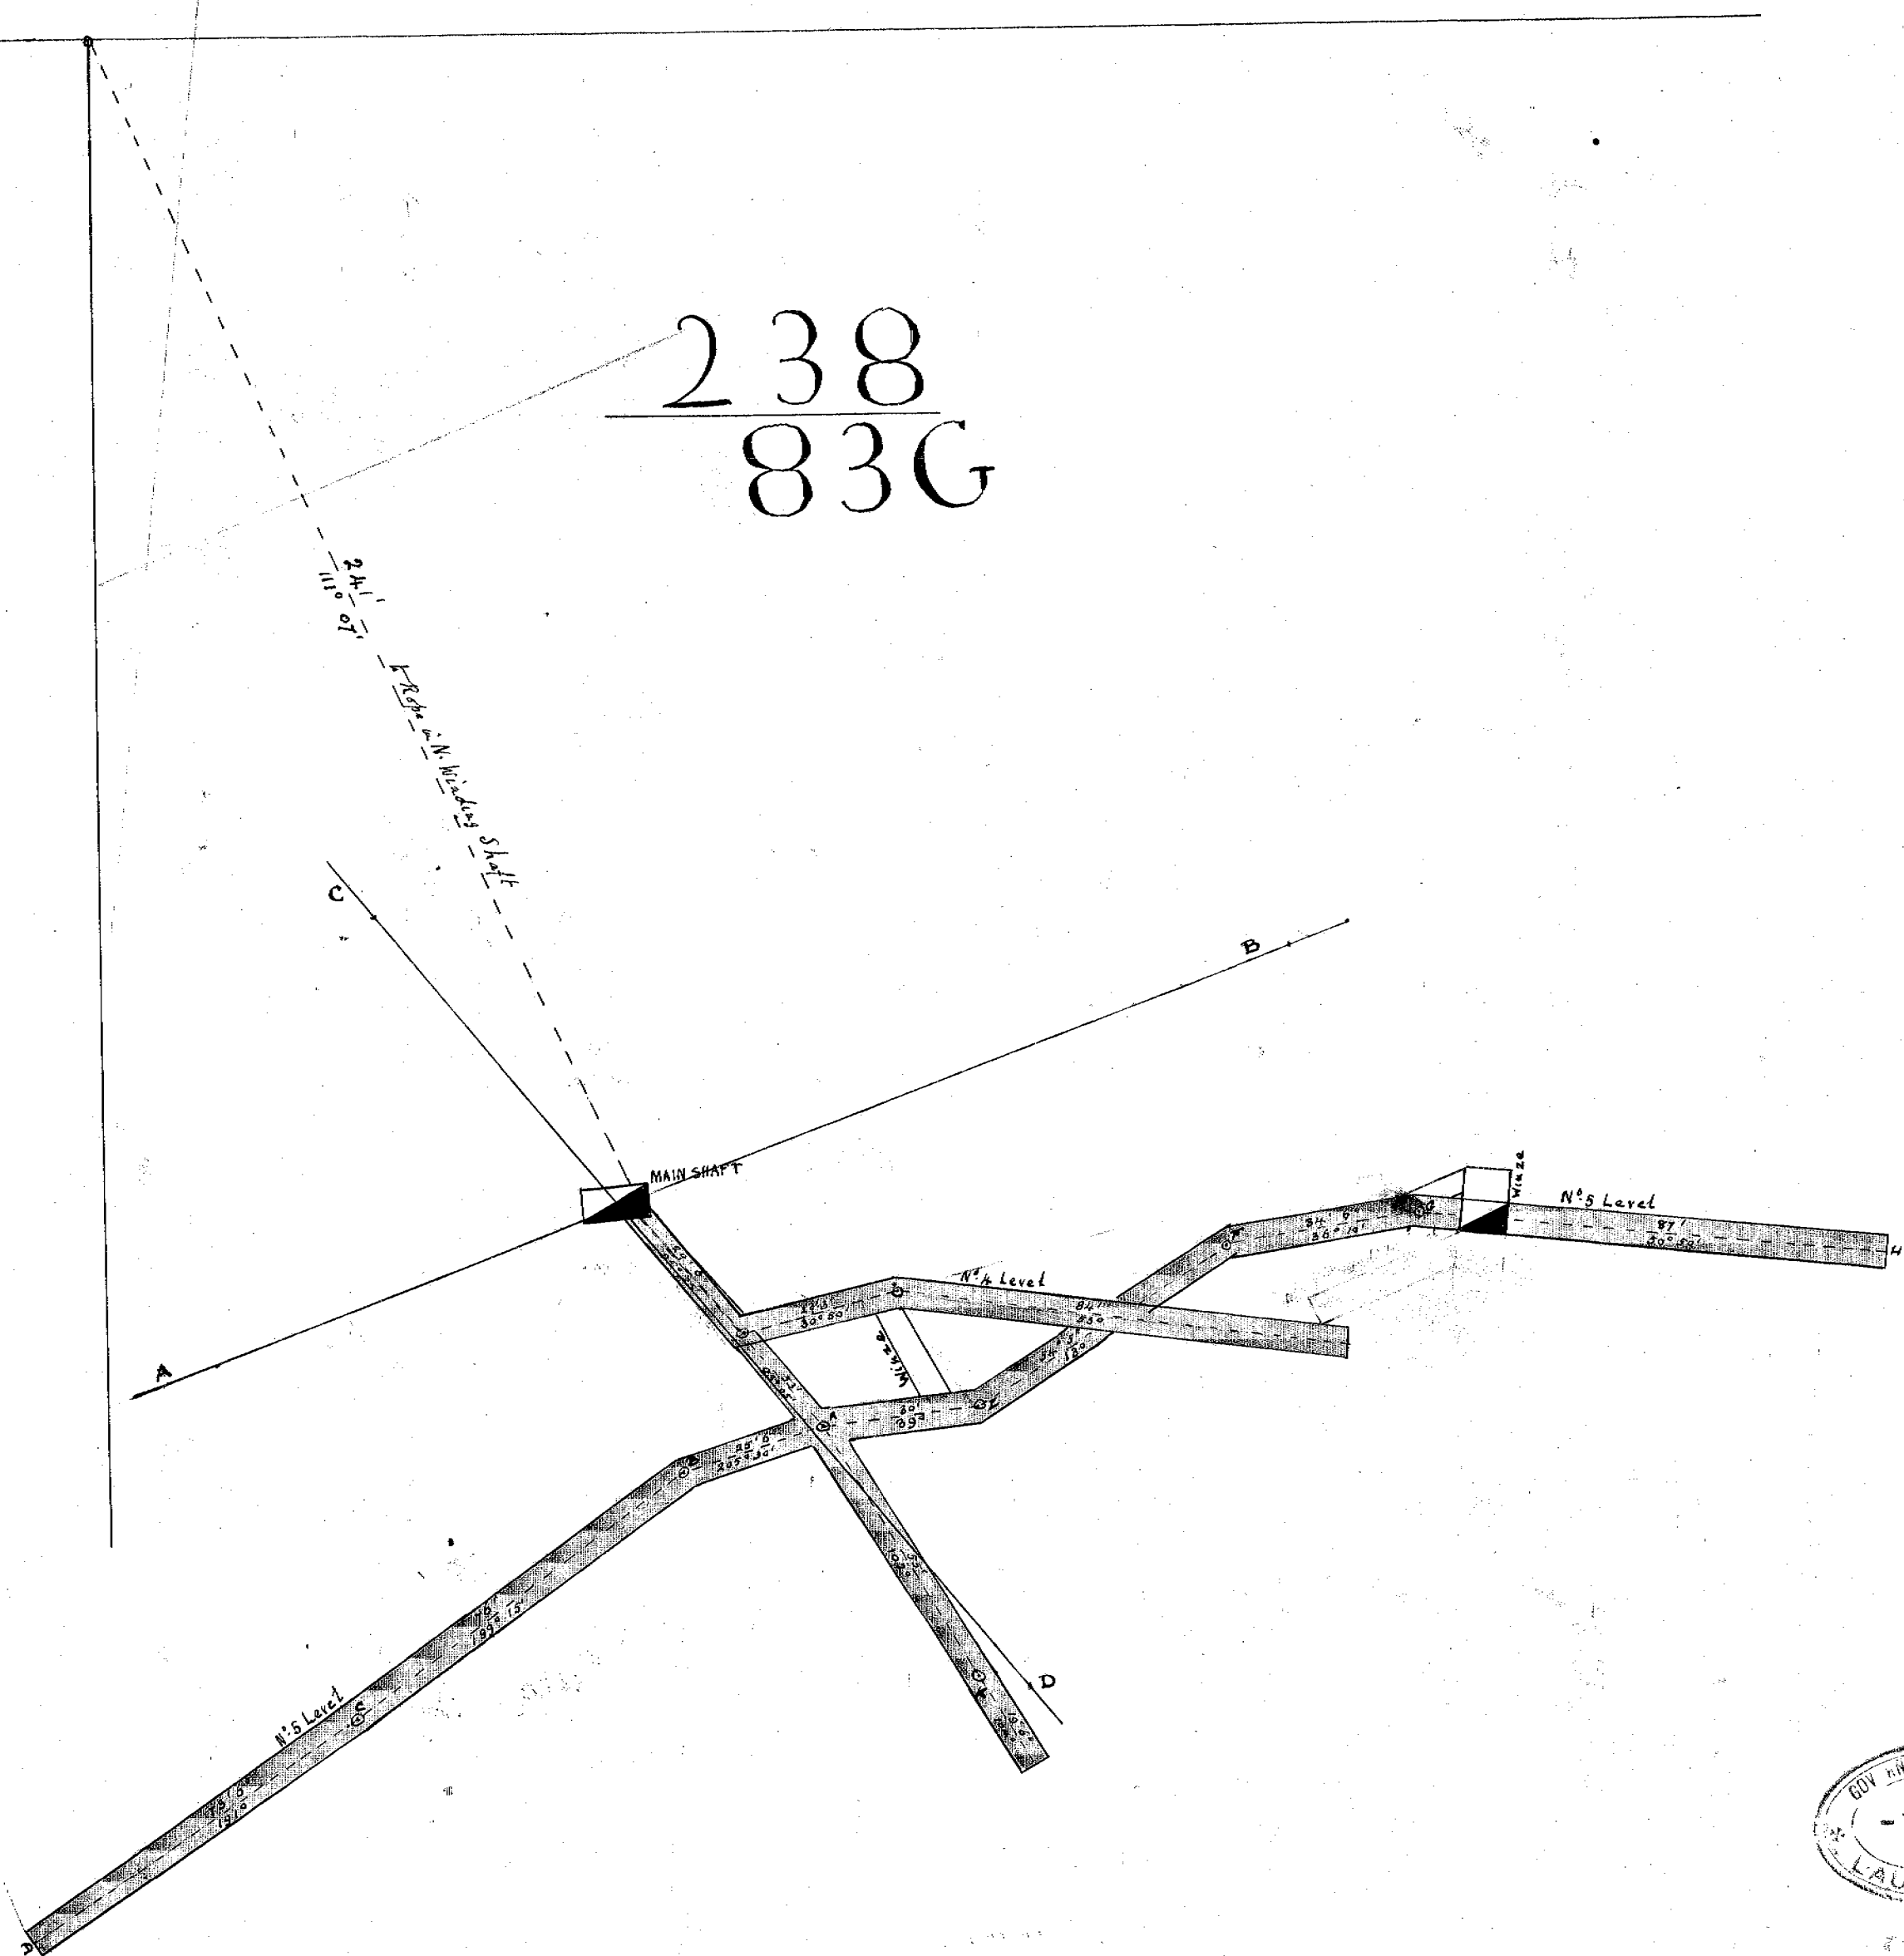

30' to 1"

Surveyed and drawn by Arthur Dickinson ARSM & G.R. Jones

Instrument used Theodolite.

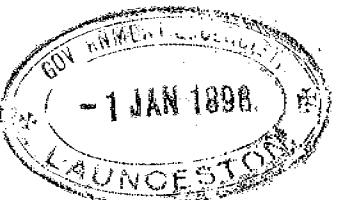

115-06