



SKETCH PLAN of bottom of Winze

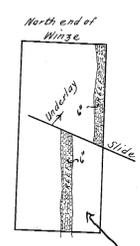


CROSS SECTION Showing end of Winze looking South.


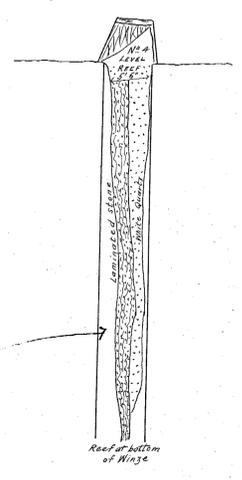


These sketch sections are copies of drawings by Mr. S. Richards accompanying his report on the mine, supplied by Mr. H. J. Wise manager of the Company. 4/20/1905

TWILIGHT

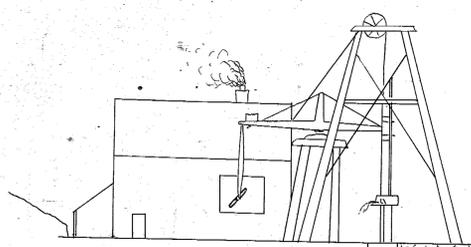

SKETCH SECTION Showing pitch of gold shoot looking East.

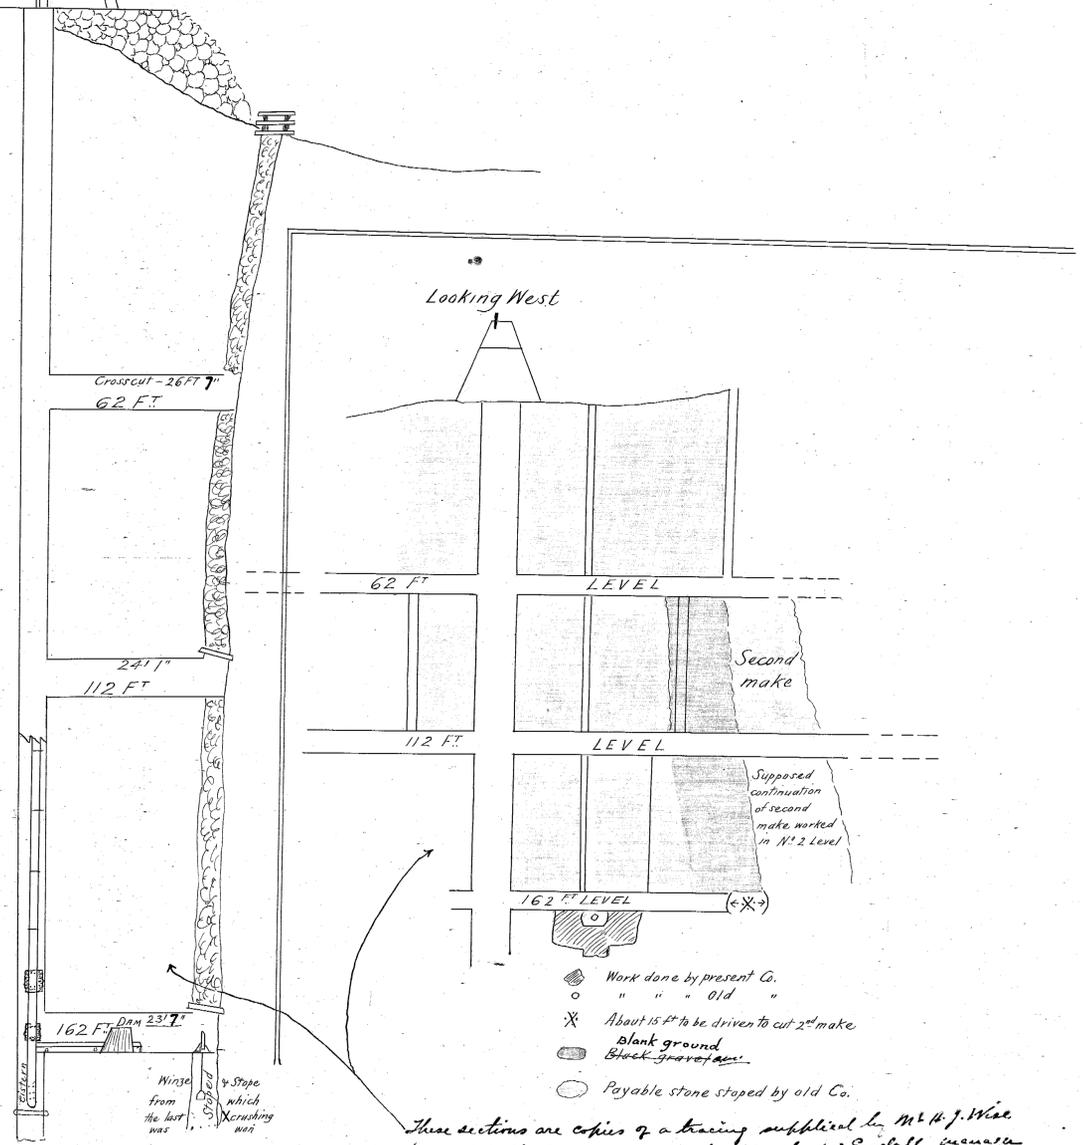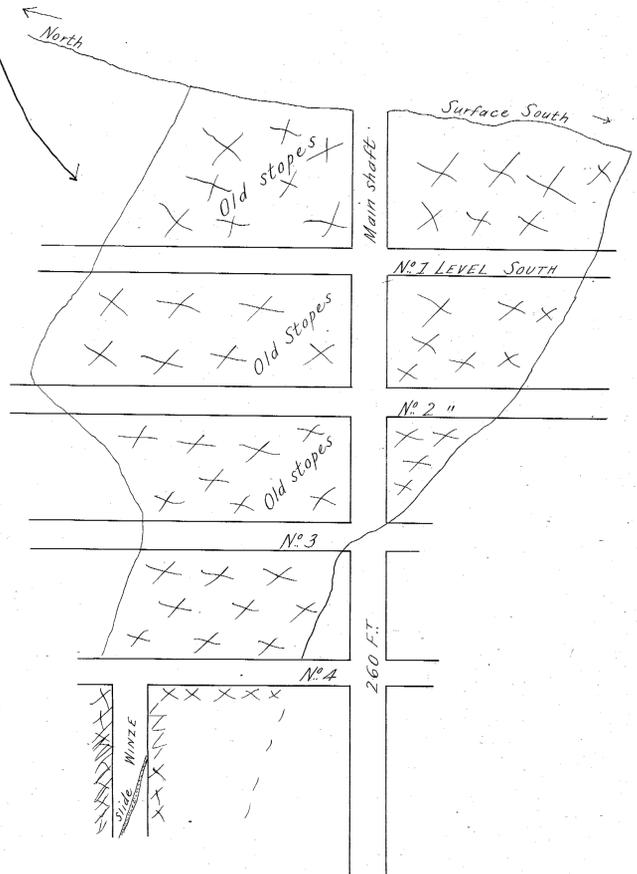

- Work done by present Co.
- " " " Old "
- X About 15 ft to be driven to cut 2nd make
- Blank ground
- Black ground
- Payable stone stoped by old Co.

These sections are copies of a tracing supplied by Mr. H. J. Wise manager of the Company given to him by Mr. Randall manager of the mine. 4/20/1905

X The spot marked thus is where the hole in the tunnel stone had not yet been through the stone which proved to be 5 ft.

Scale 12 feet to 1 inch.

1883