
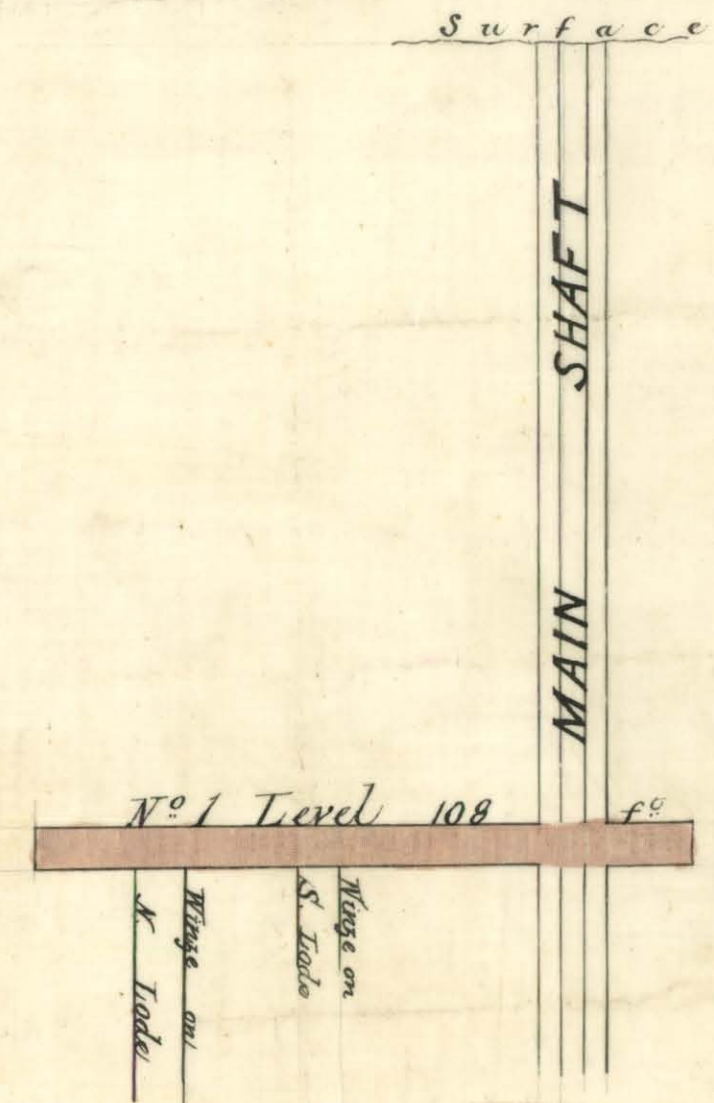


REWARD. C. M. CO. NO. 11A

Cross Section

Longitudinal Section

Scale 25 feet to an inch

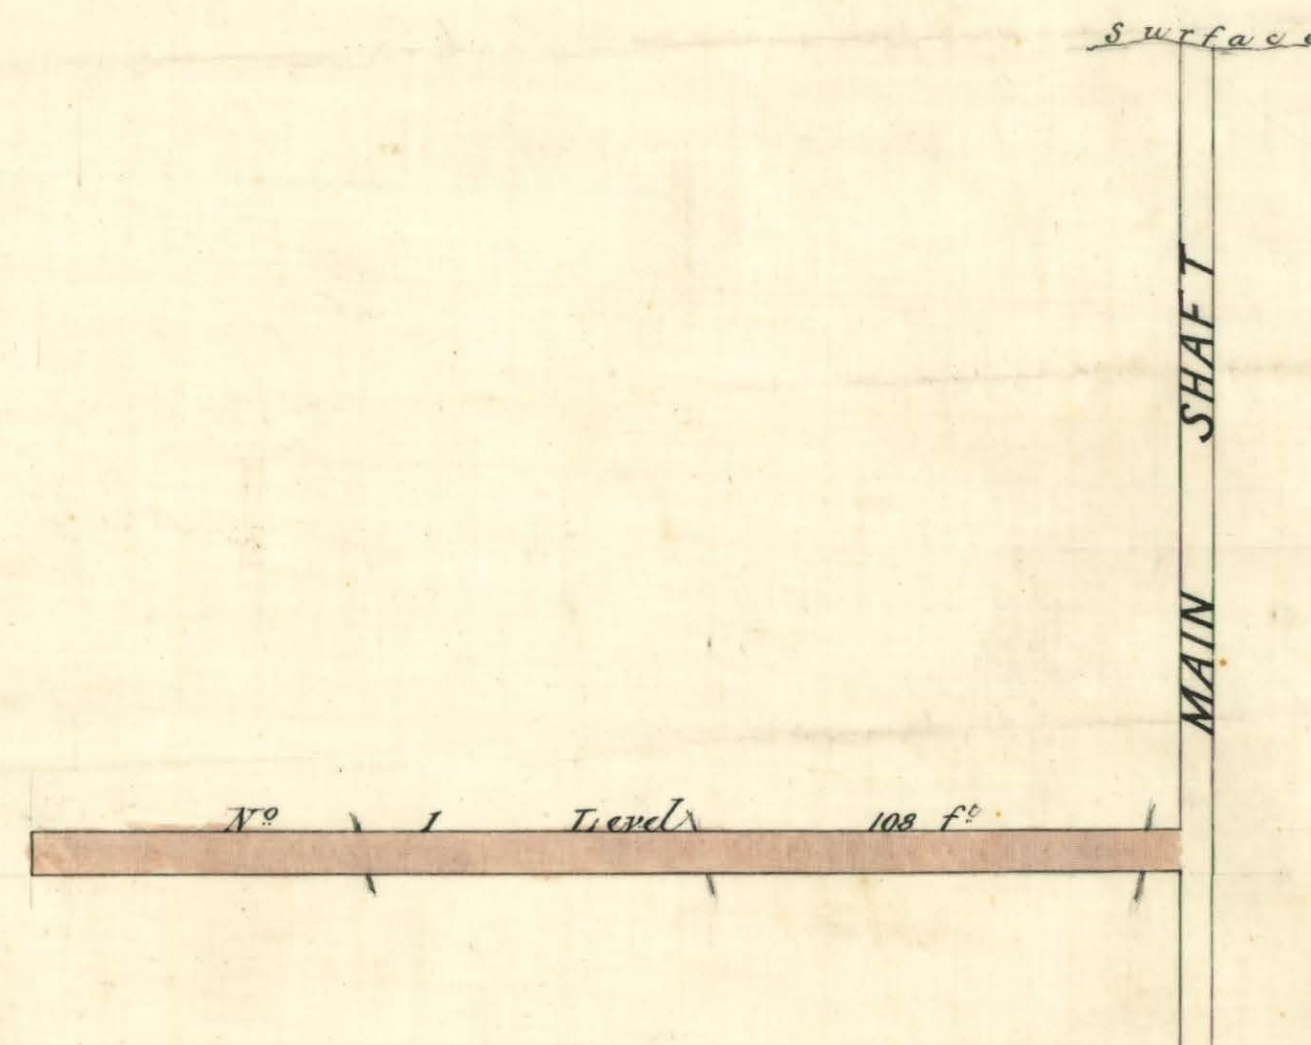

H. J. Miles.
Surveyor
Apr '96

H. J. Miles.
Surveyor
Apr '96

2001. 1111. 1896