


117-01
117-01

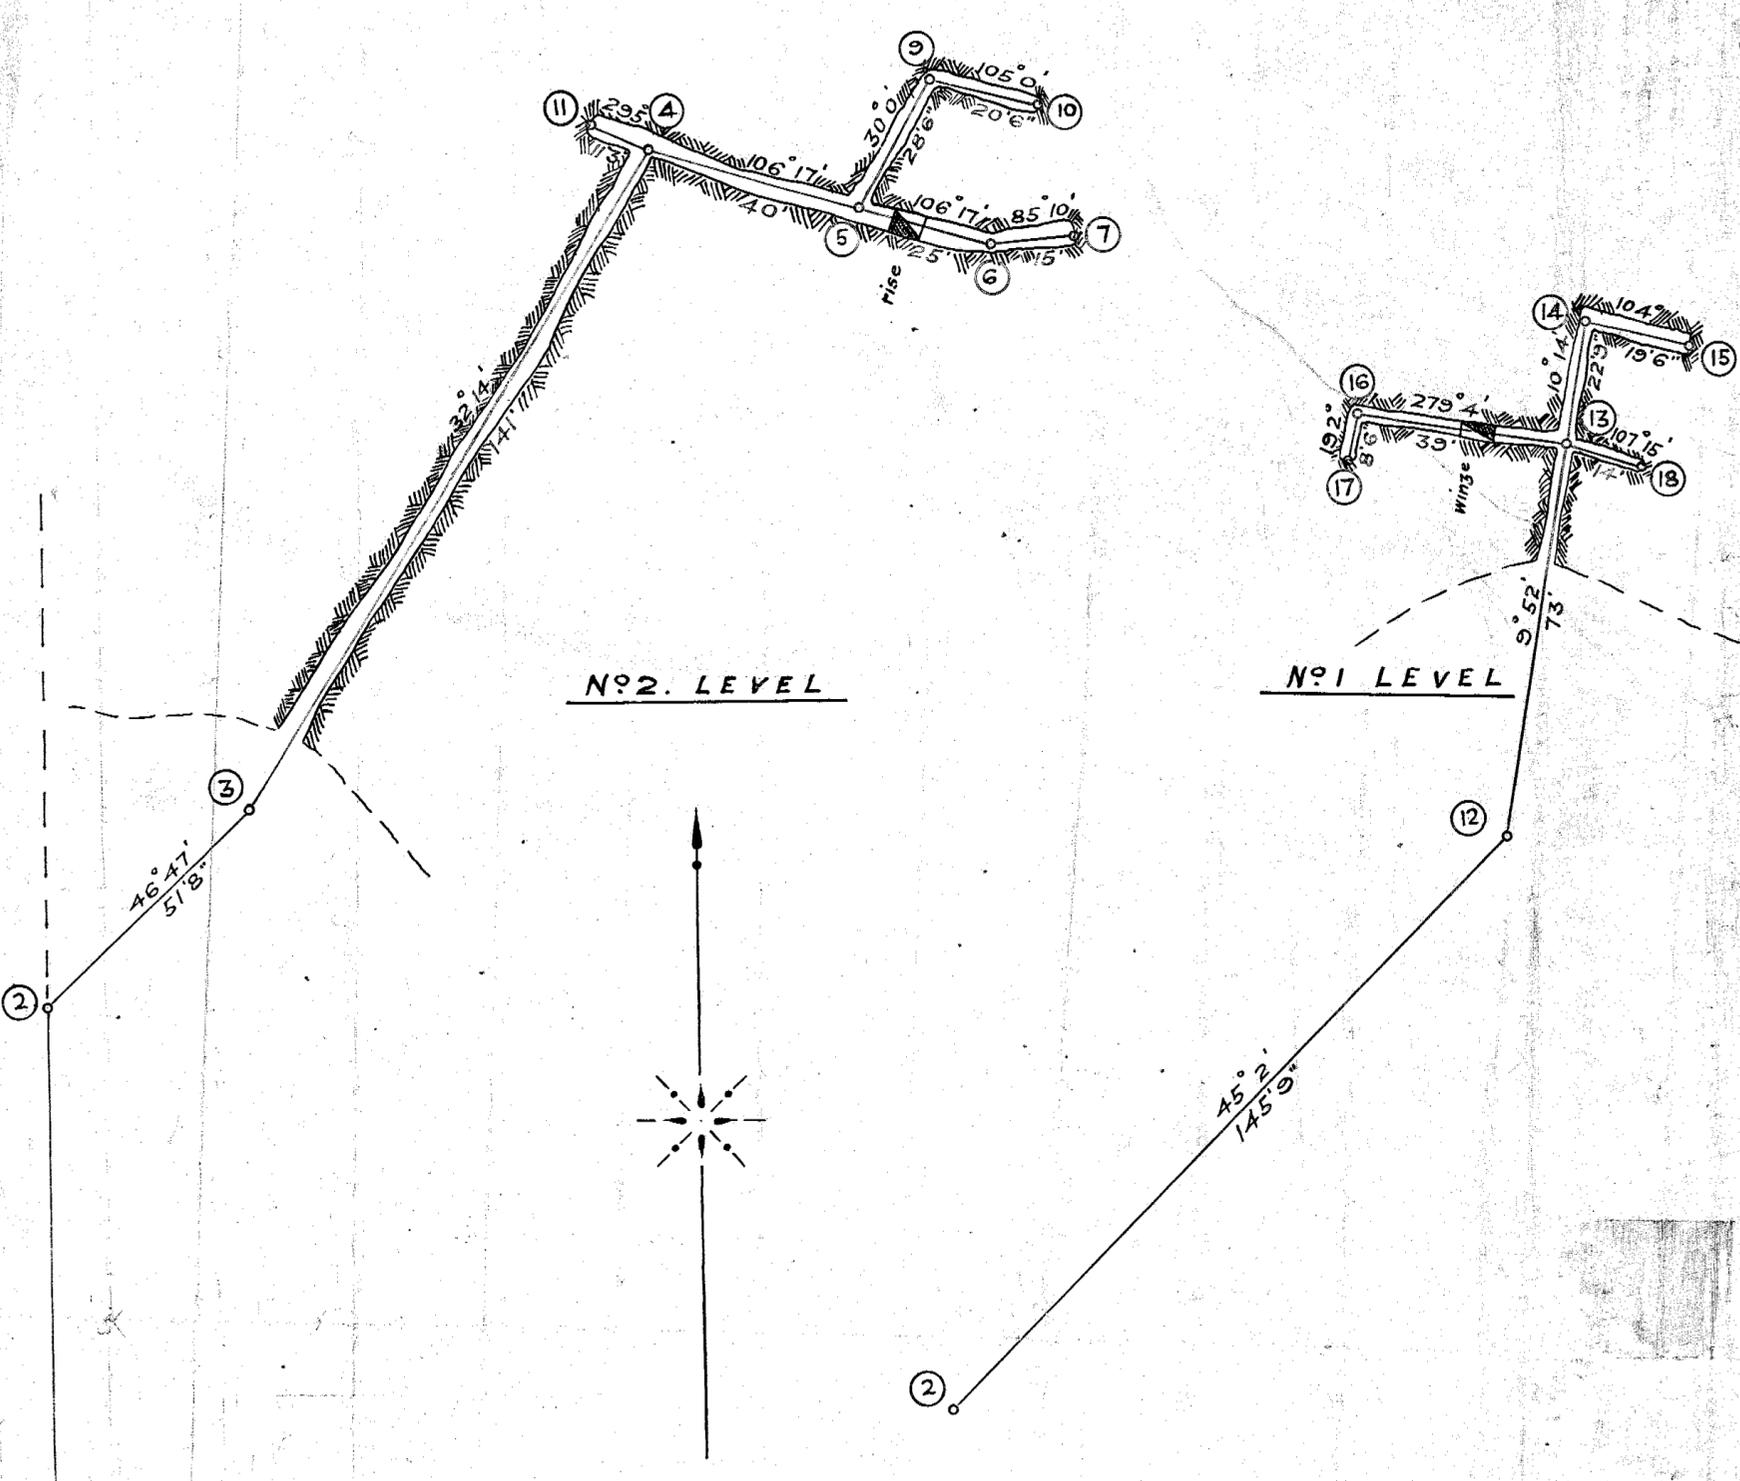

Plan of
May Gold Mining Co No Lia.
Scale 1 inch = 25 feet
18. II. 05

May Gold Mining Co
No Lia.

10 ac. $\frac{440}{G}$

S.W. corner



Godfrey Clump