


118-01


118-01

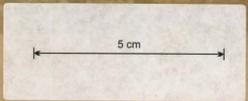


HIT OR MISS G. M. C^o

LEFROY

Scale 25 feet to an inch

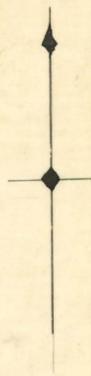

G.M.C. - 118-01

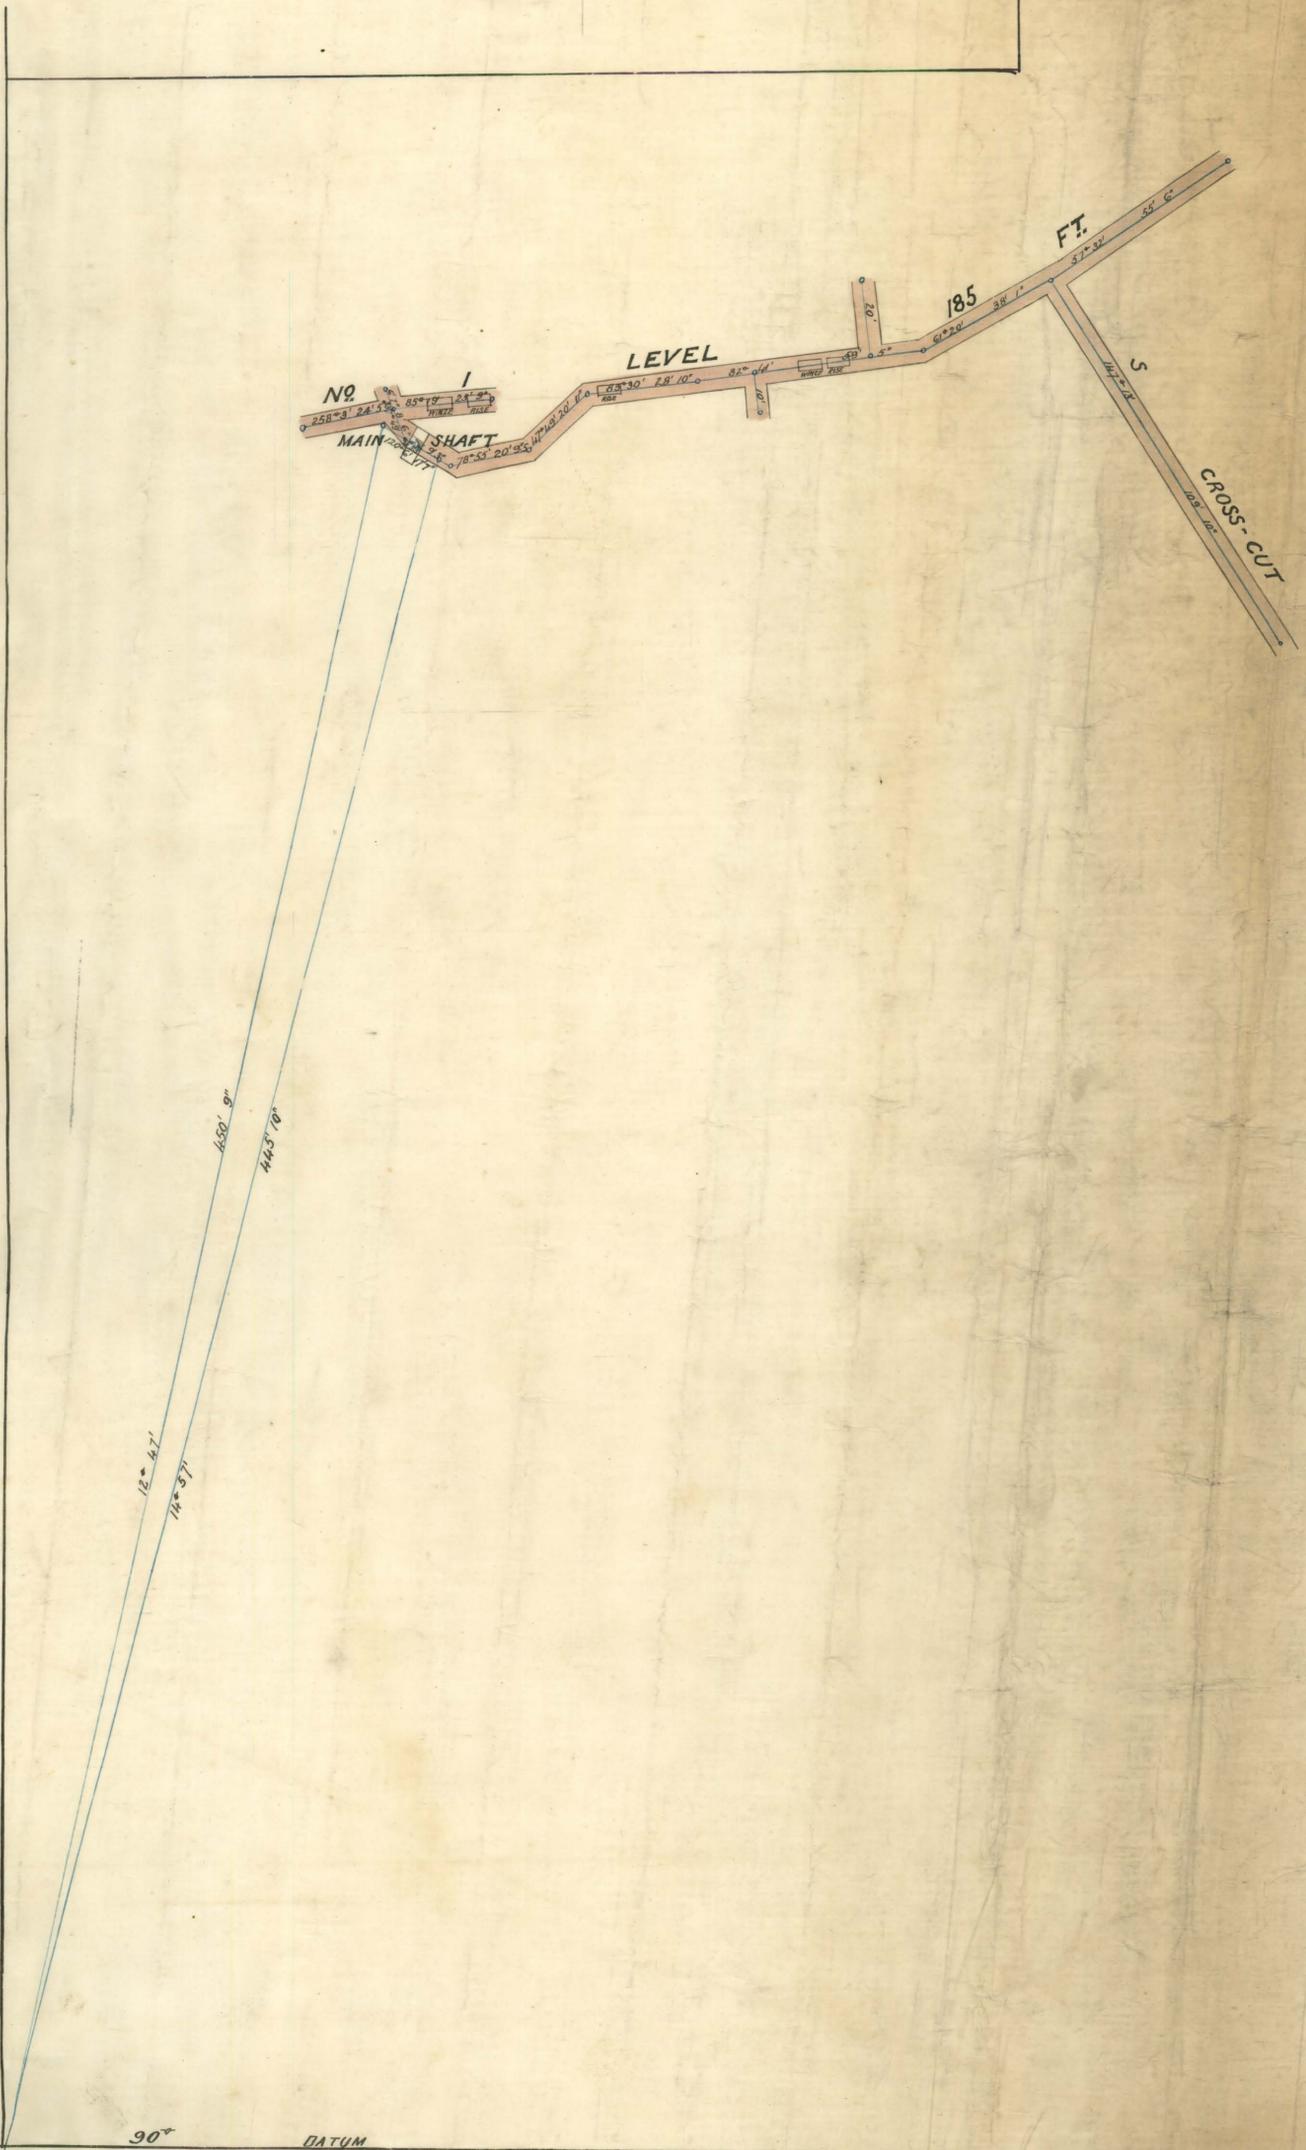

A. P. Miles
Surveyor
Lefroy
Mar '96.