


HIT OR MISS G. M. C.


LEFROY

Scale 25 feet to an inch

Cross Section

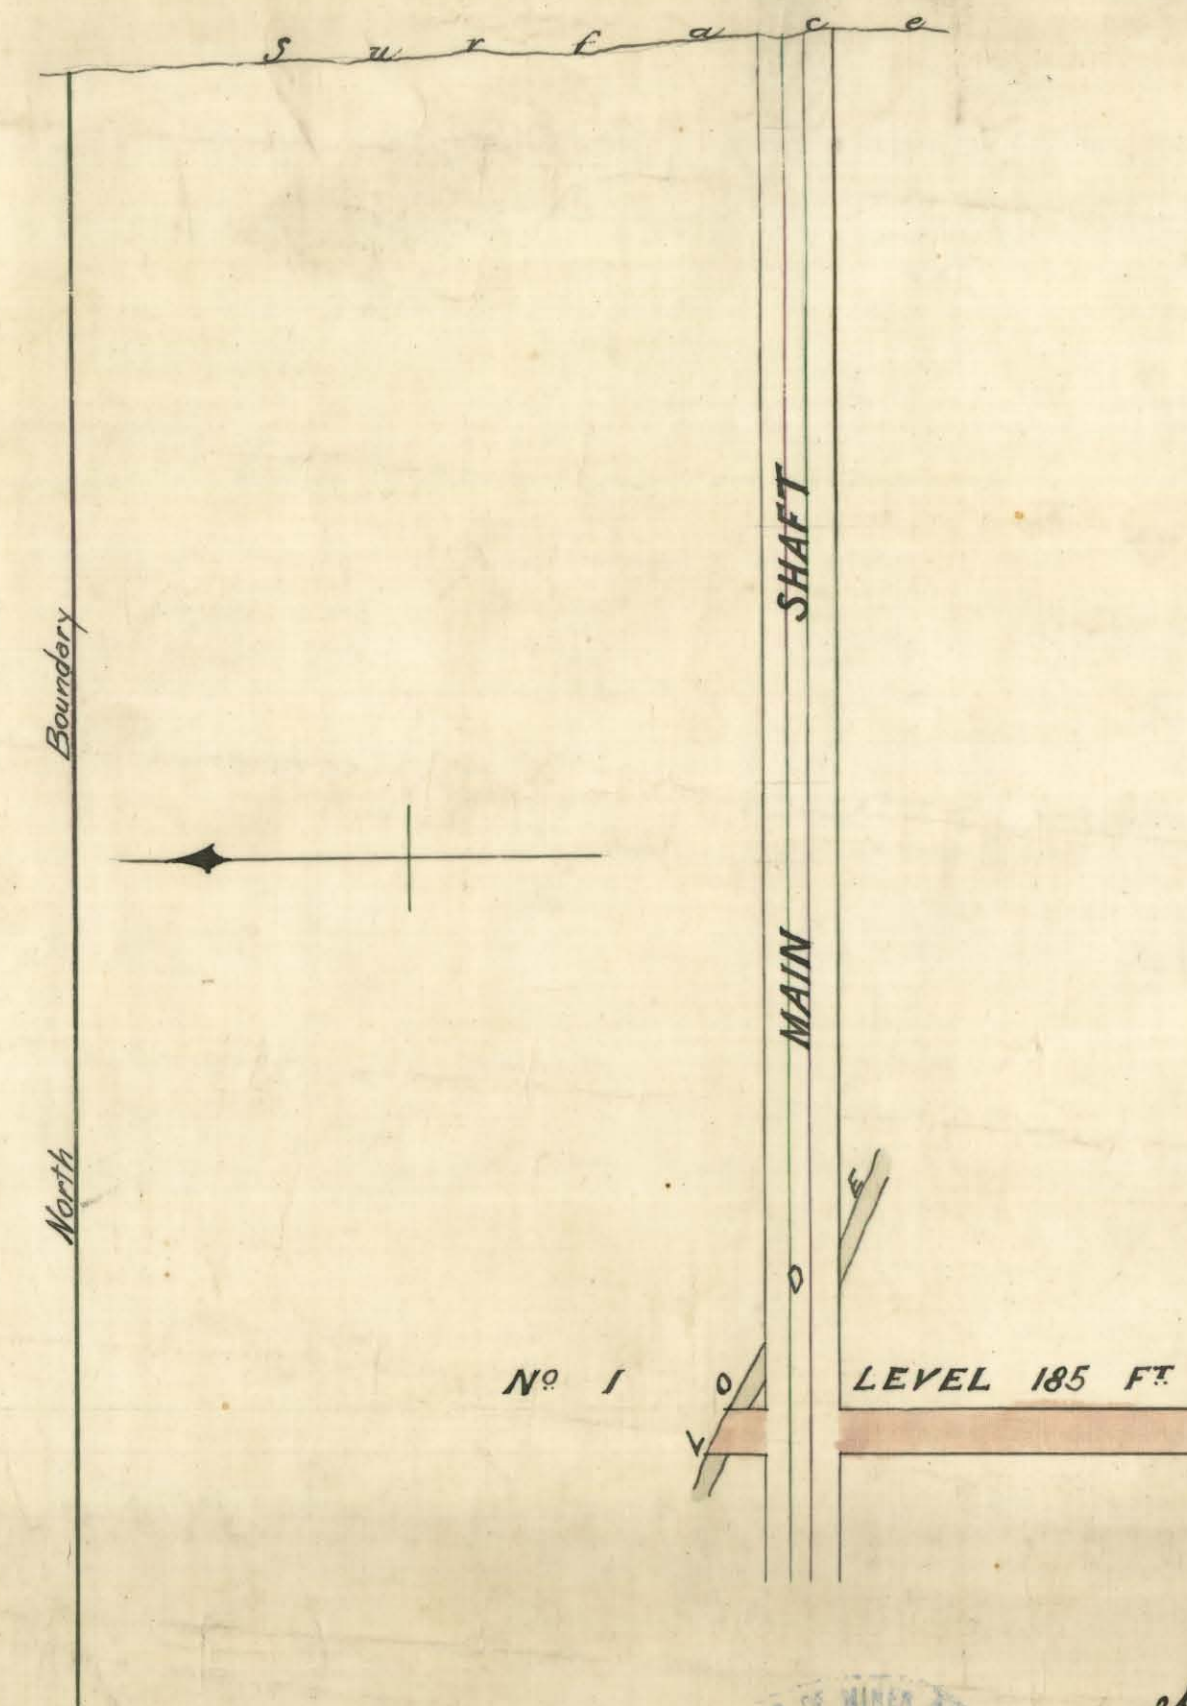

Longitudinal Section

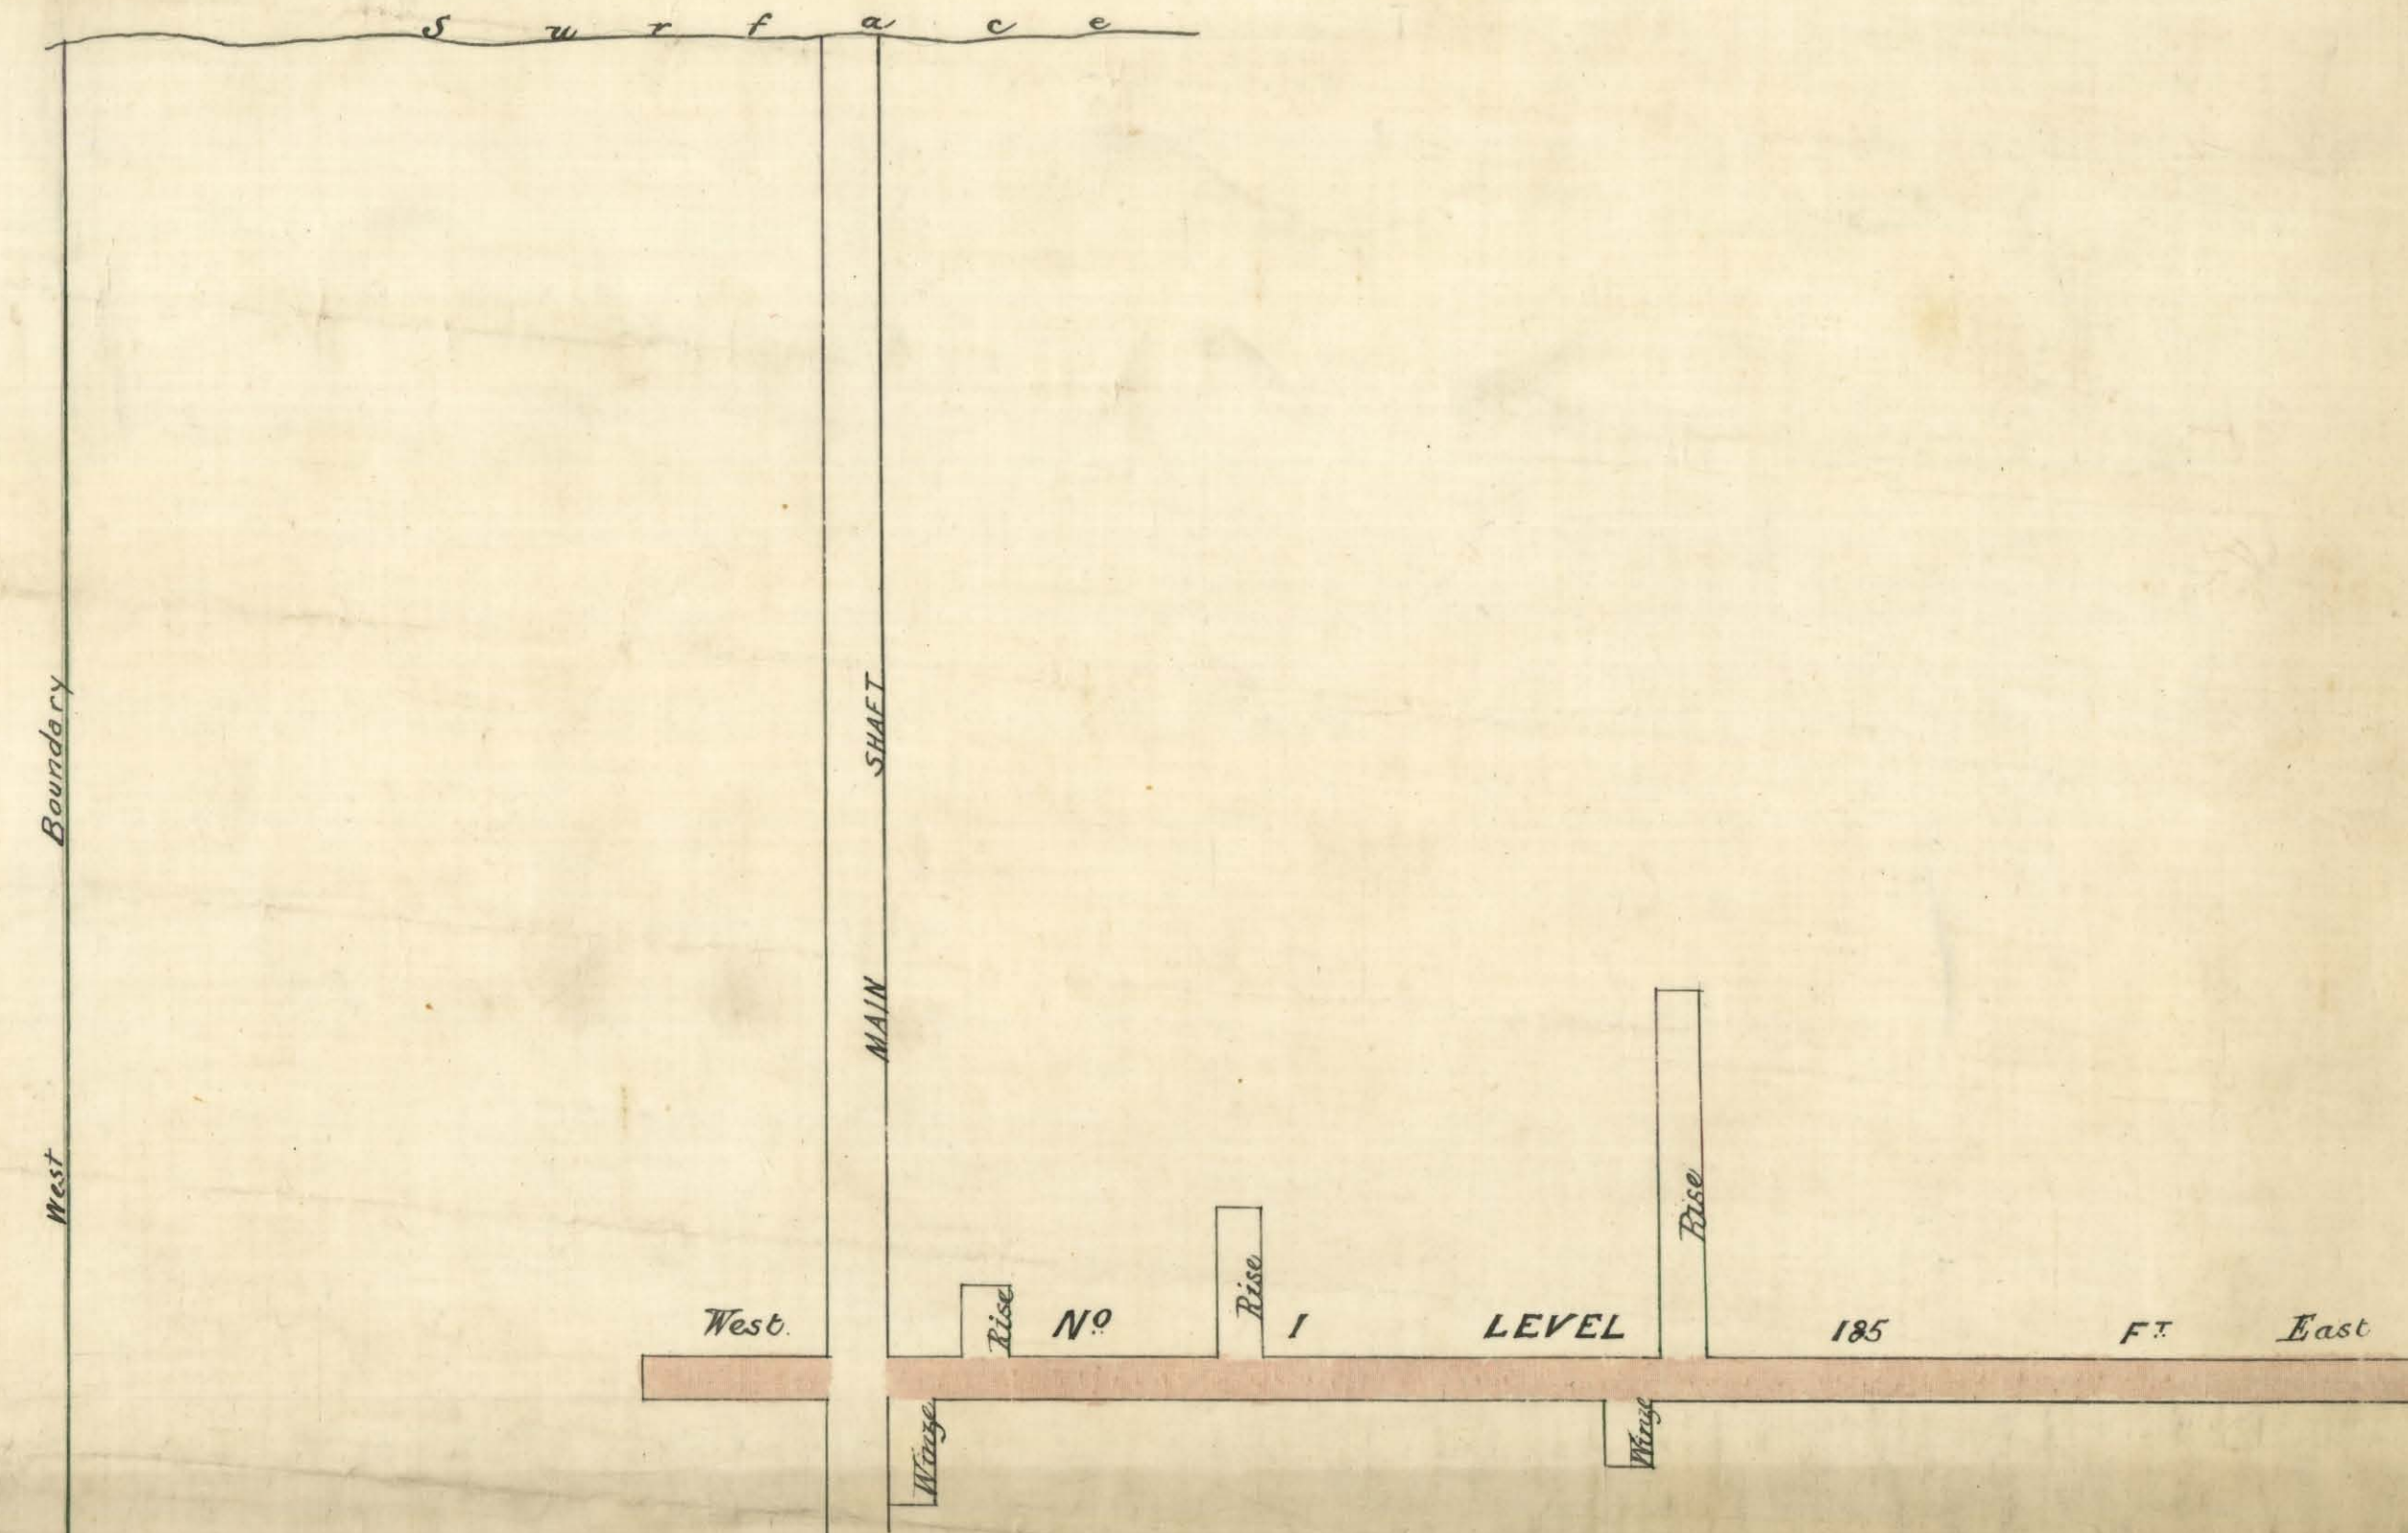

A. J. Miles
Surveyor
Leeroy.
March '96

A. J. Miles
Surveyor
Leeroy.
March '96

5 cm

118-02

118-02