


The
Golden Spur Gold Mines Limited
Mathinna
March 15, 1897.

119-01

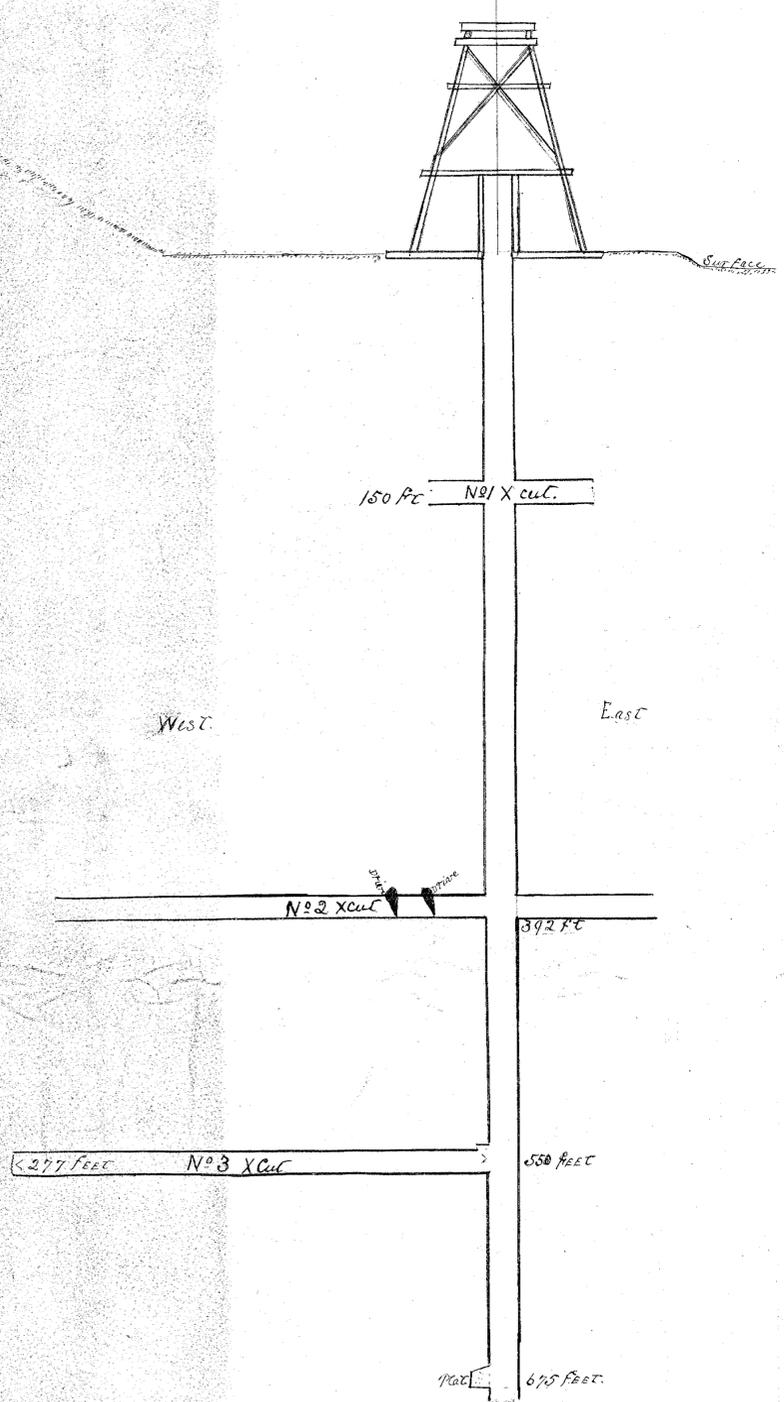


Transverse Section -
Looking North


119-01

50m


Plan
N°2 Level
50 FEET to an Inch.

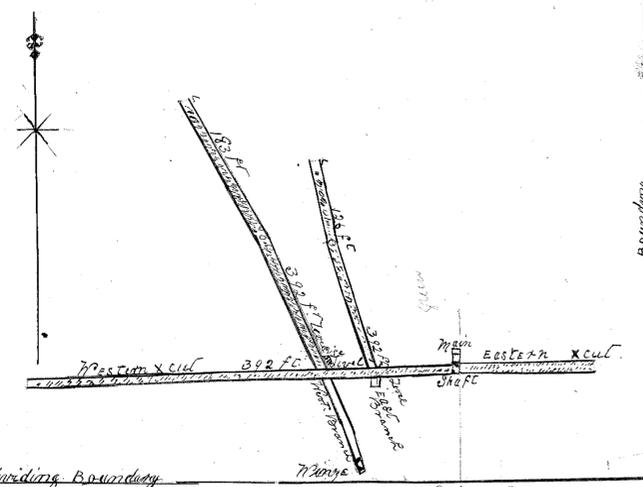

Dividing Boundary
The NEW Golden Gate C. M. Co.

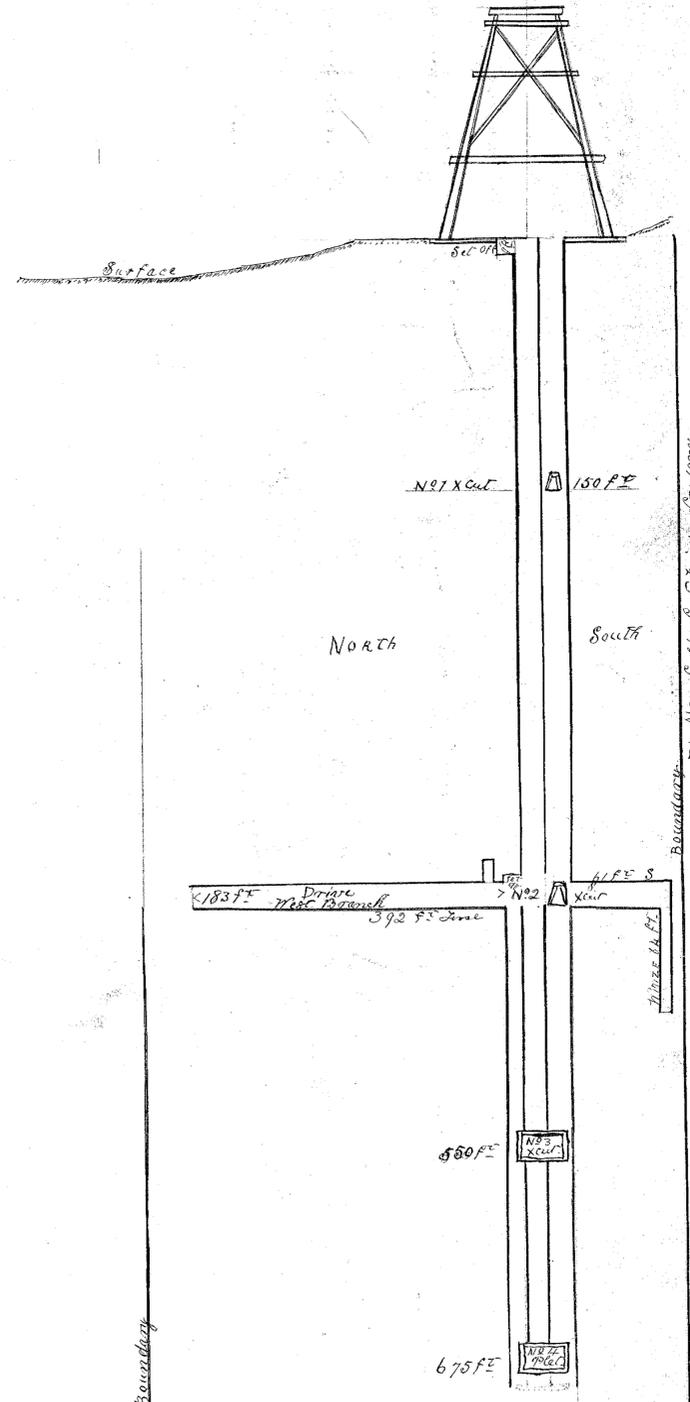

Longitudinal Section -
Looking East

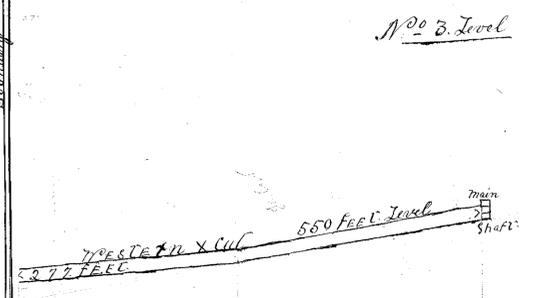

Dividing Boundary
The NEW Golden Gate C. M. Co.

The NEW Golden Gate Mining Company

119-01