



Section Showing Workings
Scale 25 feet to One Inch

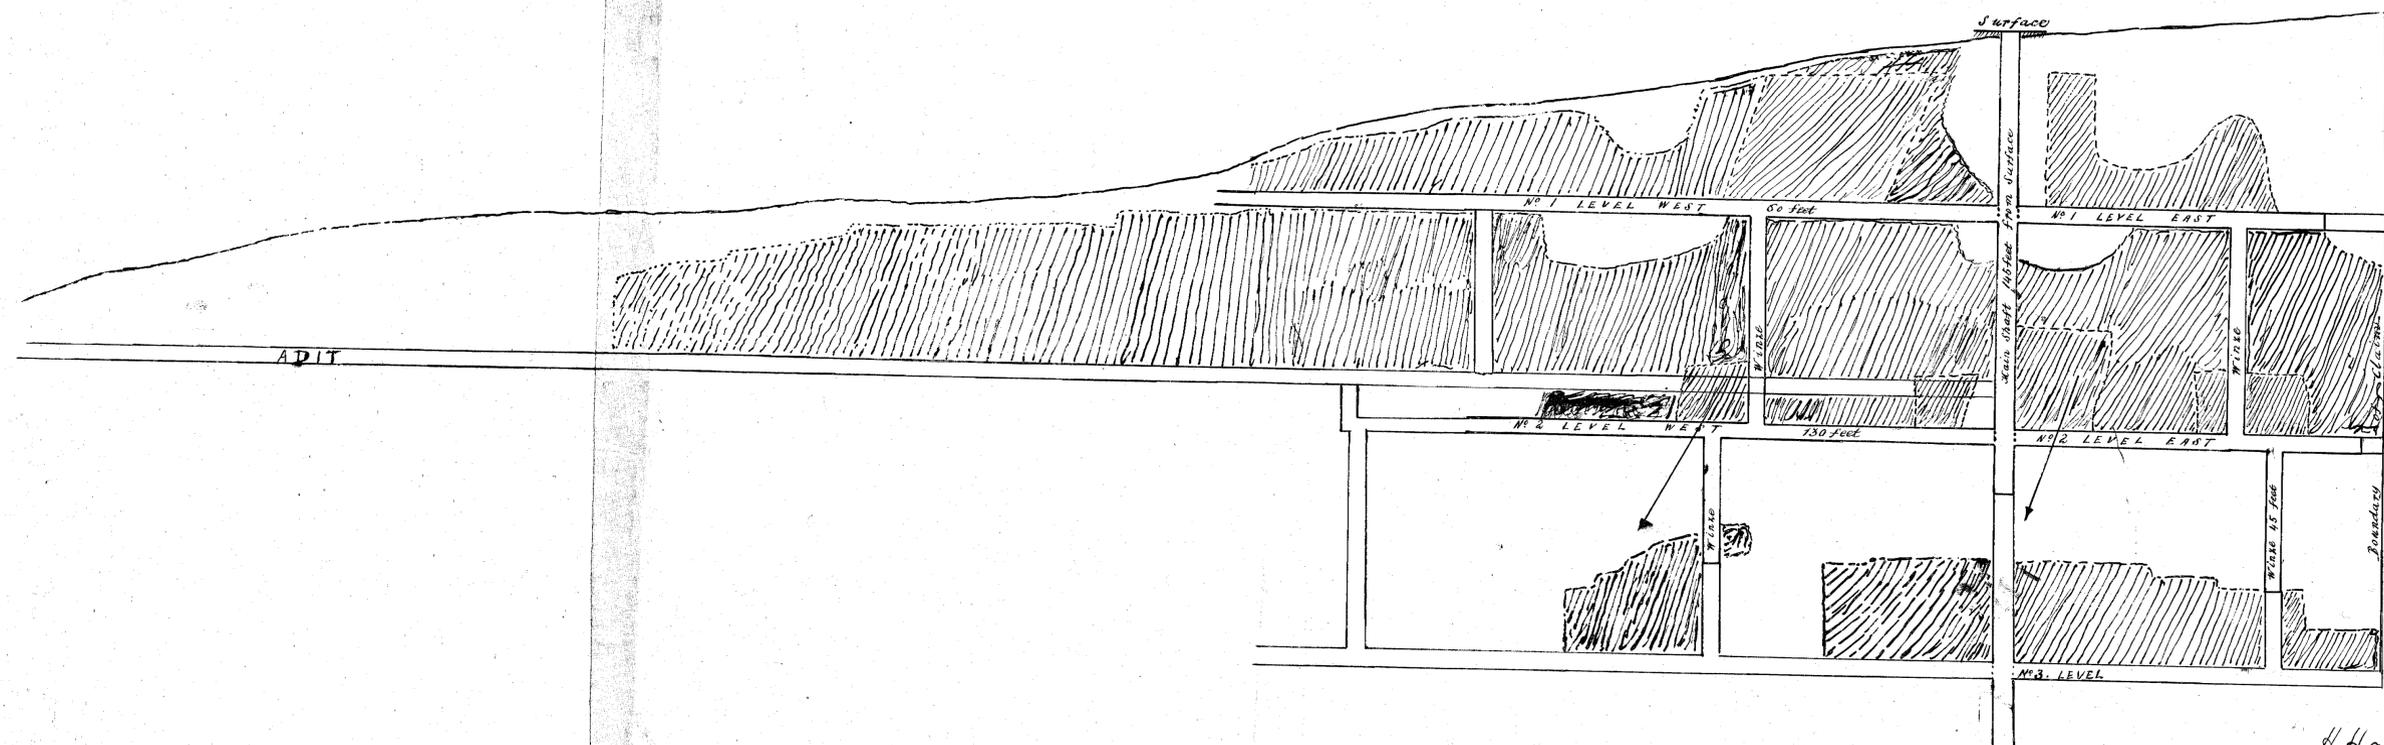

Cross Section

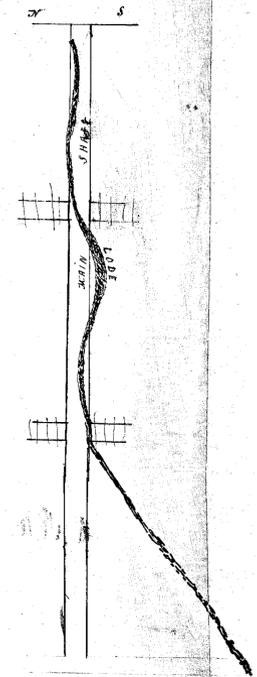

H. Hays, Jr. & P. Ray, Inc.
Mining Engineers
5th March 1888.

120-91

120-91