


MOONLIGHT G. M.

Scale 4 Chains to 100 Feet.

120-03

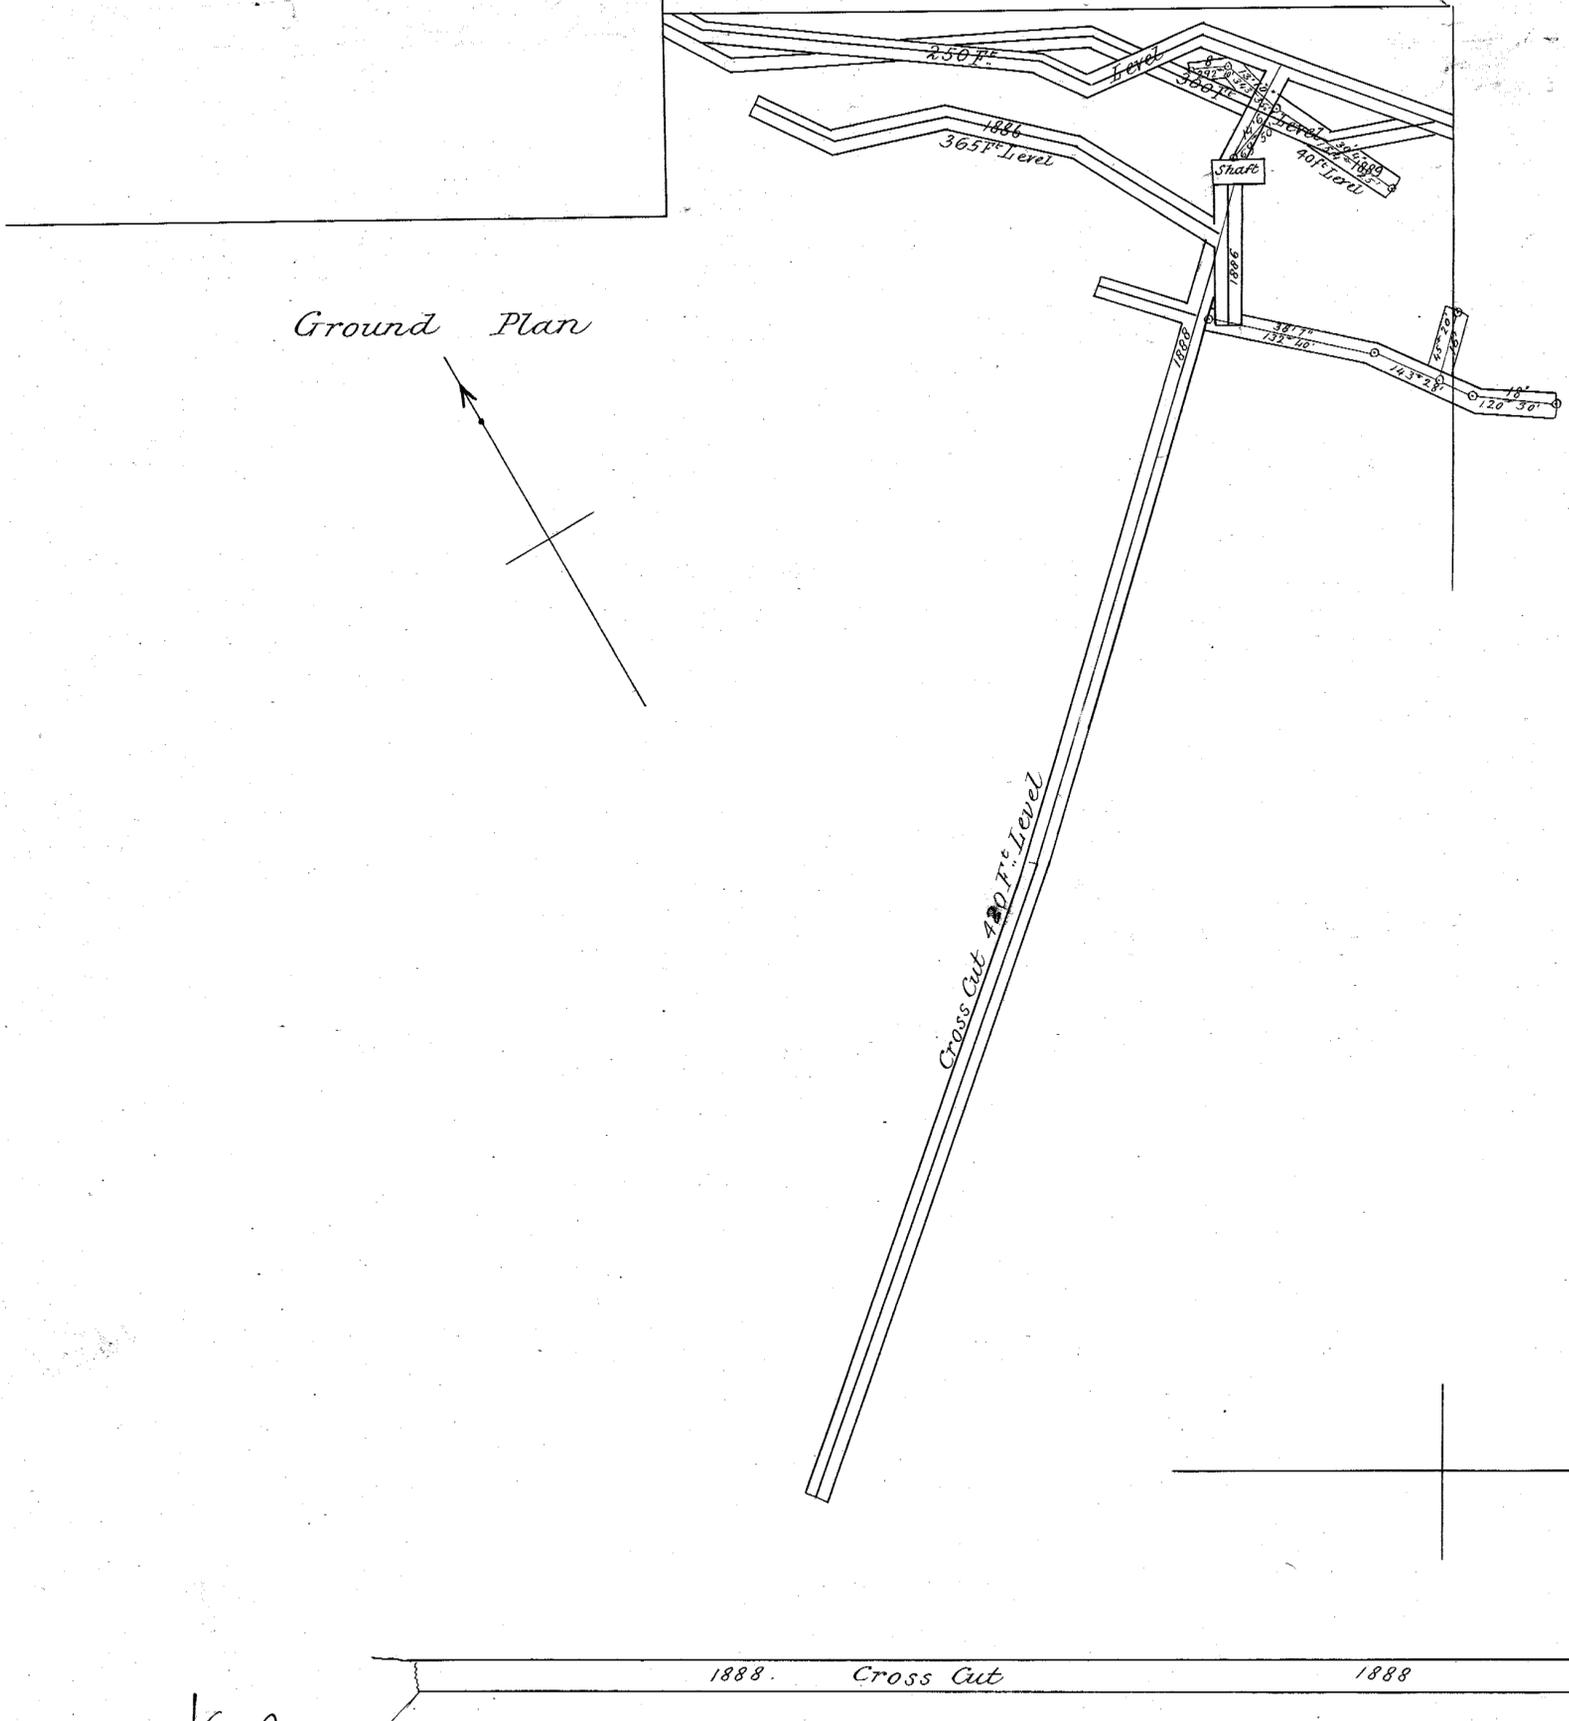

Ground Plan

5 m

Certified Correct
 copy of plan as managed
 office for work done during
 1885-6-7-8-9
 O. R. [Signature]
 [Signature]
 #