




121-01

5 cm

PLAN NEW GOLDEN GATE

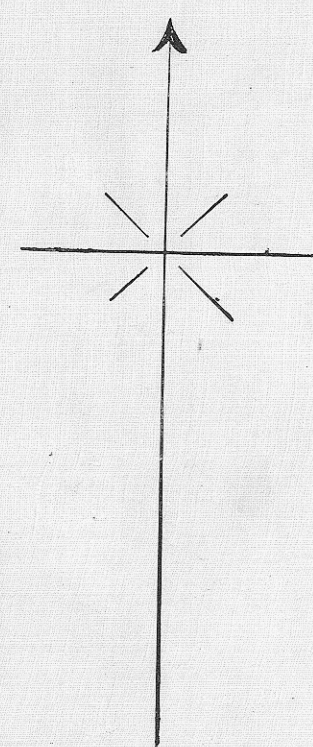

Consols Shaft

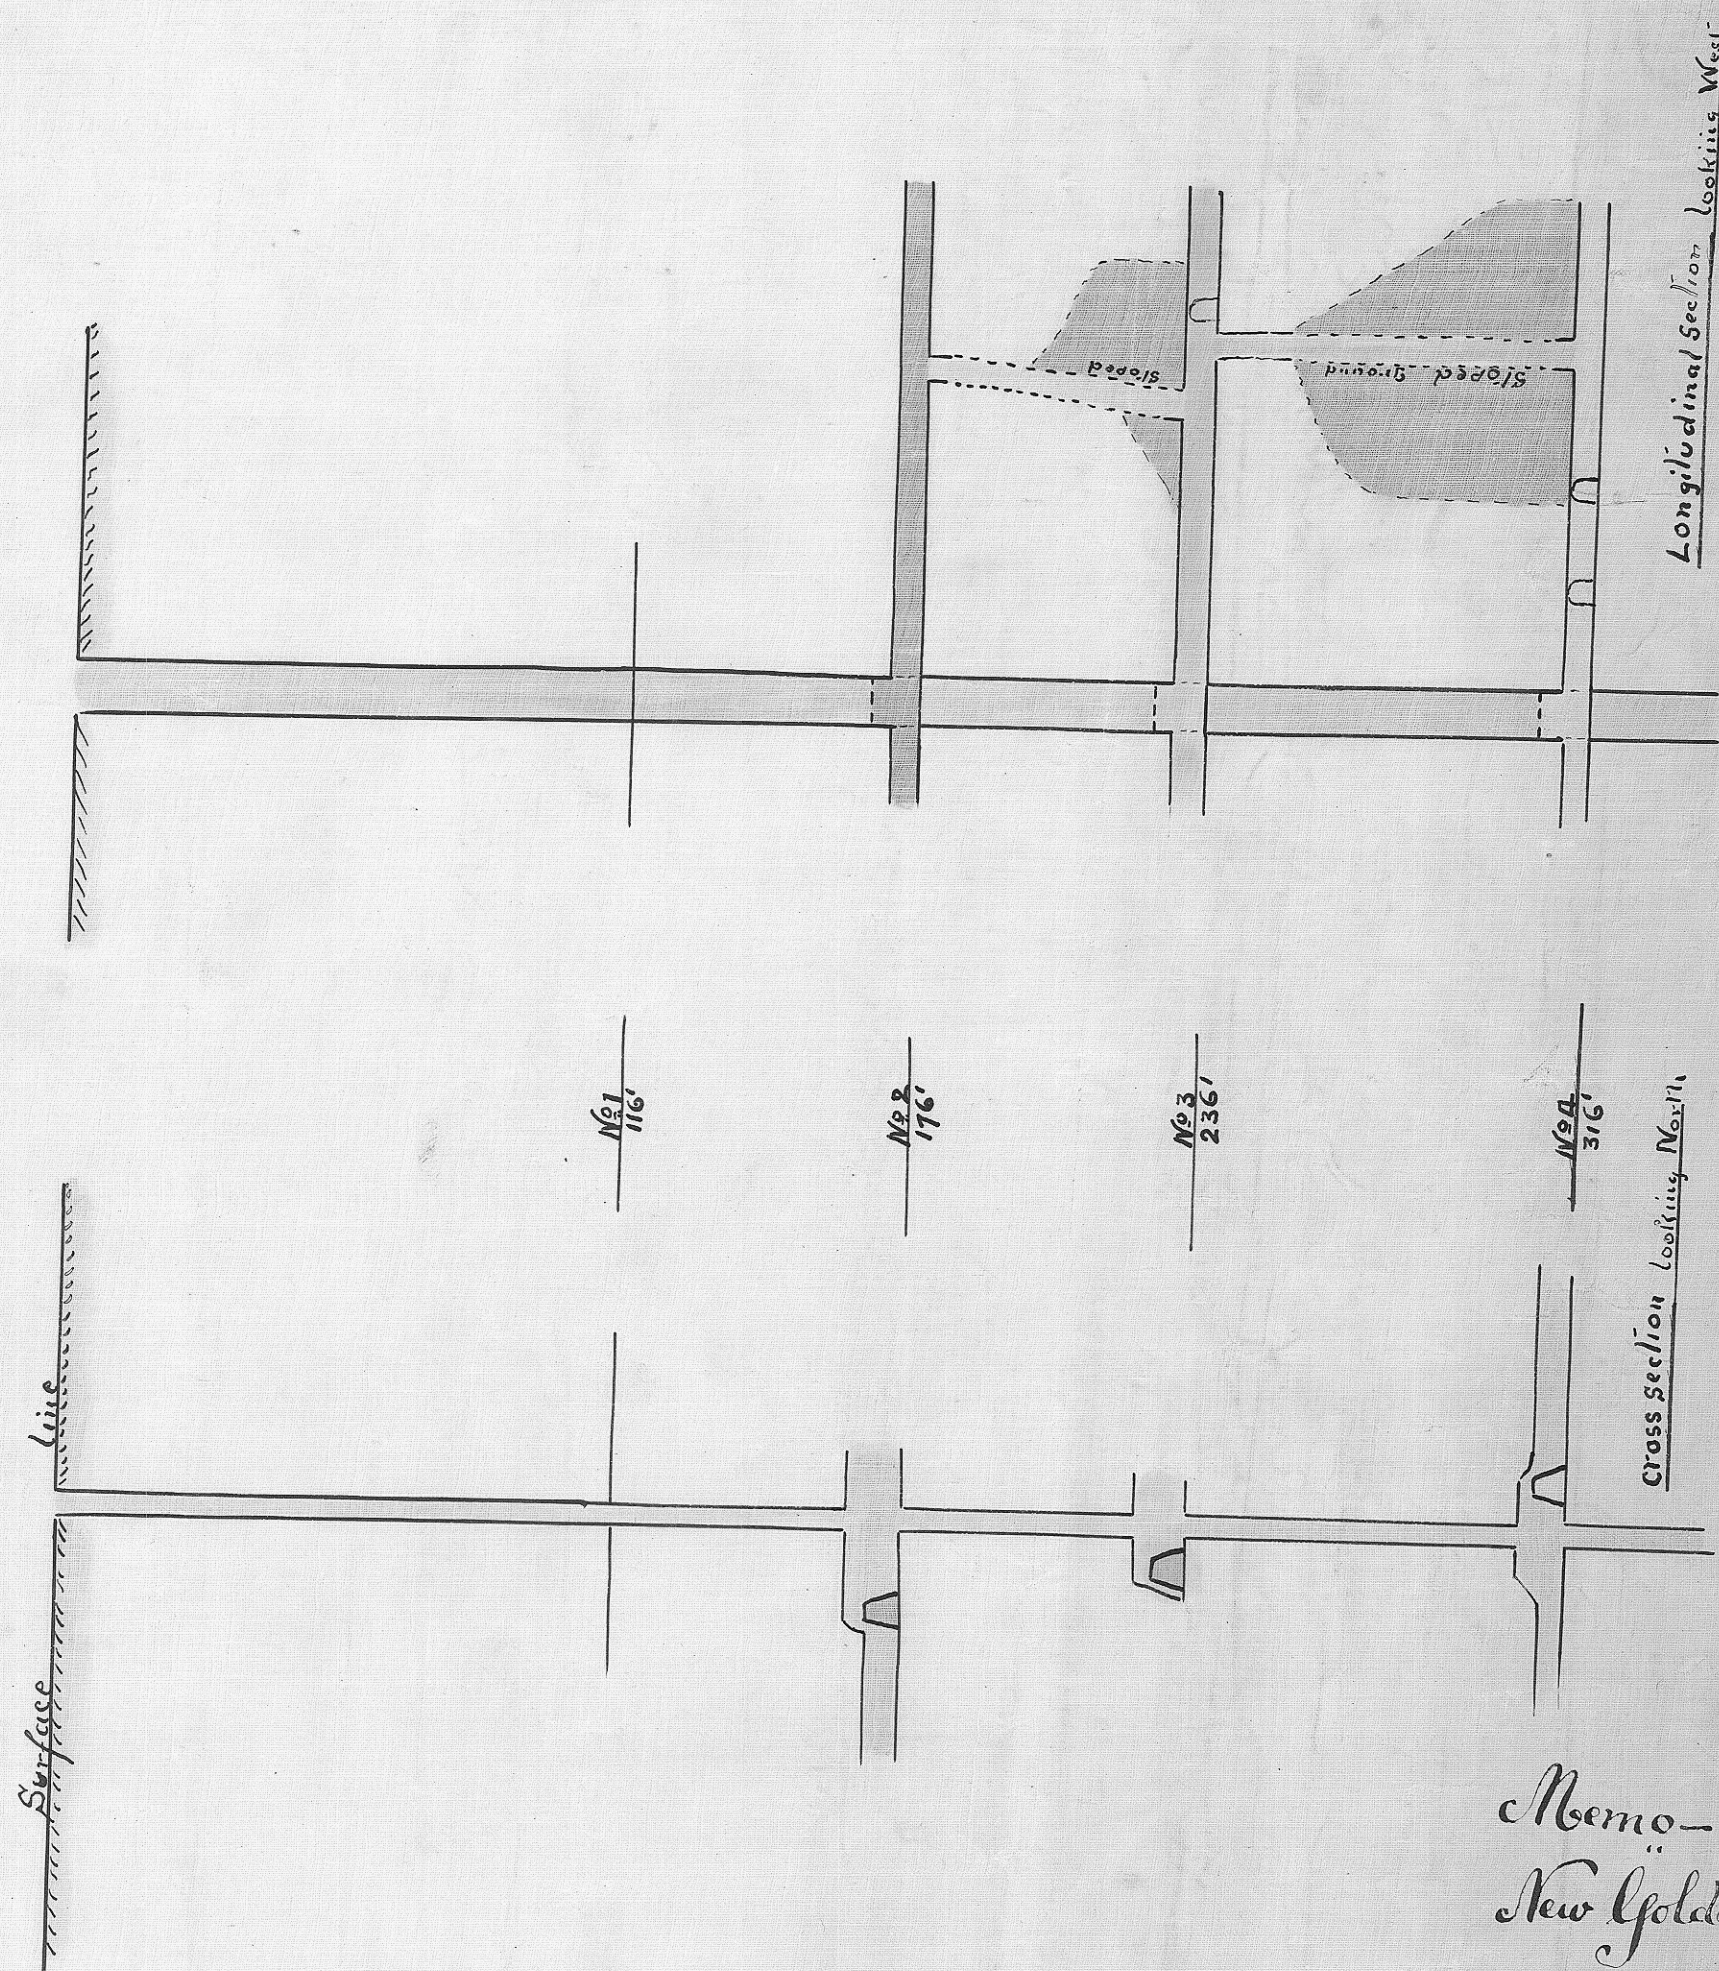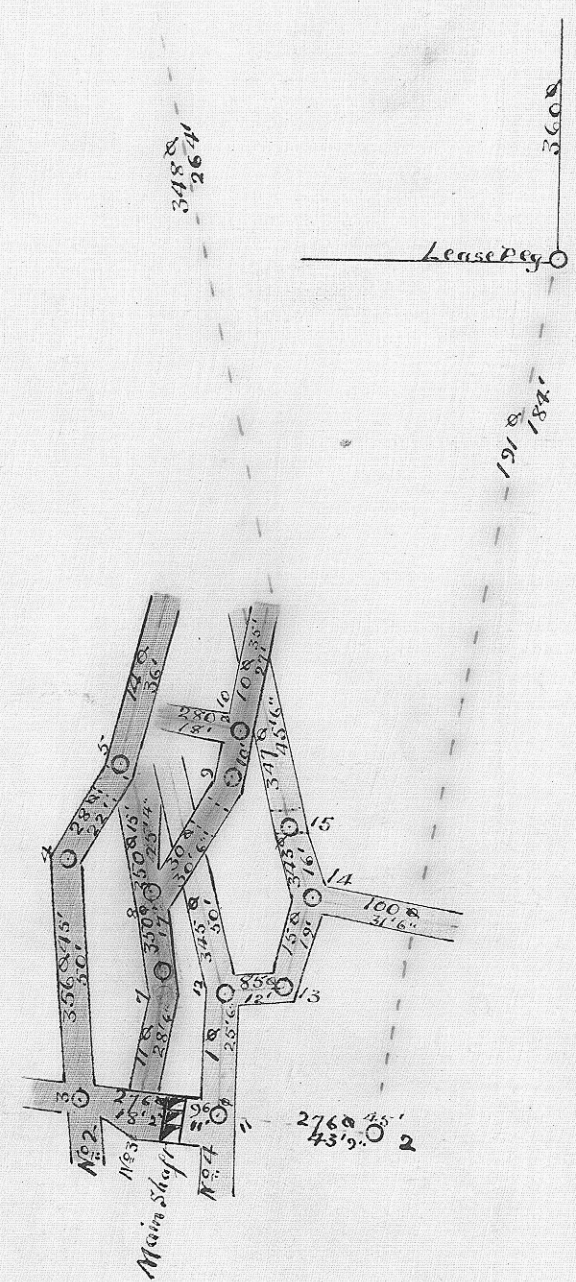

Memo.— Plan shows portion of the
New Golden Gate Mine, covering operations
conducted by the Proprietary ending 31/12/14.

Instrument used, Transit Theodolite

W. H. Mannan S.M.D.
Jan 28th 1915

121-01
New Golden Gate
Proprietary