
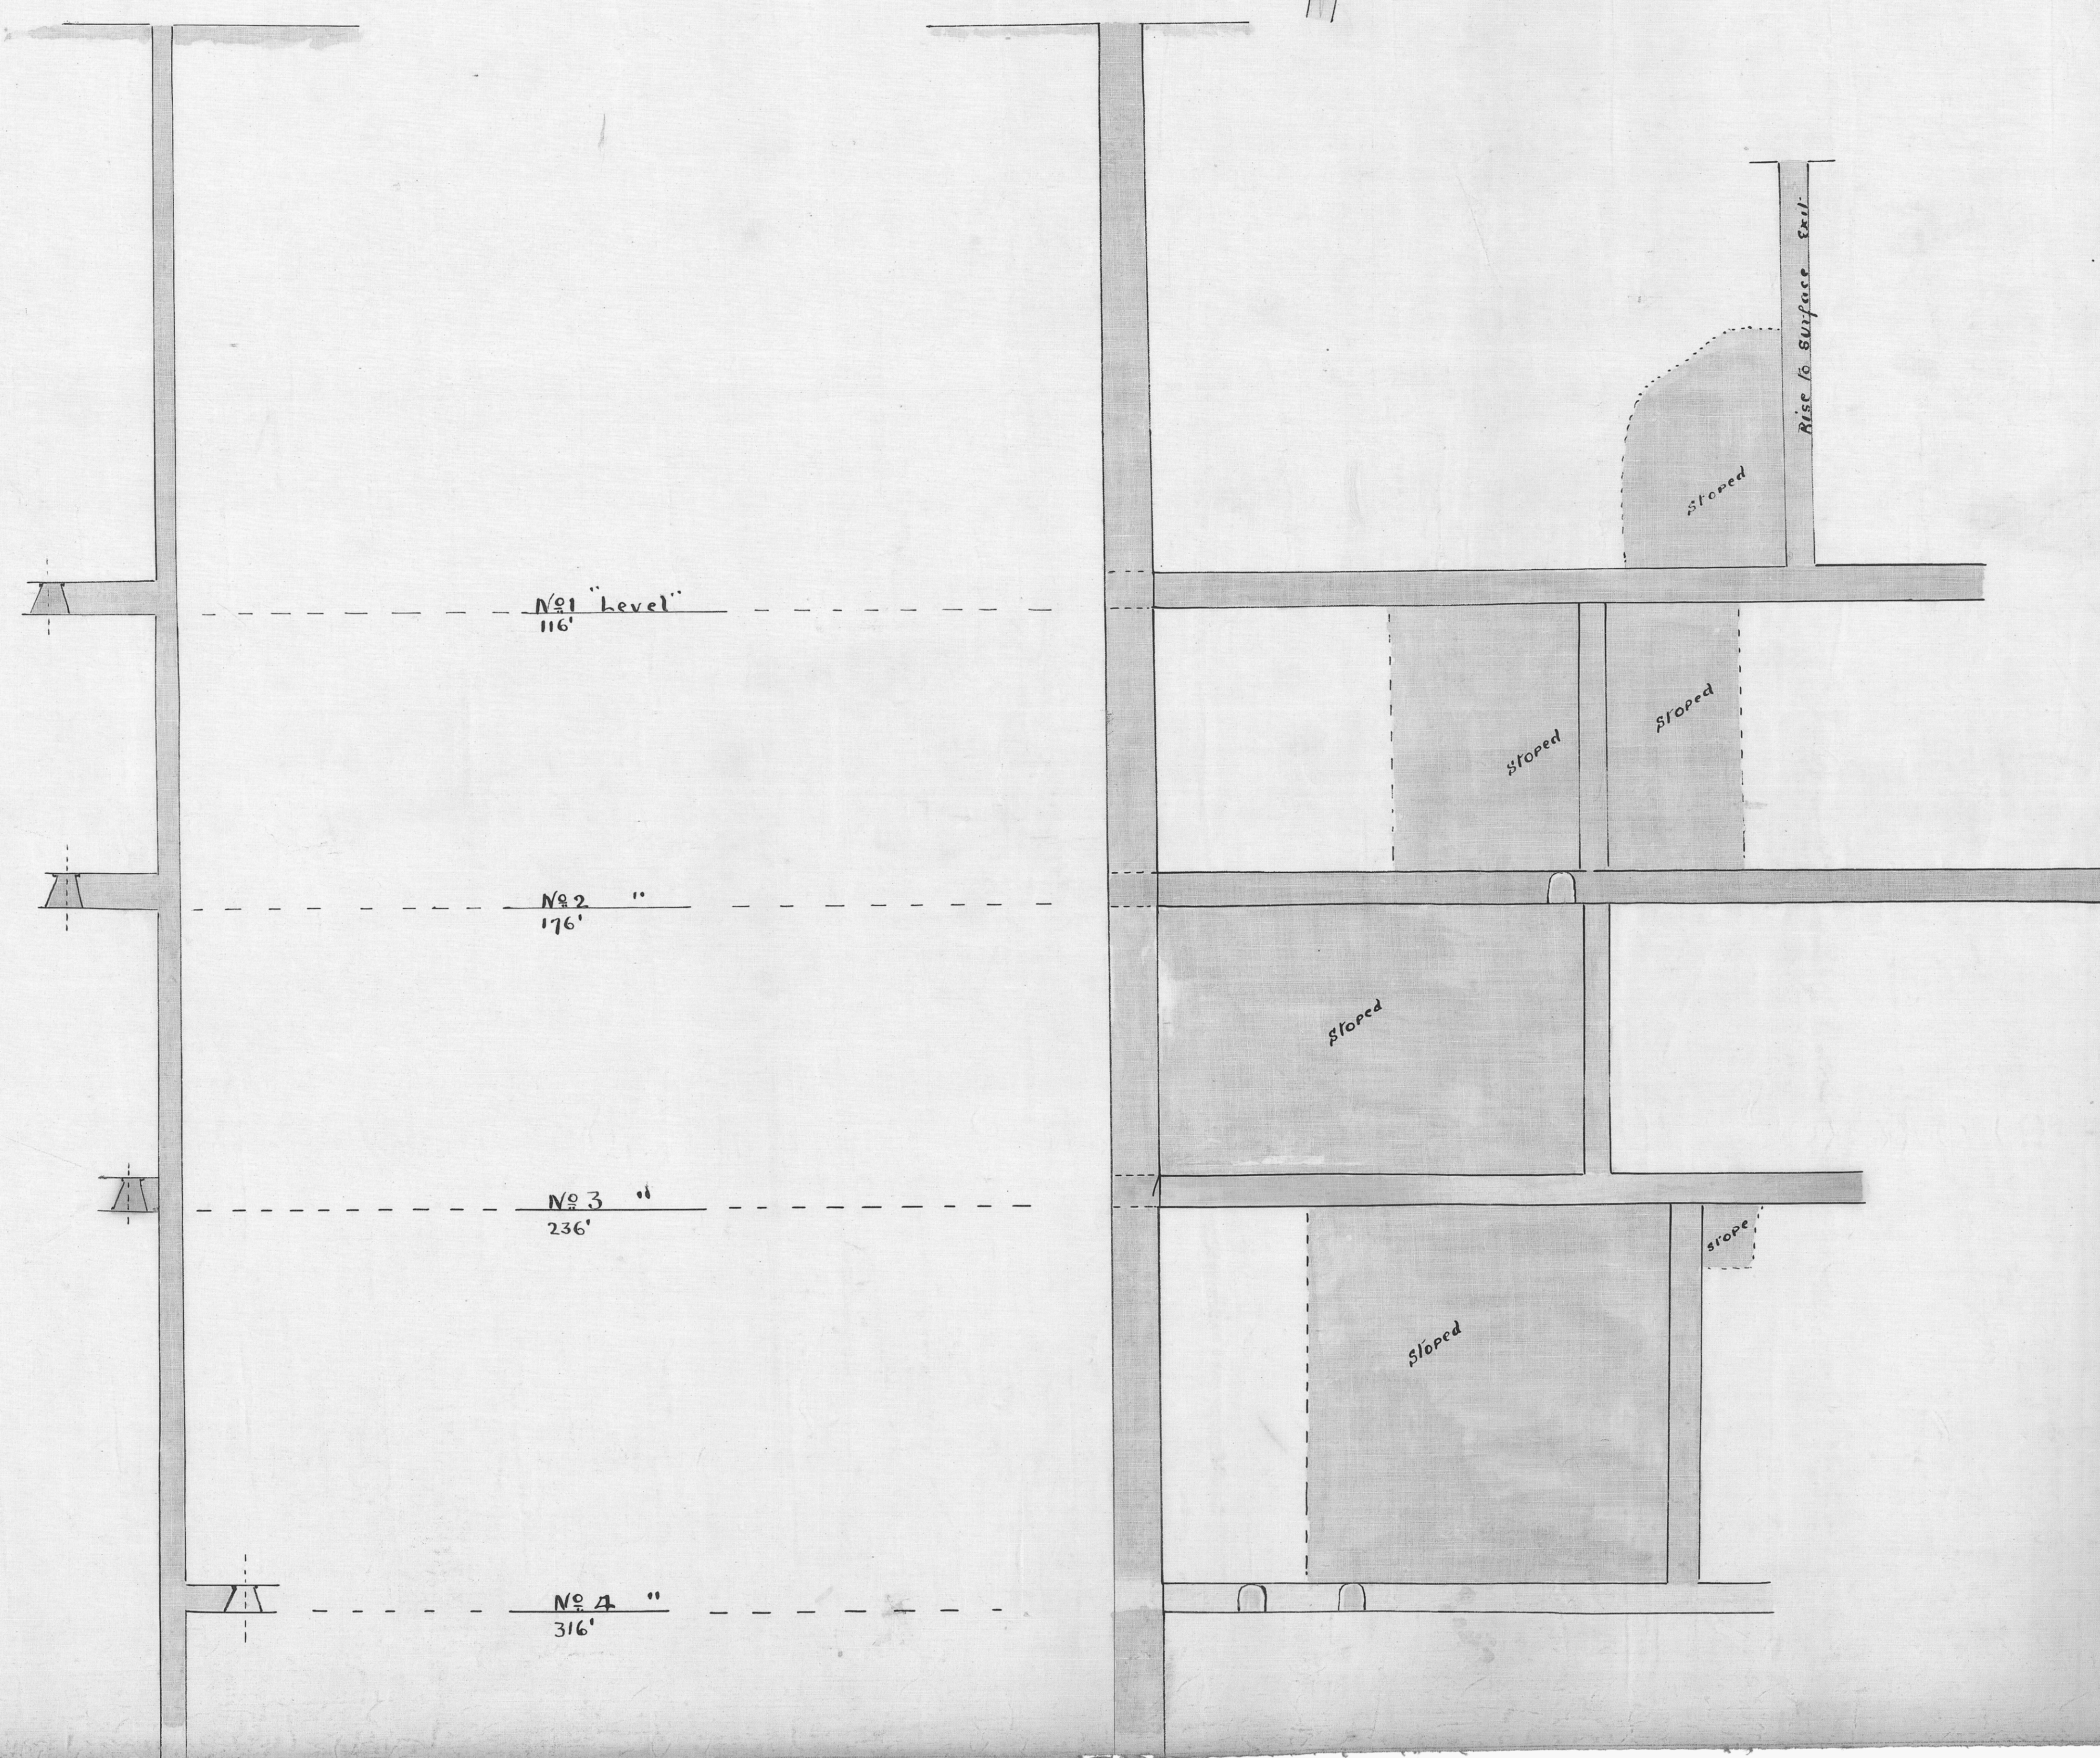
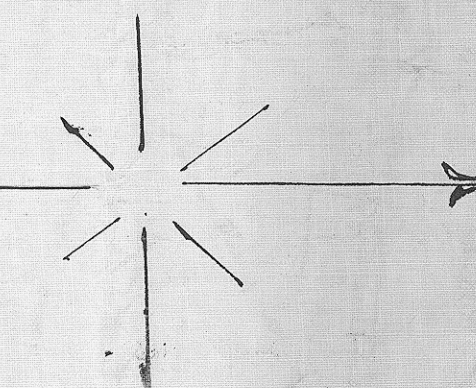


121-02

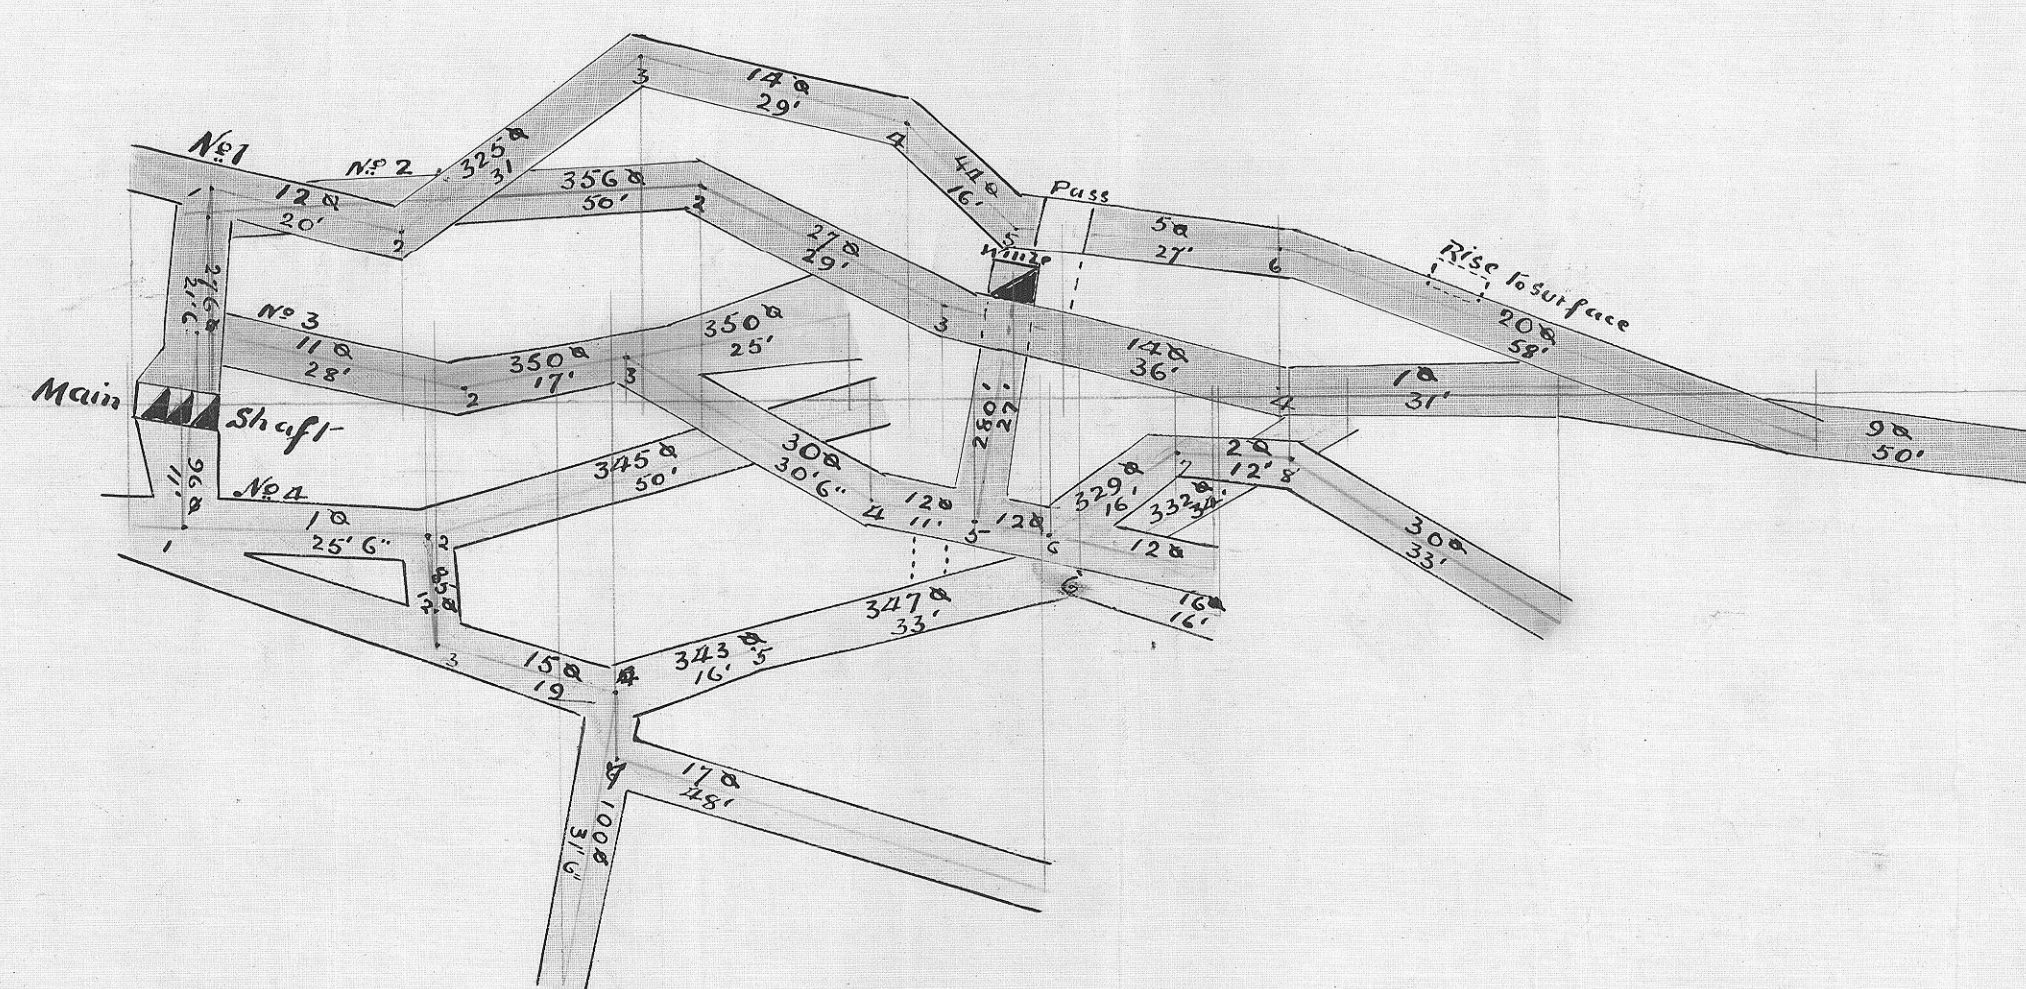

Scale = 20' = 1 inch

Instrument used Transit Theodolite

Tim Brannan
10/17/06

12/10/01