
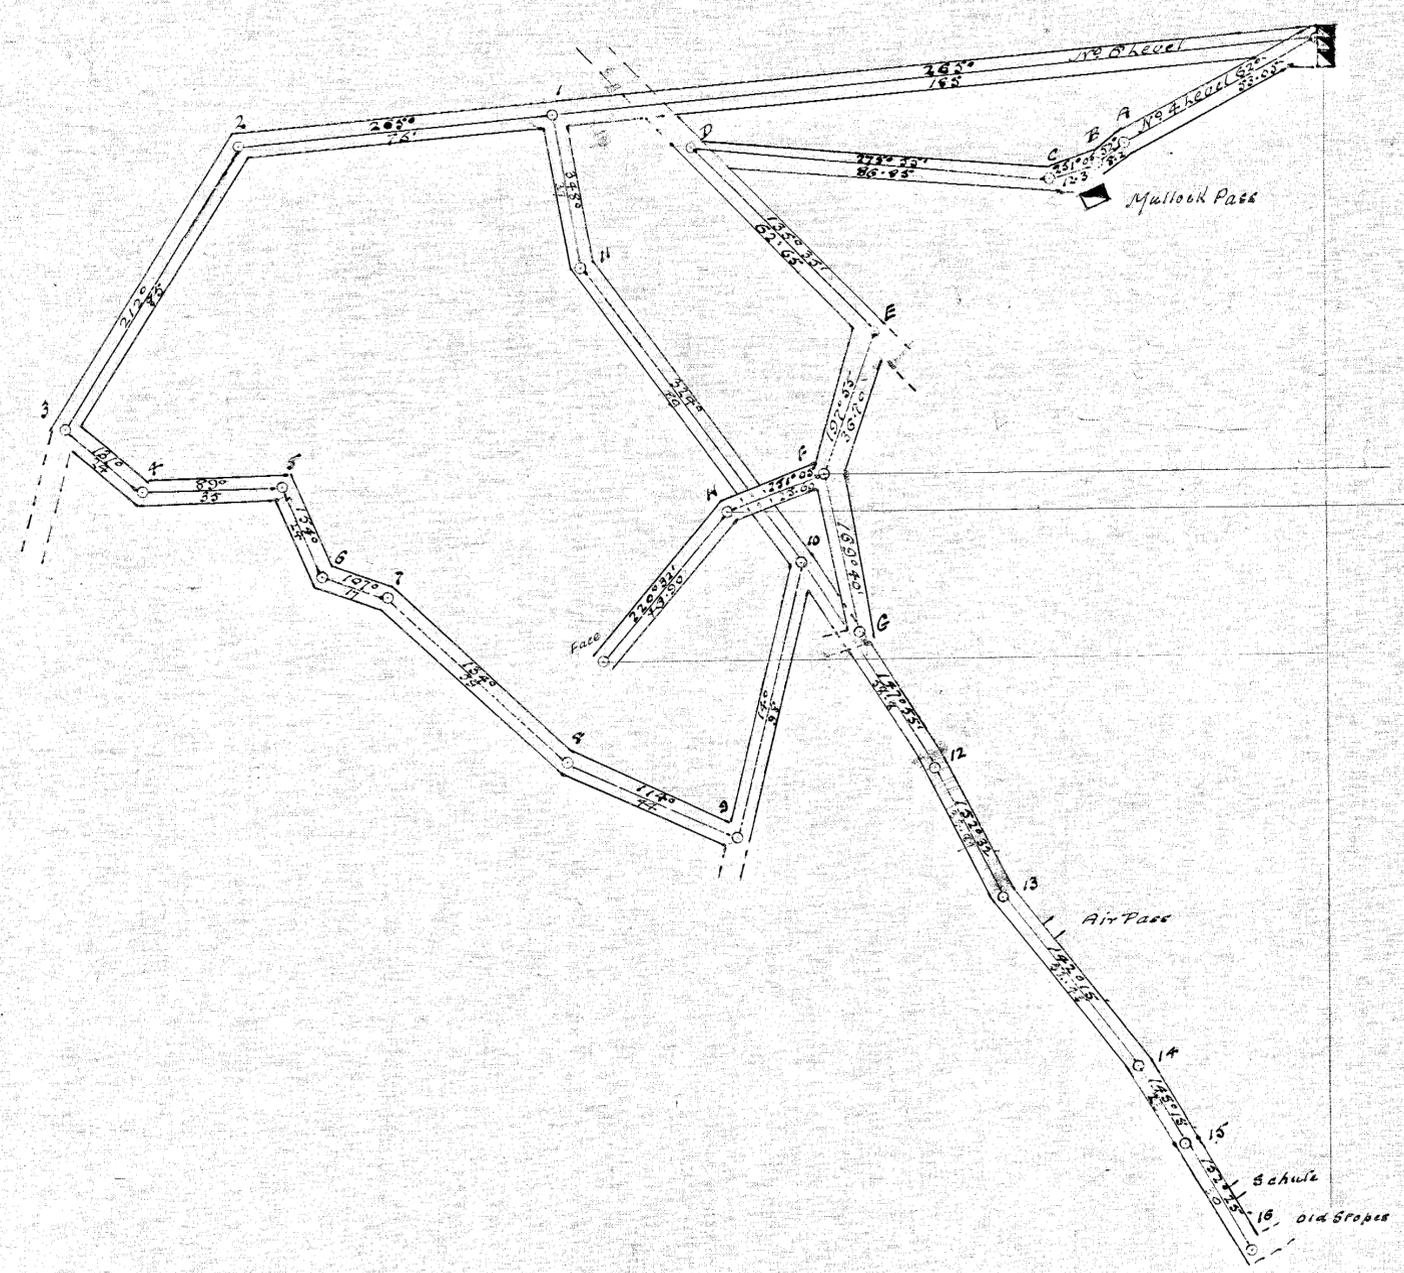


5 cm

121-06

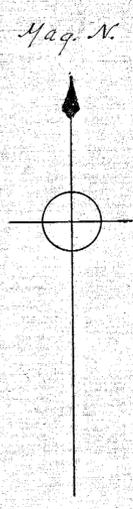

NEW GOLDEN GATE MINE

Plan

Scale 25 ft = 1 inch

Note - Survey at N86 level made from
 Station N89 Survey J. M. Brannan 1918

Wm. J. H. H. H.
 2/7/21
 S. of. and 5th Wye Theodolite