
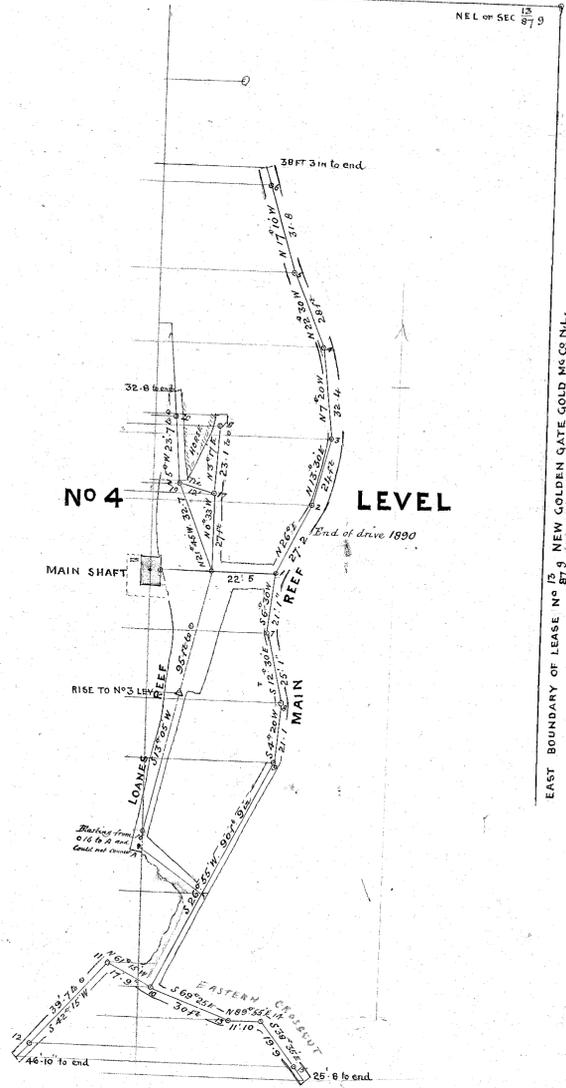


NEW GOLDEN GATE GOLD MINING COMPANY NOLIAI  
 MATHINNA GOLD FIELD

SEC 70  
879 NORTH GOLDEN GATE GOLD M<sup>c</sup>ON.L.

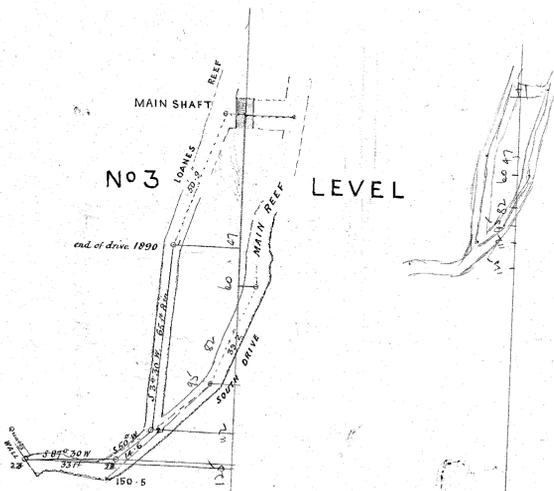

SCALE 25 FEET TO AN INCH.

George J. Lenth  
 Lawyer  
 Co 31<sup>st</sup> December 1891

12-07  
 12-07

1891