
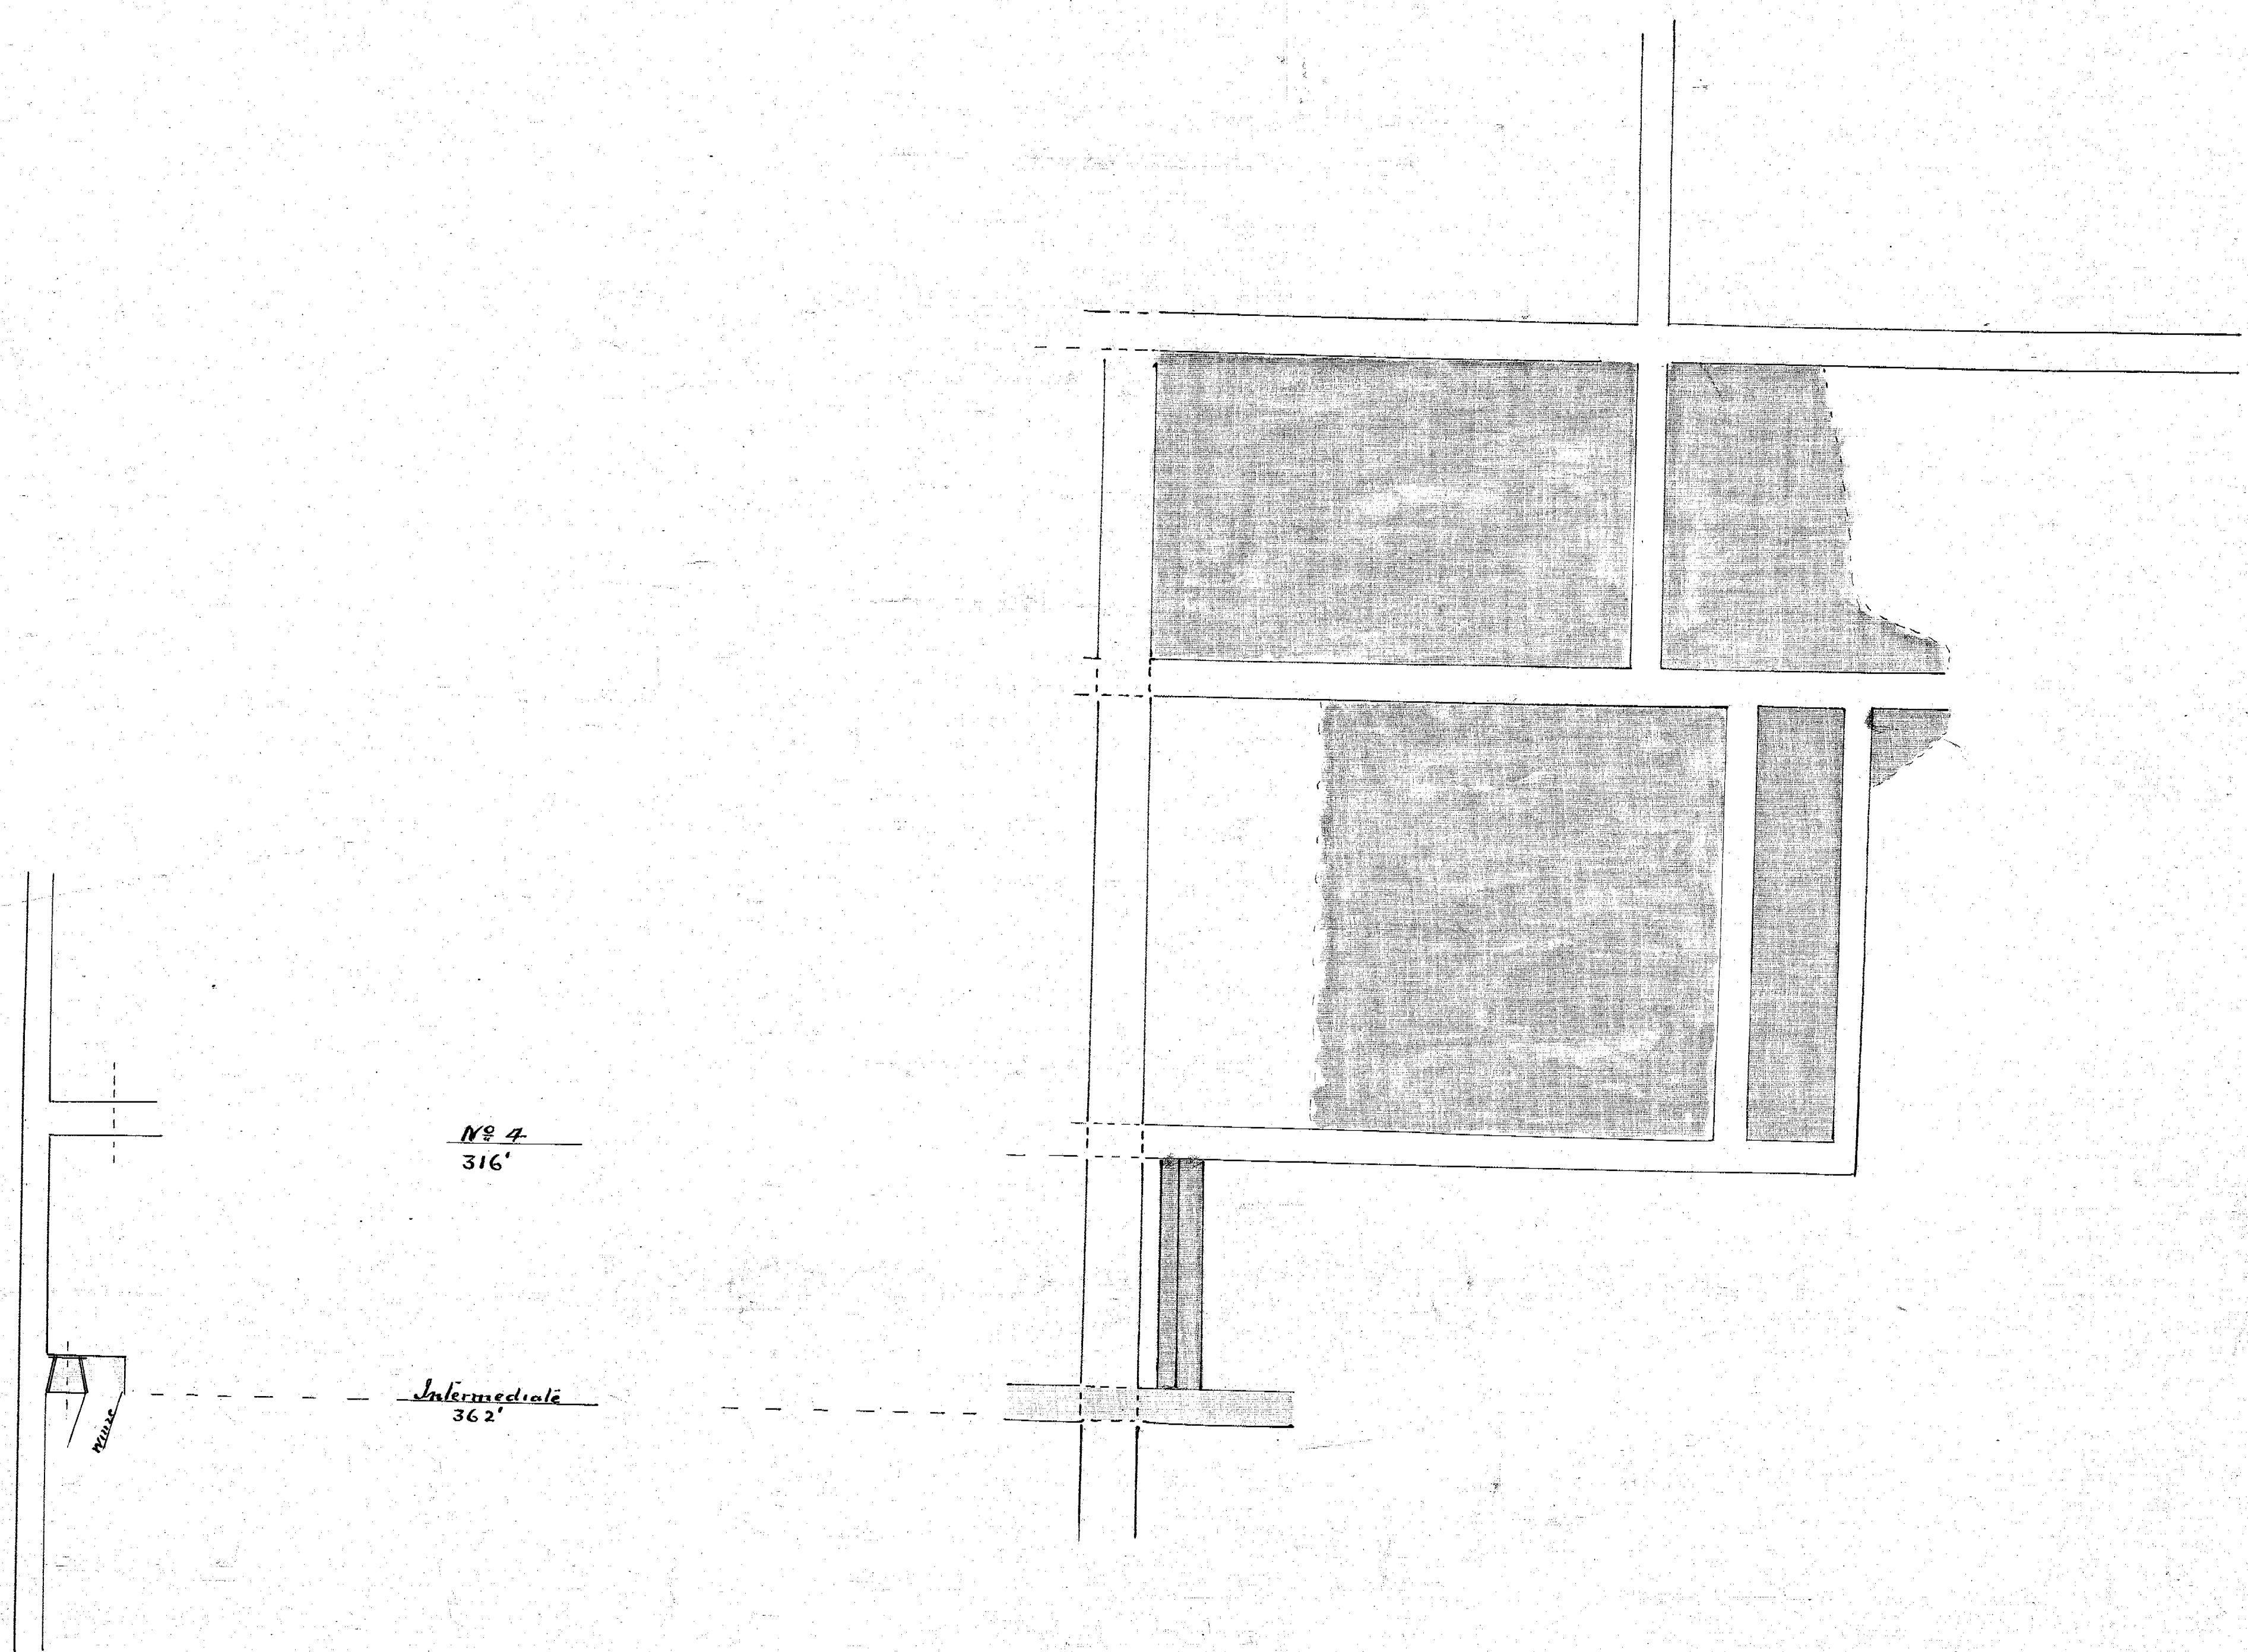
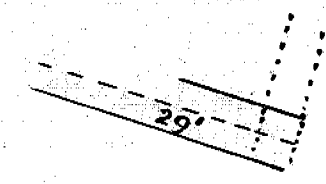


121-09

5 cm

121-09

Extended workings
New Golden Gate mine
March 31st 1917

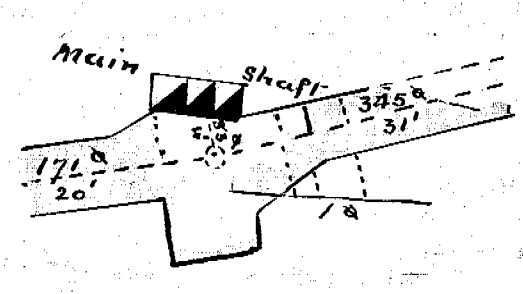

2916
New Golden Gate
121-09
53

8 MAY 1917
RECEIVED
BUREAU OF MINES
WASHINGTON

8 MAY 1917
RECEIVED
BUREAU OF MINES
WASHINGTON

2916
121-09
53