

NEW GOLDEN GATE GOLD


MINING CO NO LIA<sup>RY</sup>

LONGITUDINAL SECTION,


SCALE 25 FEET TO AN INCH

STOPE COLORED YELLOW

LOANES REEF

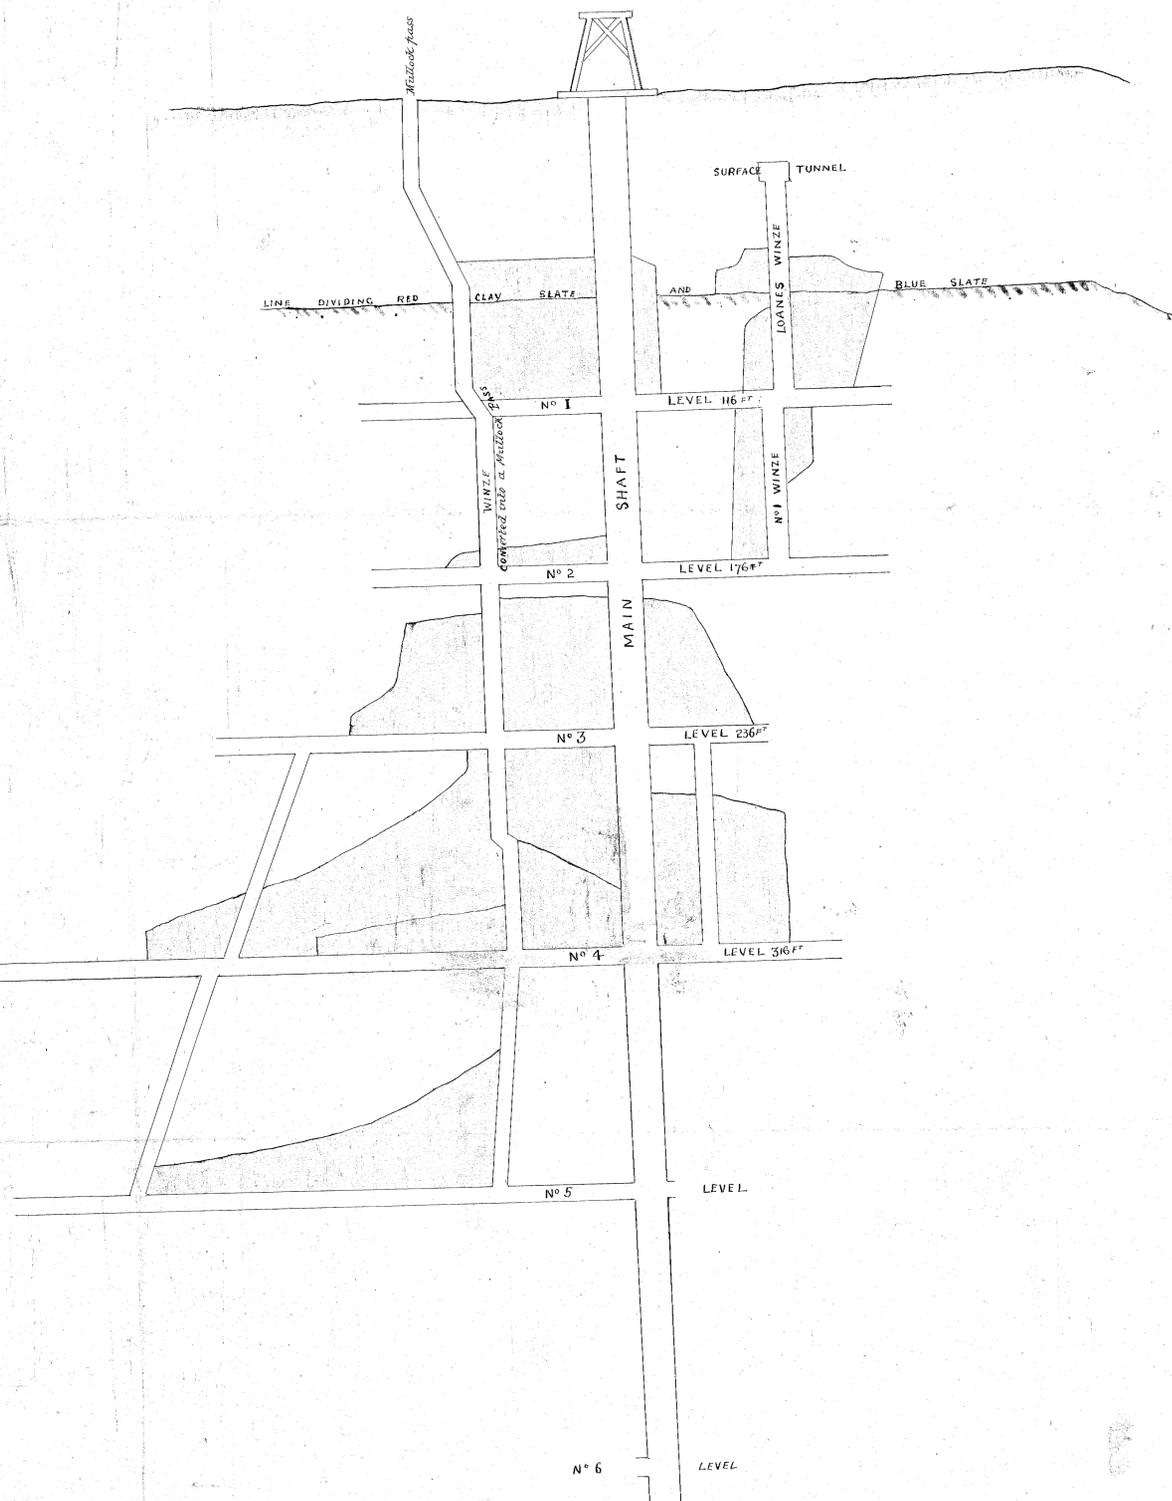

MAIN REEF

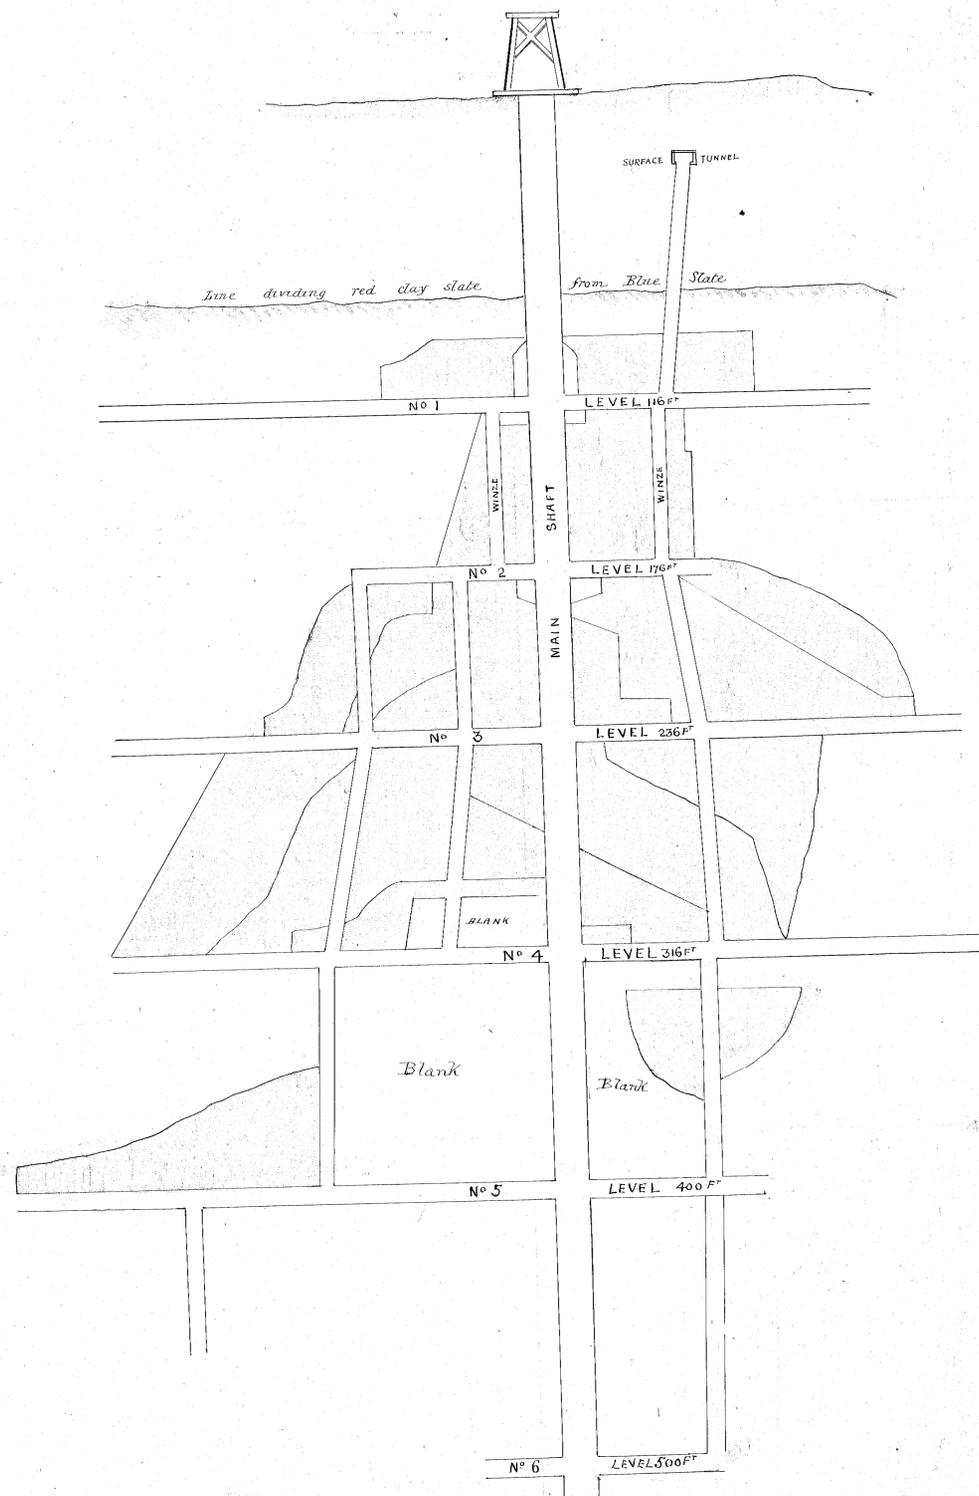

John House Mining Engineer