





121-11

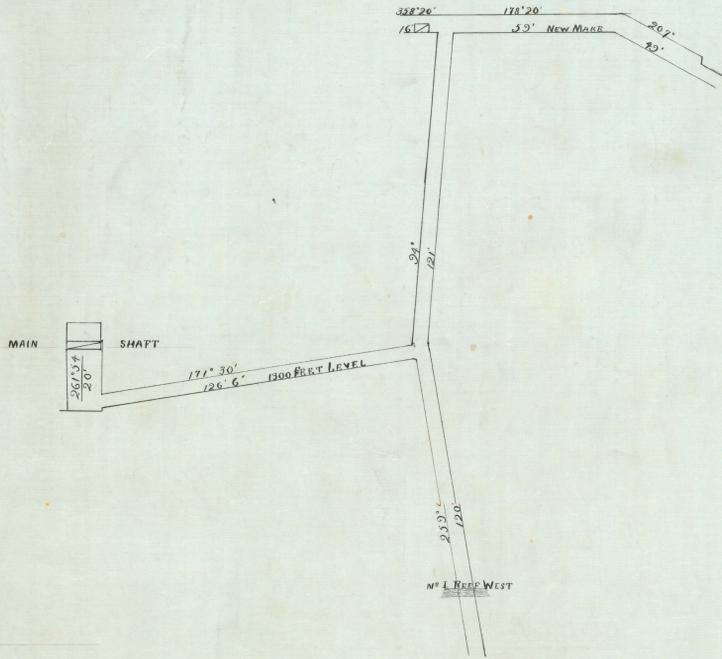

LONGITUDINAL SECTION  
NEW WEST MAKE

PLAN

 SCALE — 25 FEET TO ONE INCH

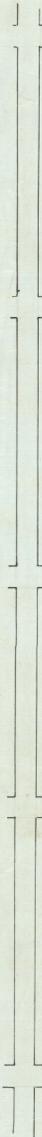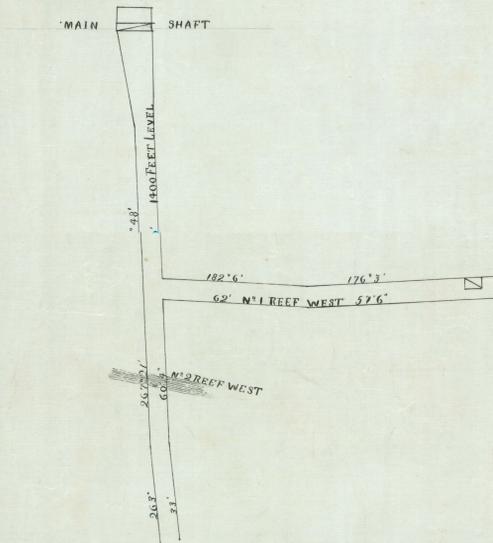

*Wm Andrews*  
*Chief Engineer*



New Golden Gate C. I.  
Jan 1, 1903