

NEW GOLDEN GATE GOLD MINING COMPANY NO LIABILITY

MATHINNA GOLD FIELD

UNDERGROUND LEVELS






SCALE 25 FEET TO AN INCH

George D. Smith
Surveyed at Reno
Dec 1890

SEC 70 NORTH GOLDEN GATE GOLD M^{CO} N.L.

SEC 79 NORTH GOLDEN GATE GOLD M^{CO} N.L.

SEC 78 NORTH GOLDEN GATE GOLD M^{CO} N.L.

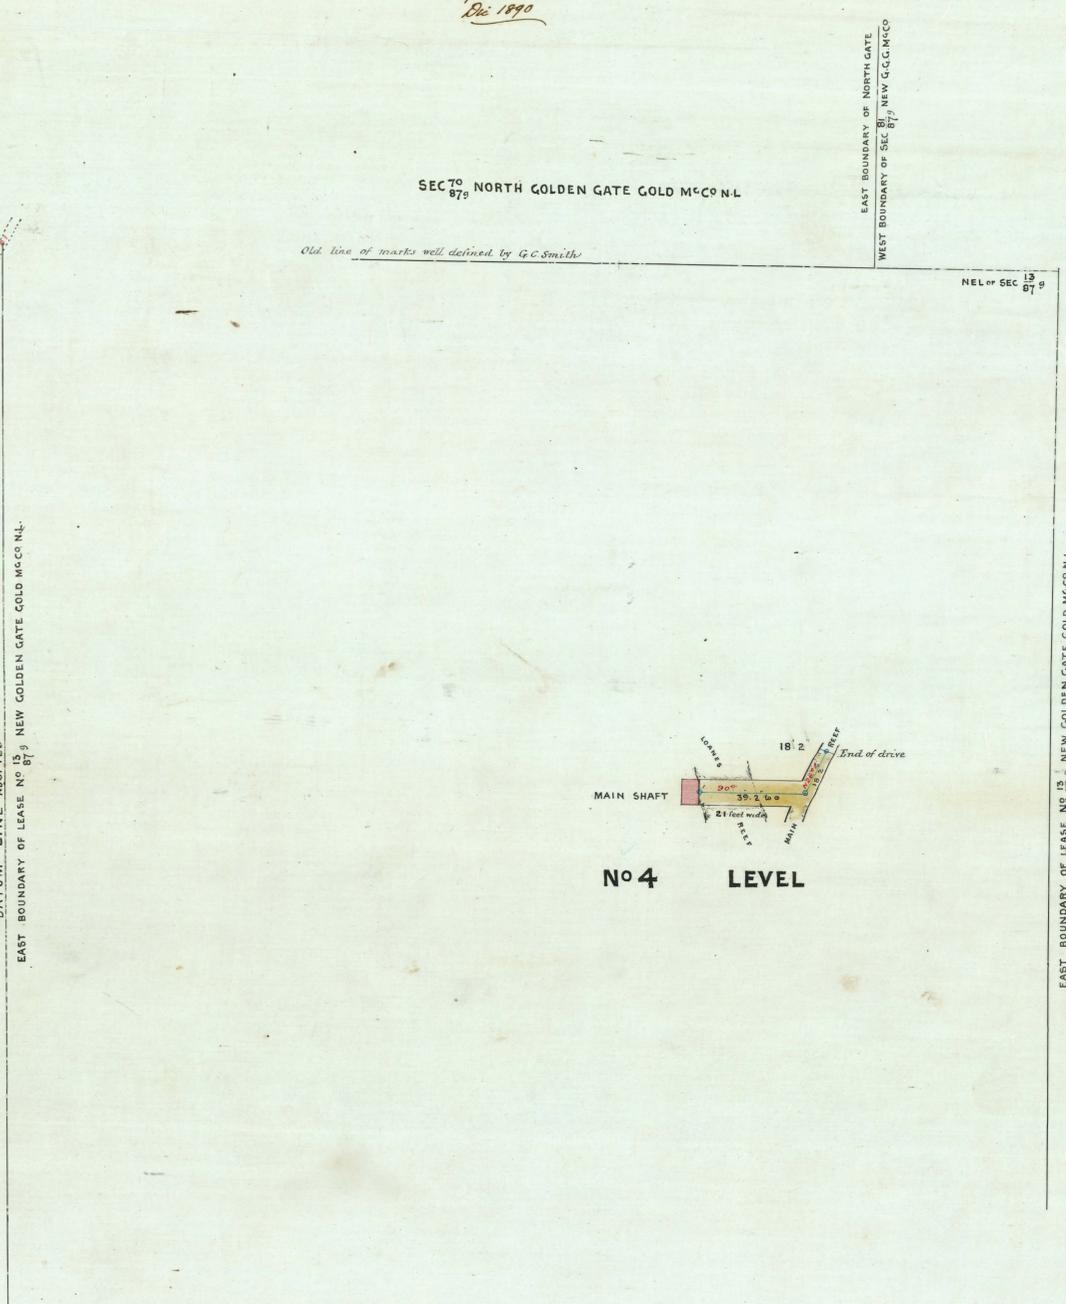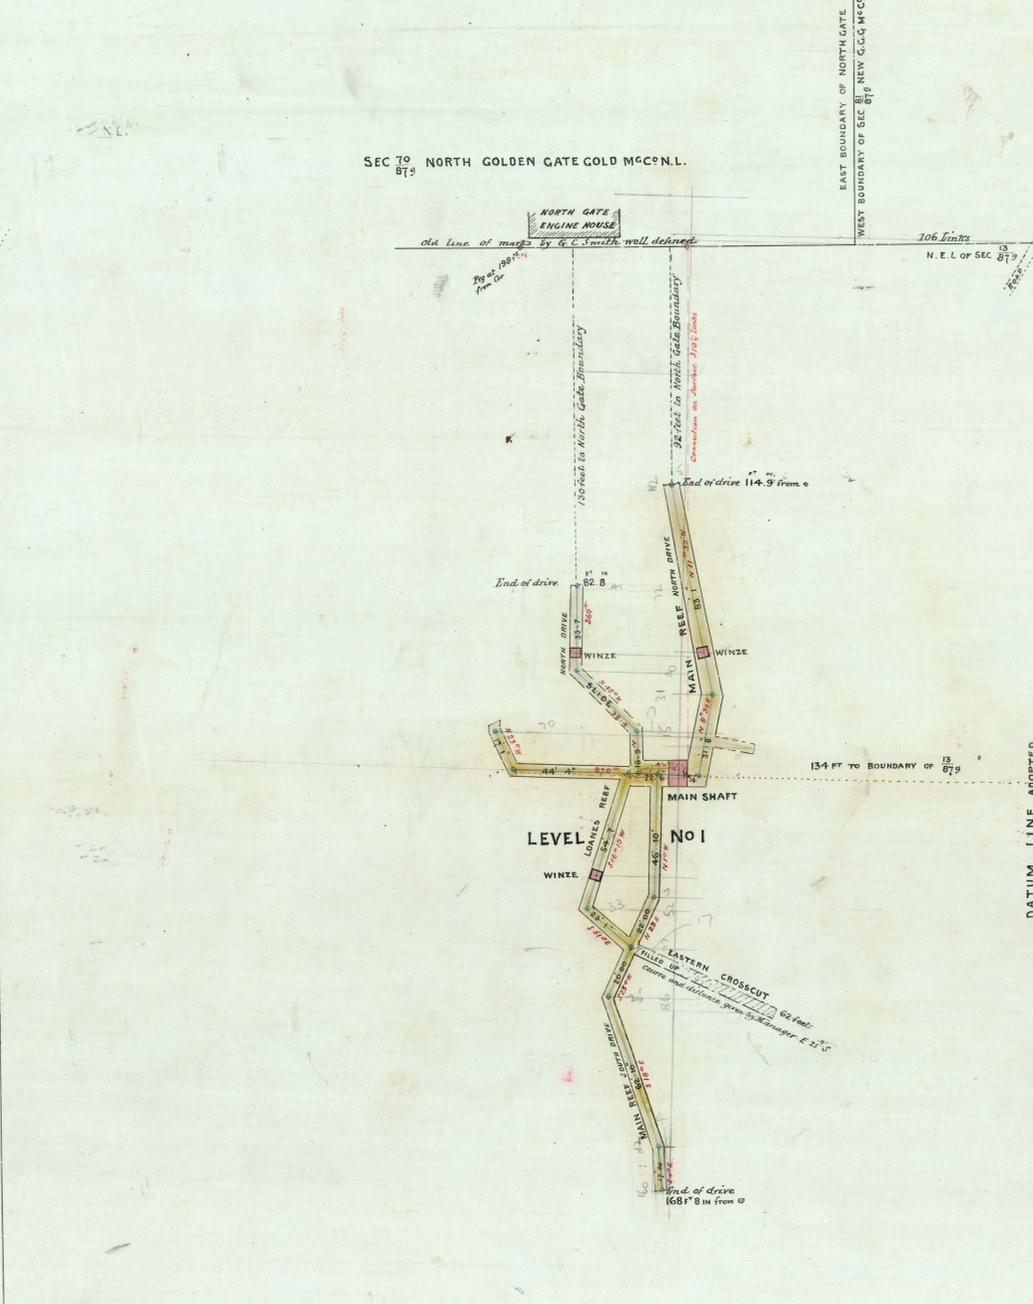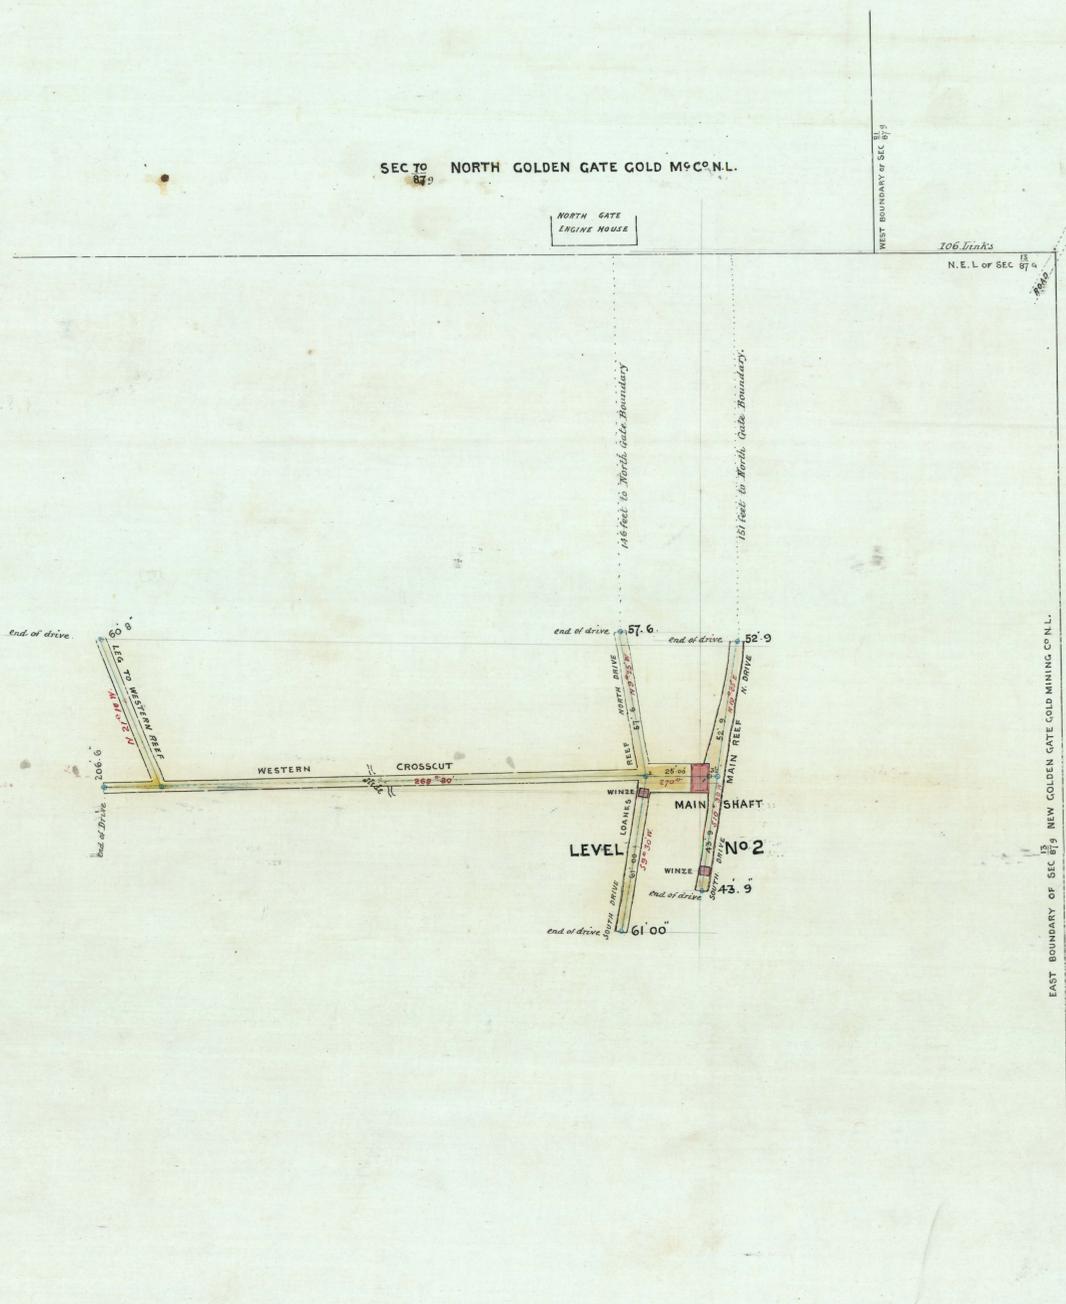

EAST BOUNDARY OF LEASE NO 15 NEW GOLDEN GATE GOLD M^{CO} N.L.

DATUM LINE ADOPTED EAST BOUNDARY OF LEASE NO 15 NEW GOLDEN GATE GOLD M^{CO} N.L.

EAST BOUNDARY OF NORTH GATE WEST BOUNDARY OF SEC 78 NEW G.C.C.M.C.O.