
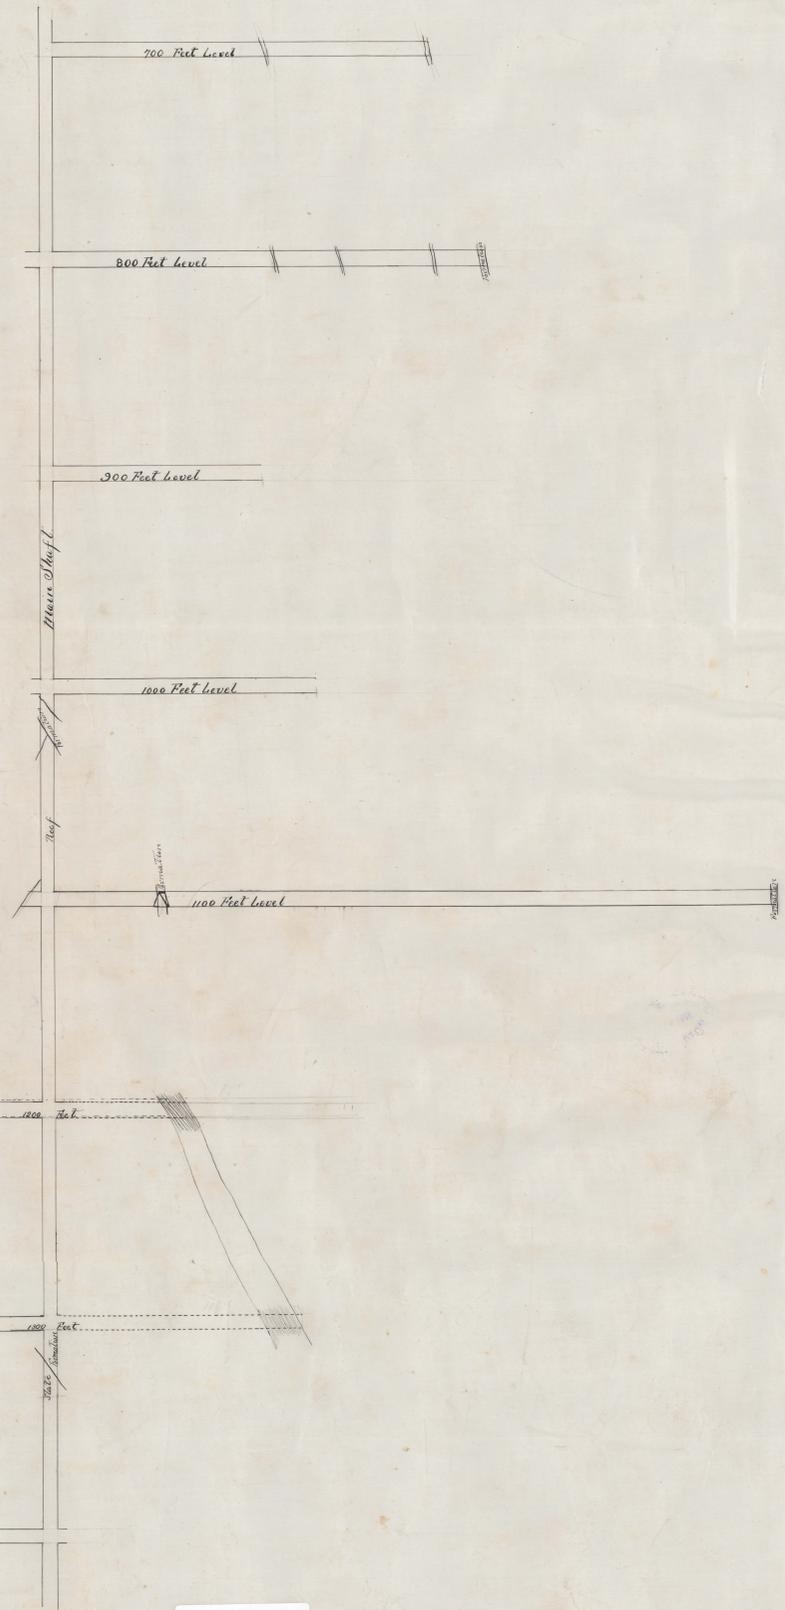


CROSS SECTION

121-13

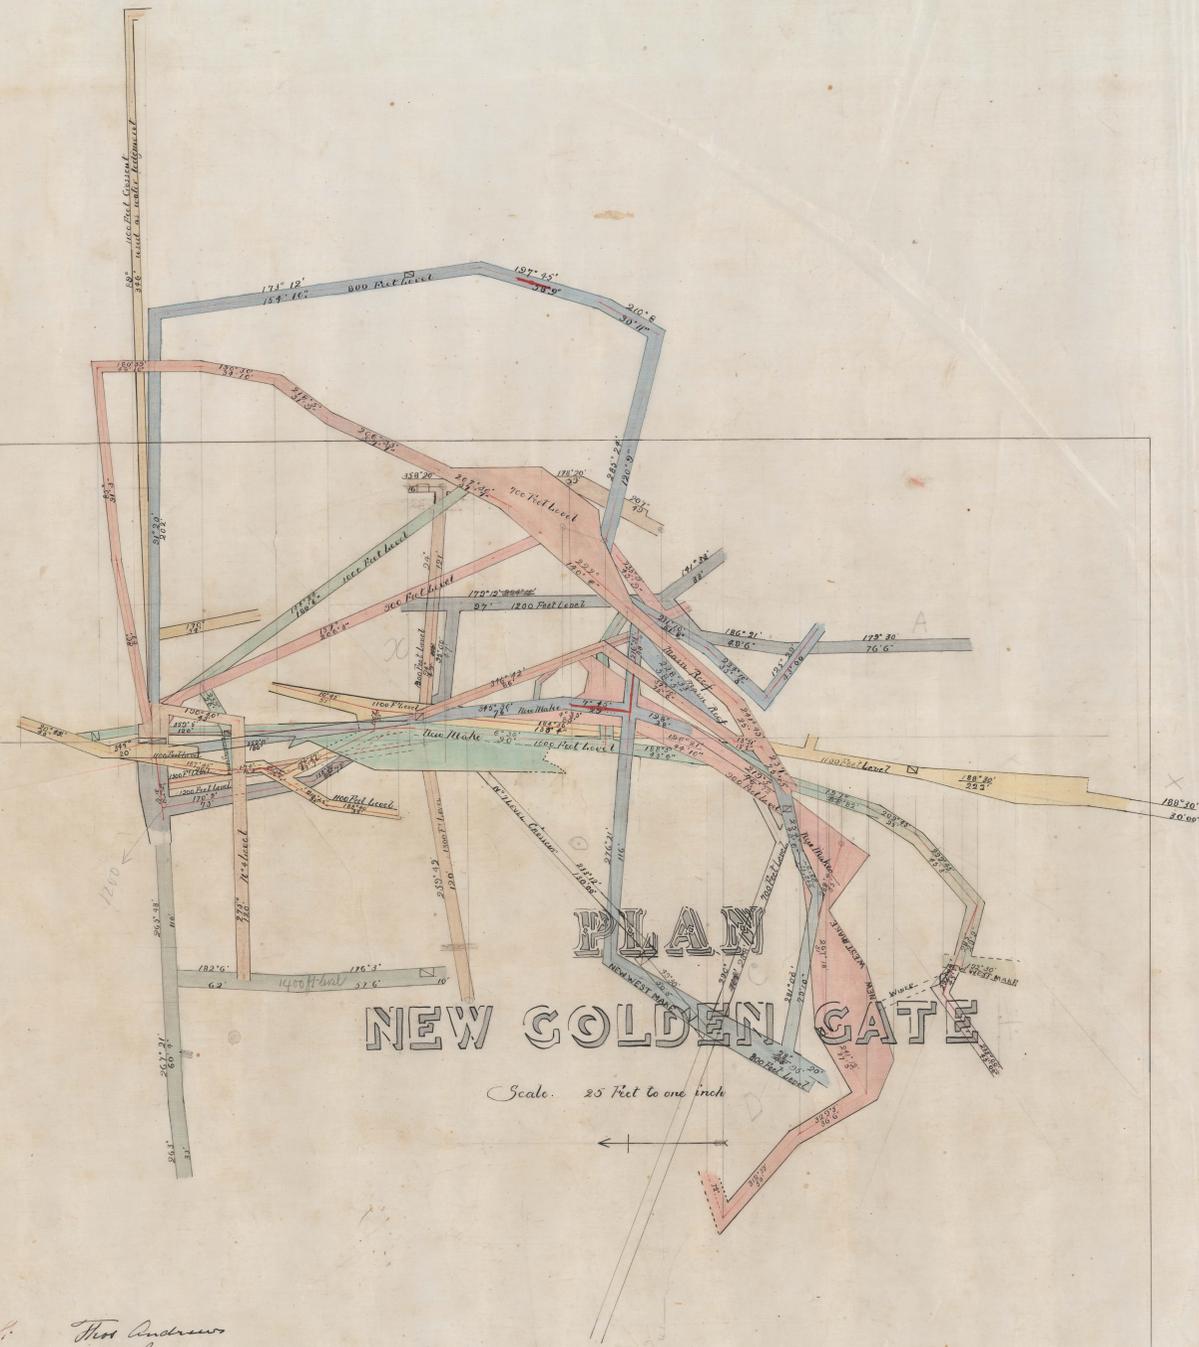

PLAN
NEW GOLDEN GATE

Scale 25 Feet to one inch

Wm. Anderson
Main Engineer
Jan 1st 1899

Jan 1st 1899
Jan 1st 1900
Jan 1st 1901
Jan 1st 1902

Surveyed with theodolite
5 inch Dial
with enclosed Vernier.



Golden Gate Co.

72.55
Dec. 1902
10 days

Chief Engineer from North West Corner 87° 25' 12.5"