



SEC. 29⁵/₈
10 AC.

Instrument used: - Theodolite Sine dial - enclosed Verniers

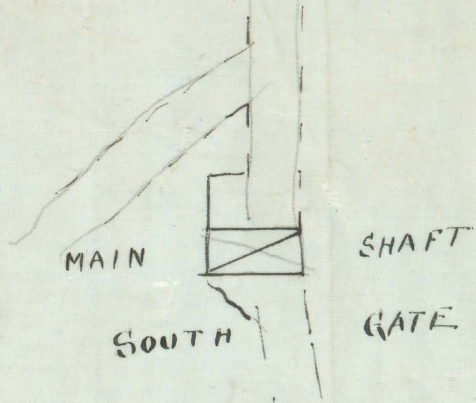


S. J. Andrews
December 1905
JANUARY 1907
January 1908.
January 1909.

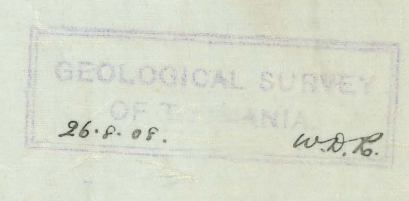

S. J. Andrews
Mine Manager.

121-15

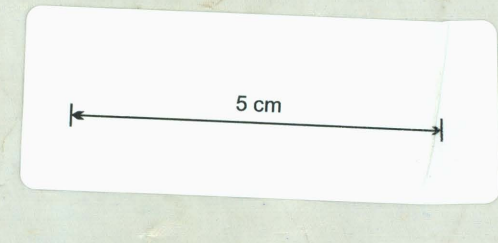

Feb. March 10th 1909.
W.A.B.

131

100 ft. distance
from top of