
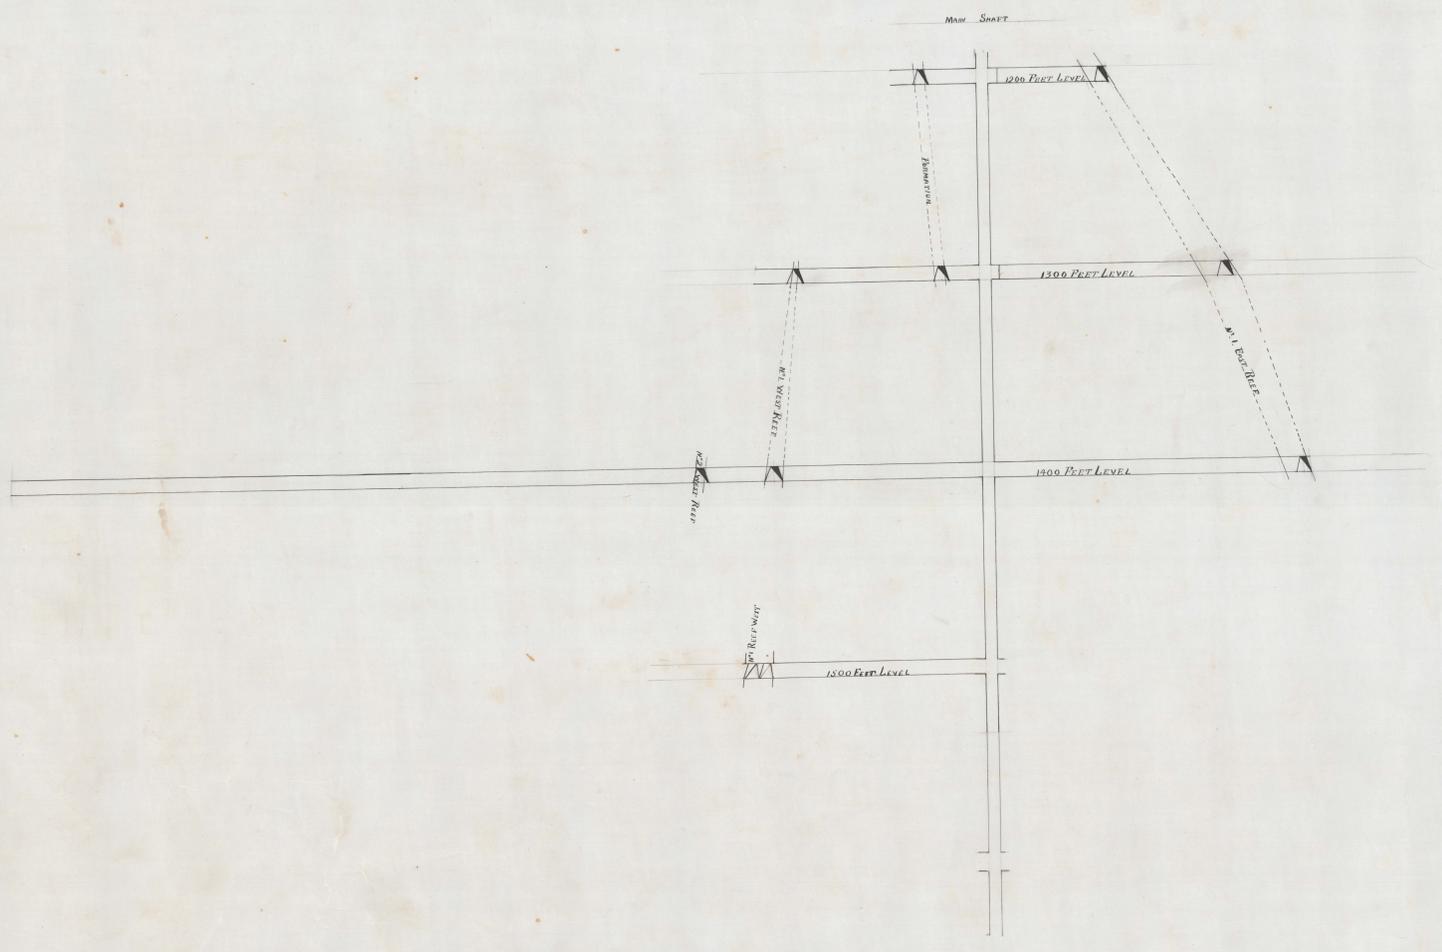


NEW GOLDEN GATE C M C

121-16

Scale 25 Feet to one Inch

CROSS SECTION

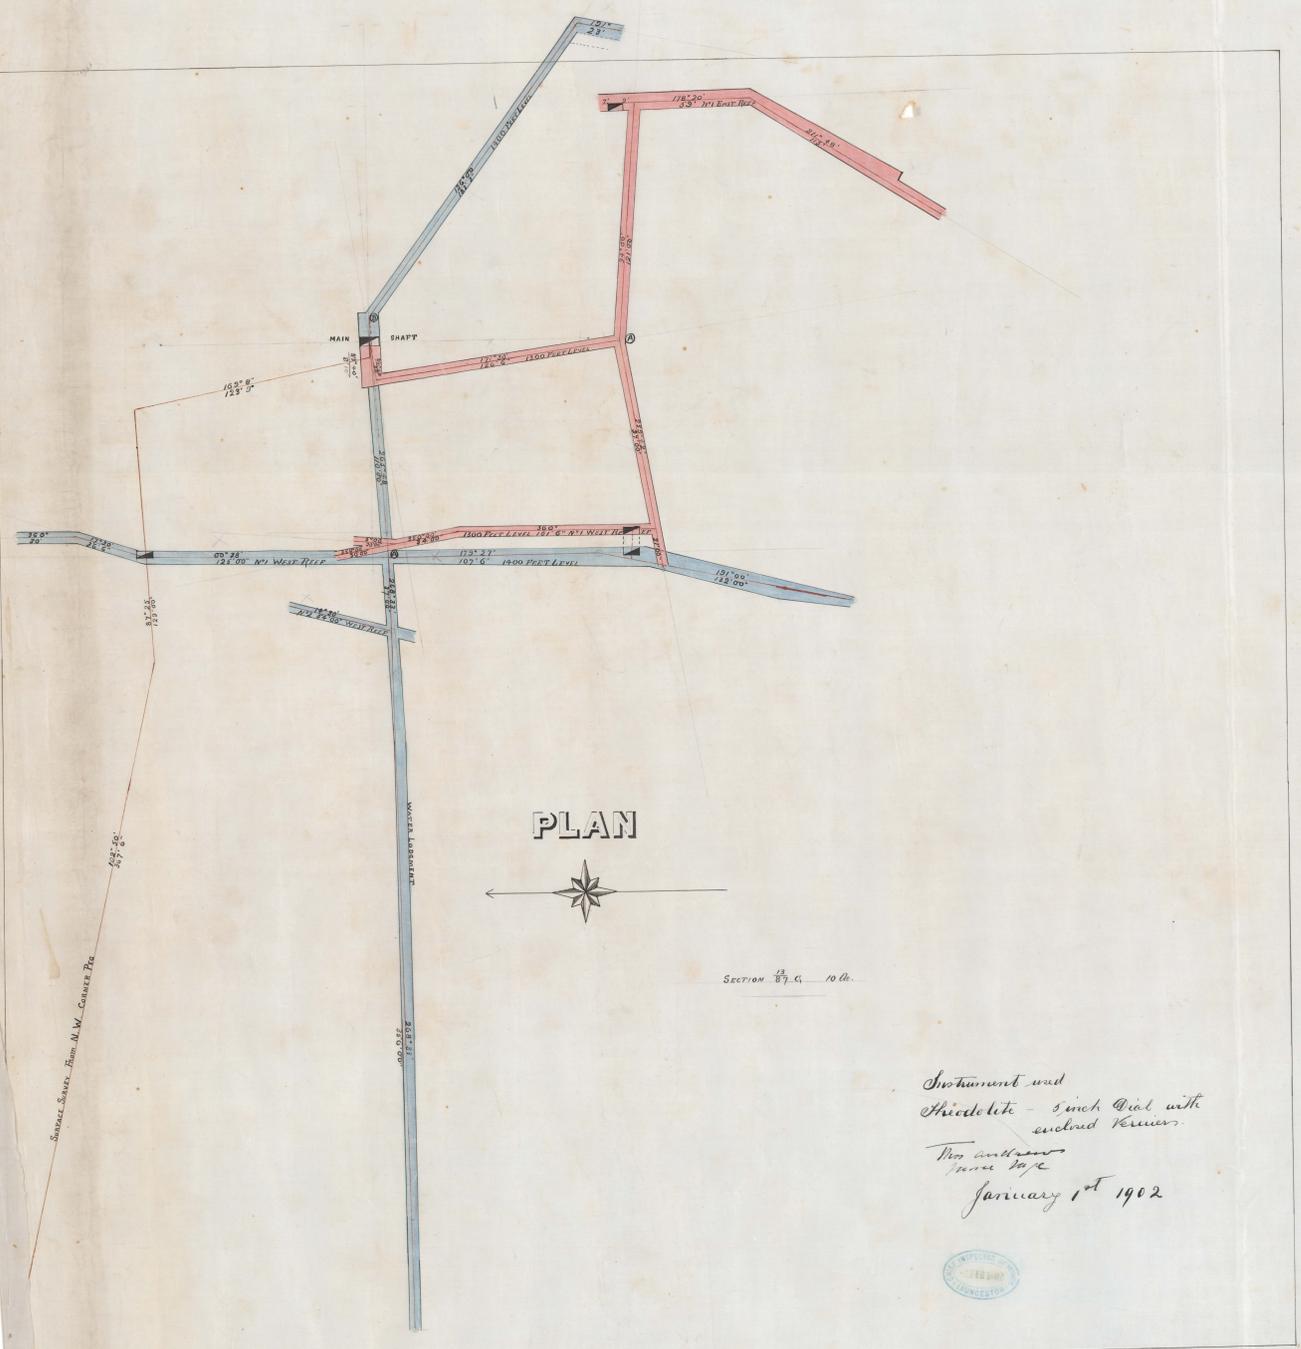

Section 1/2 G. 10 ft.

*Instrument used
 Prismatic - 5 inch Dial with
 enclosed Keiser.
 The angles
 were 10 ft
 January 1st 1902*

