


THE CHIEF INSPECTOR  
OF MINES  
LAUNCESTON

123-01

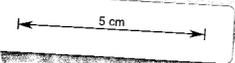

Eastern Proprietary

PLAN

OF UNDERGROUND WORKINGS

ON SECTION 56  
93M

L.G. THOMPSON AND P. BEHR LESSEES


COUNTY CORNWALL

PARISH OF FRAMPTON


SCALE 25 FEET TO 1 INCH

THEODOLITE USED

W. J. Burrows  
Authorised Mining Surveyor  
July 1<sup>st</sup> 1901

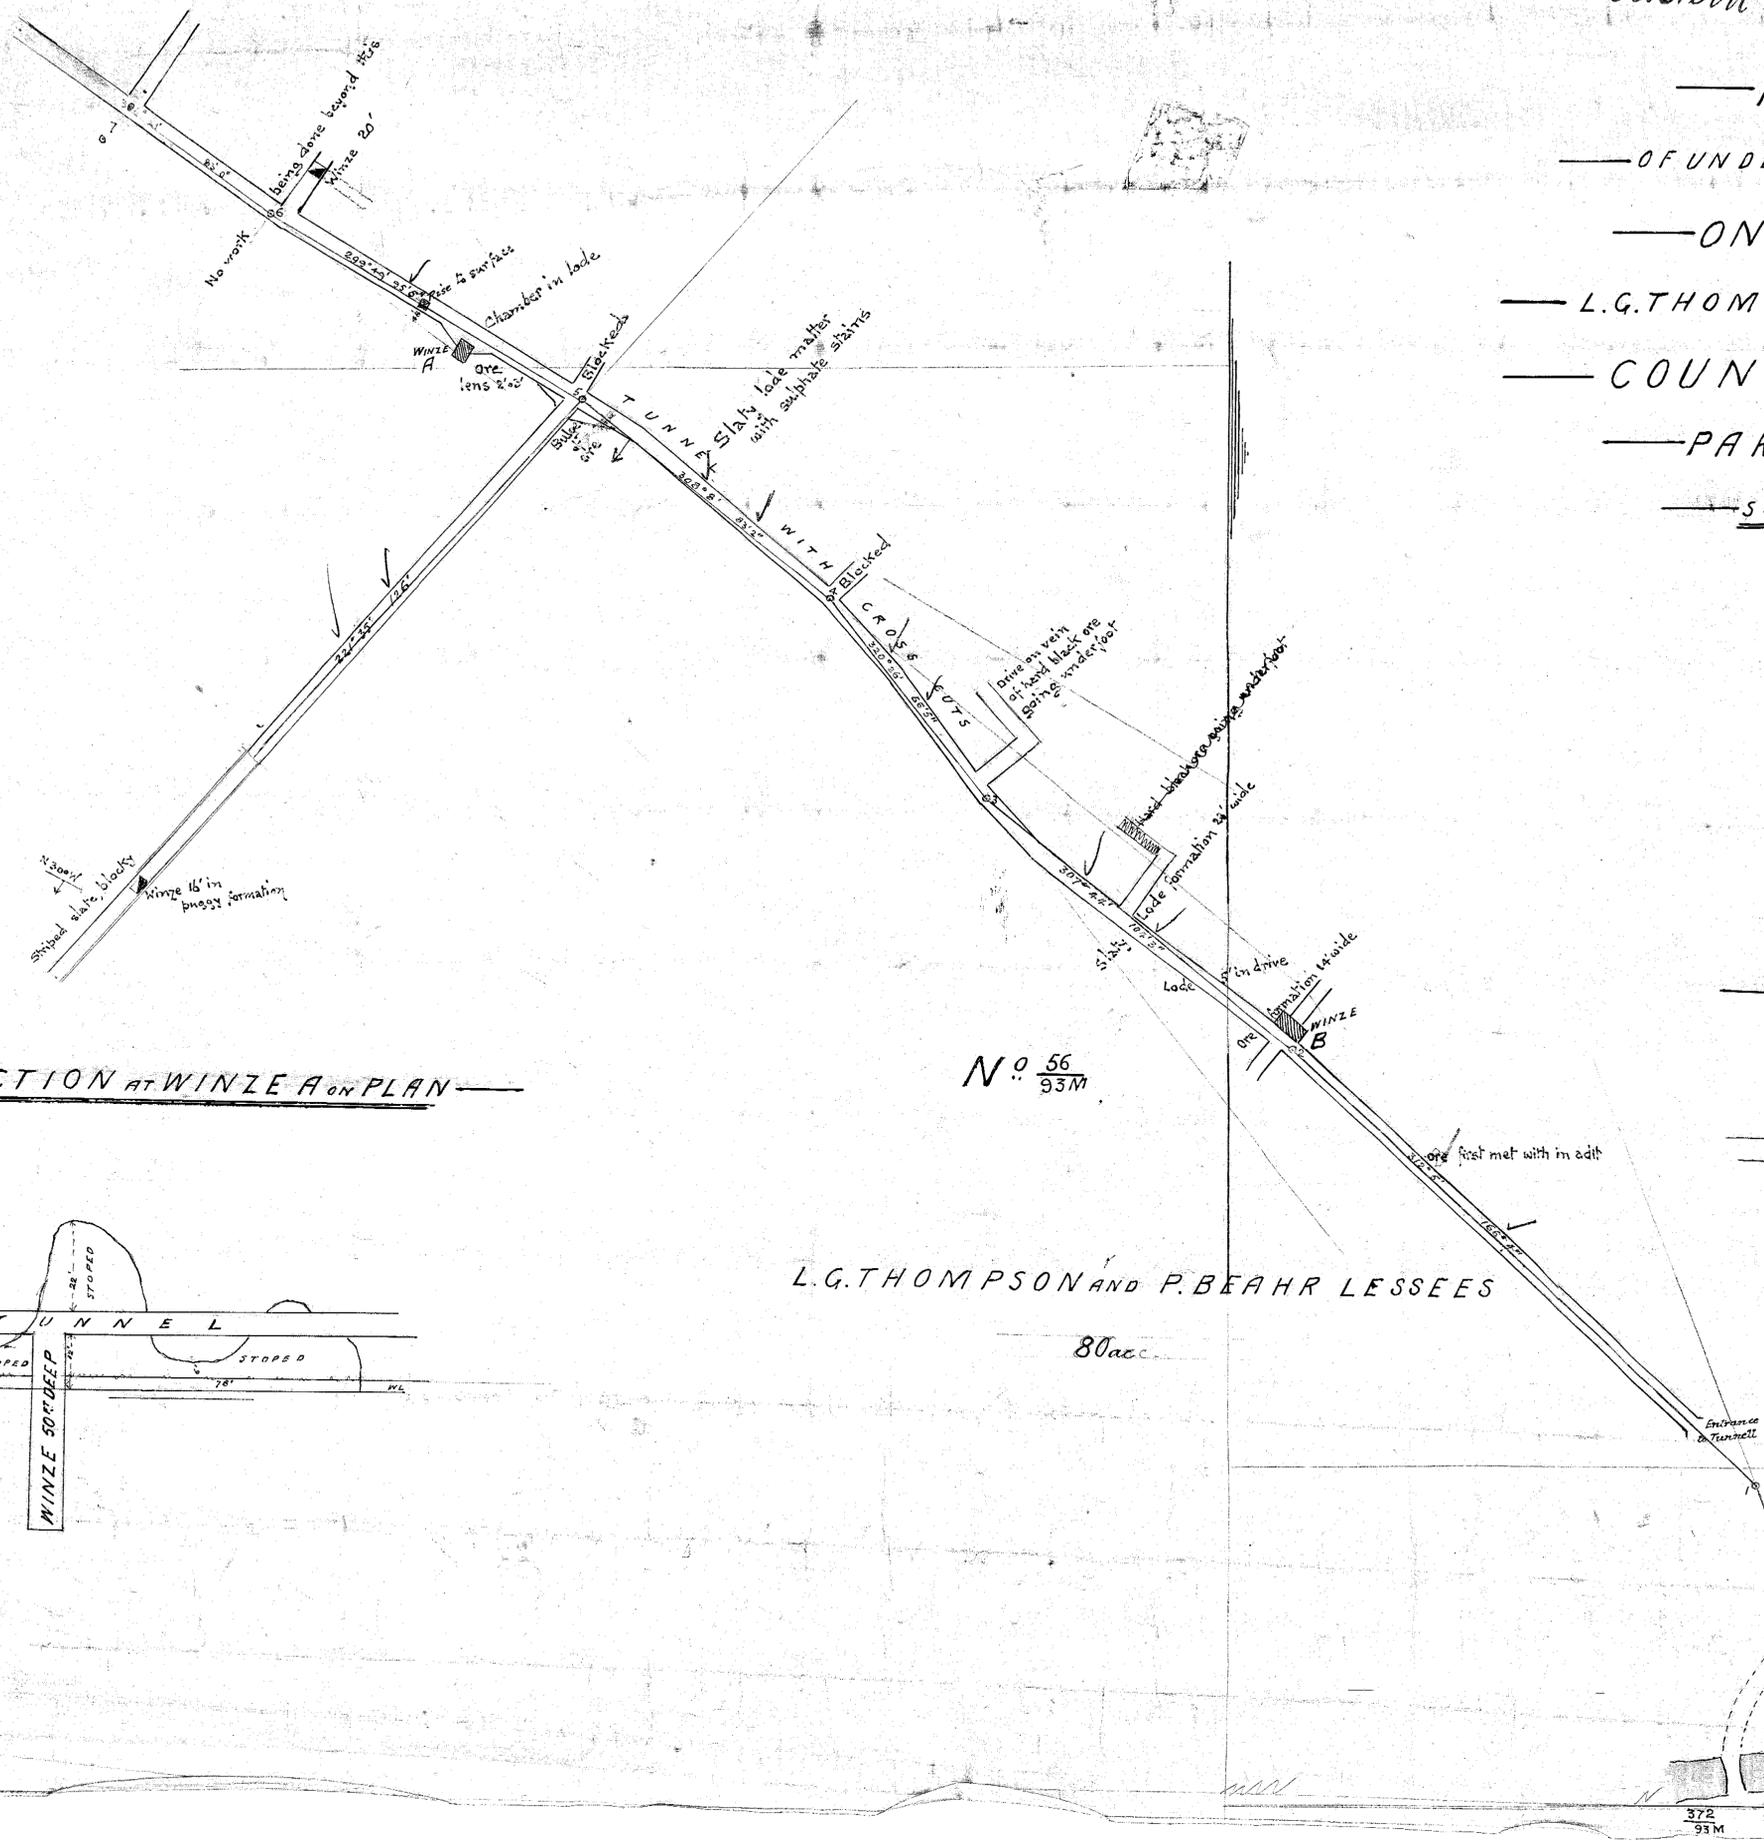

SECTION AT WINZE A ON PLAN

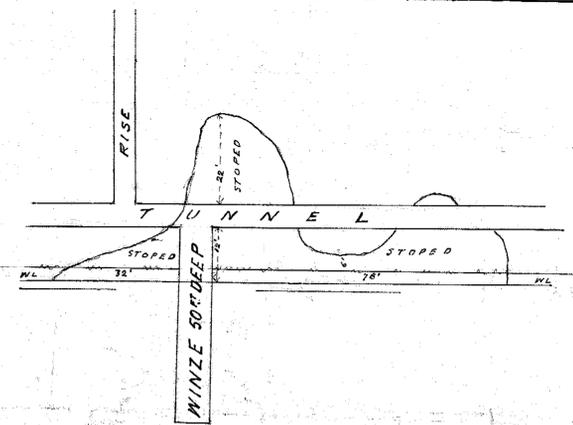


N. 56  
93M

L.G. THOMPSON AND P. BEHR LESSEES

80acc

SECTION AT WINZE

B ON PLAN

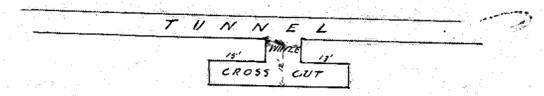

53