

123-02 5cm

COUNTY OF CORNWALL
PARISH OF FRAMPTON


Plan of Workings

ON SECTION 56
93M

L G Thompson & P Beahr, Lessees

Scale 25 feet to an inch

30th June
1896

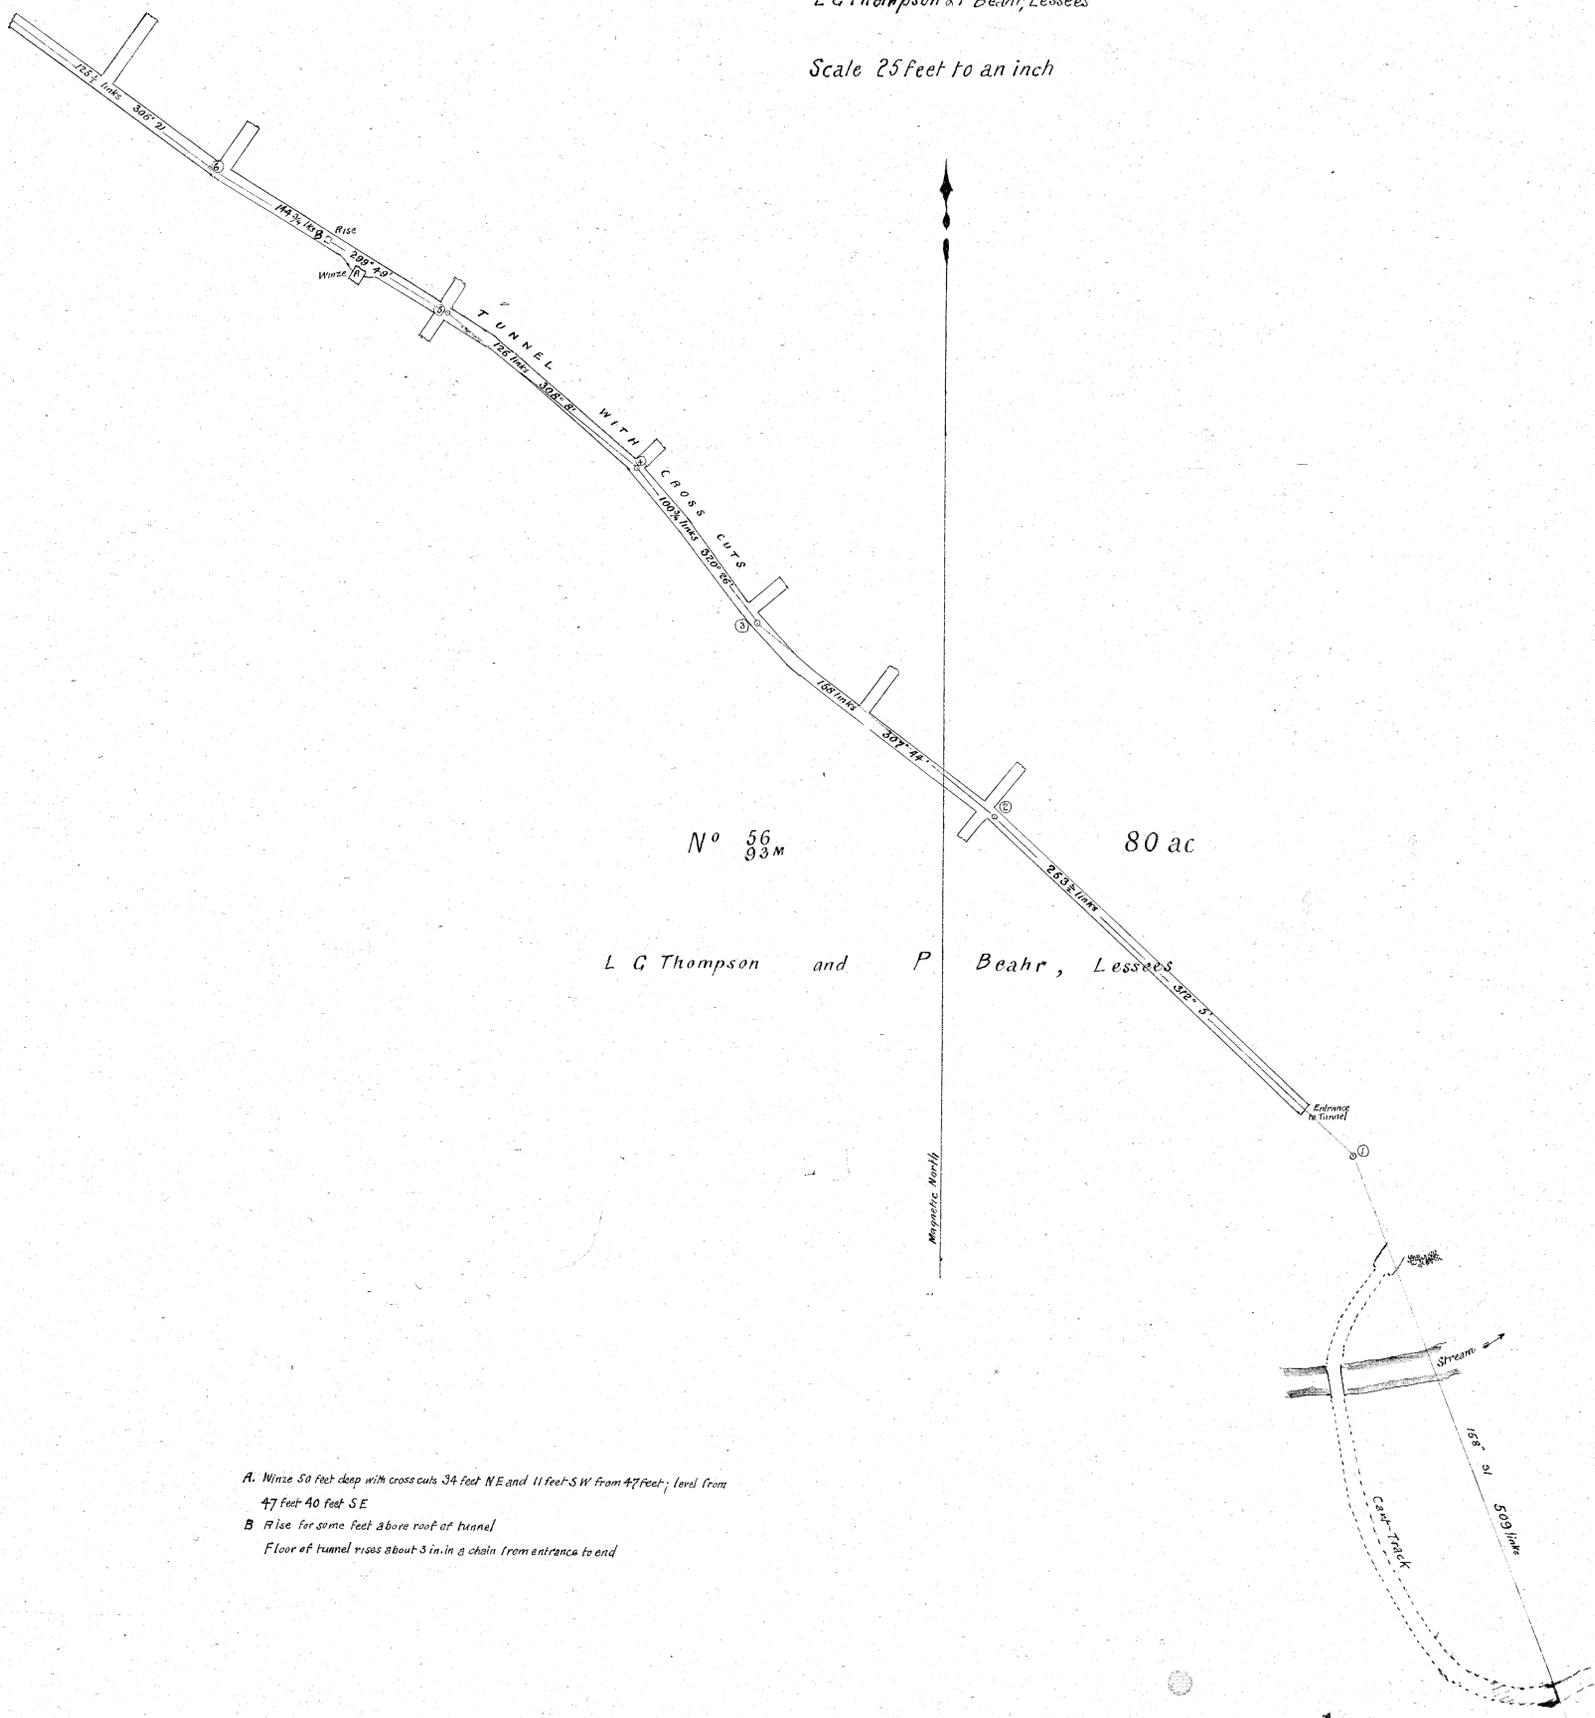

- A. Witze 50 feet deep with cross cuts 34 feet NE and 11 feet SW from 47 feet; level from 47 feet 40 feet SE
 - B. Rise for some feet above roof of tunnel
- Floor of tunnel rises about 3 in. in a chain from entrance to end

30th June 1896
G. G. G. G.

372
93 M

57
93 M
Paul Beahr