

SUNBEAM



MINE

SCALE 25 FT = 1 INCH

PLAN

CROSS SECTION

LONGITUDINAL SECTION

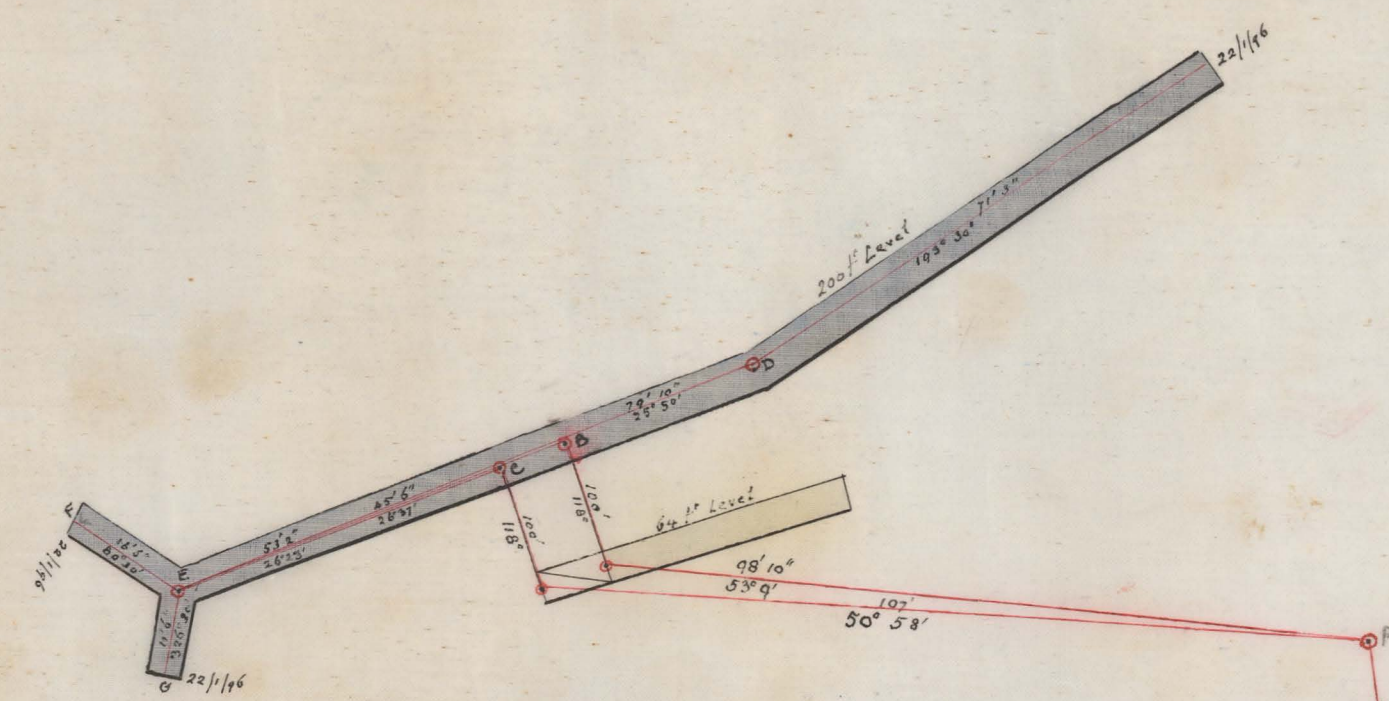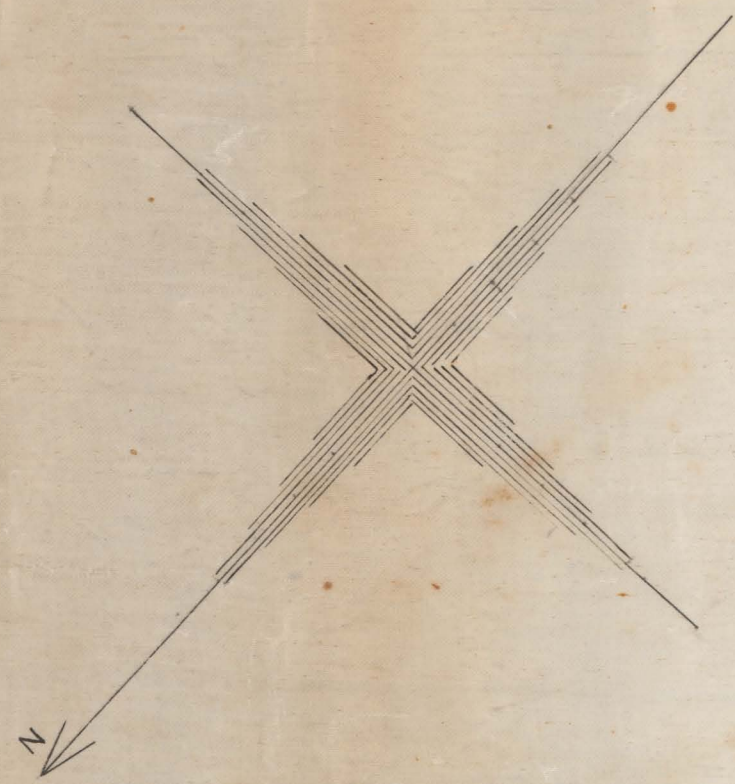


37L 90C

150' 0"


90' 0"

0 100

EAST

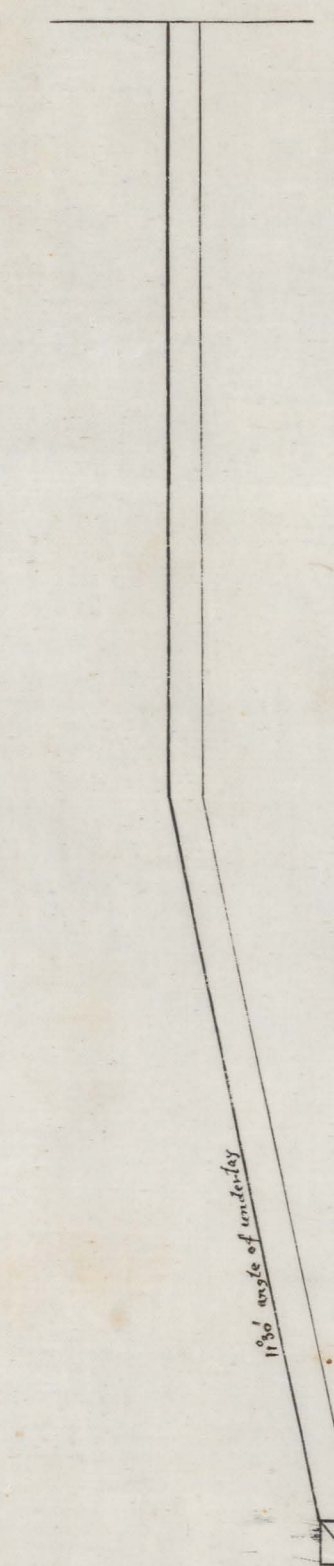

NORTH

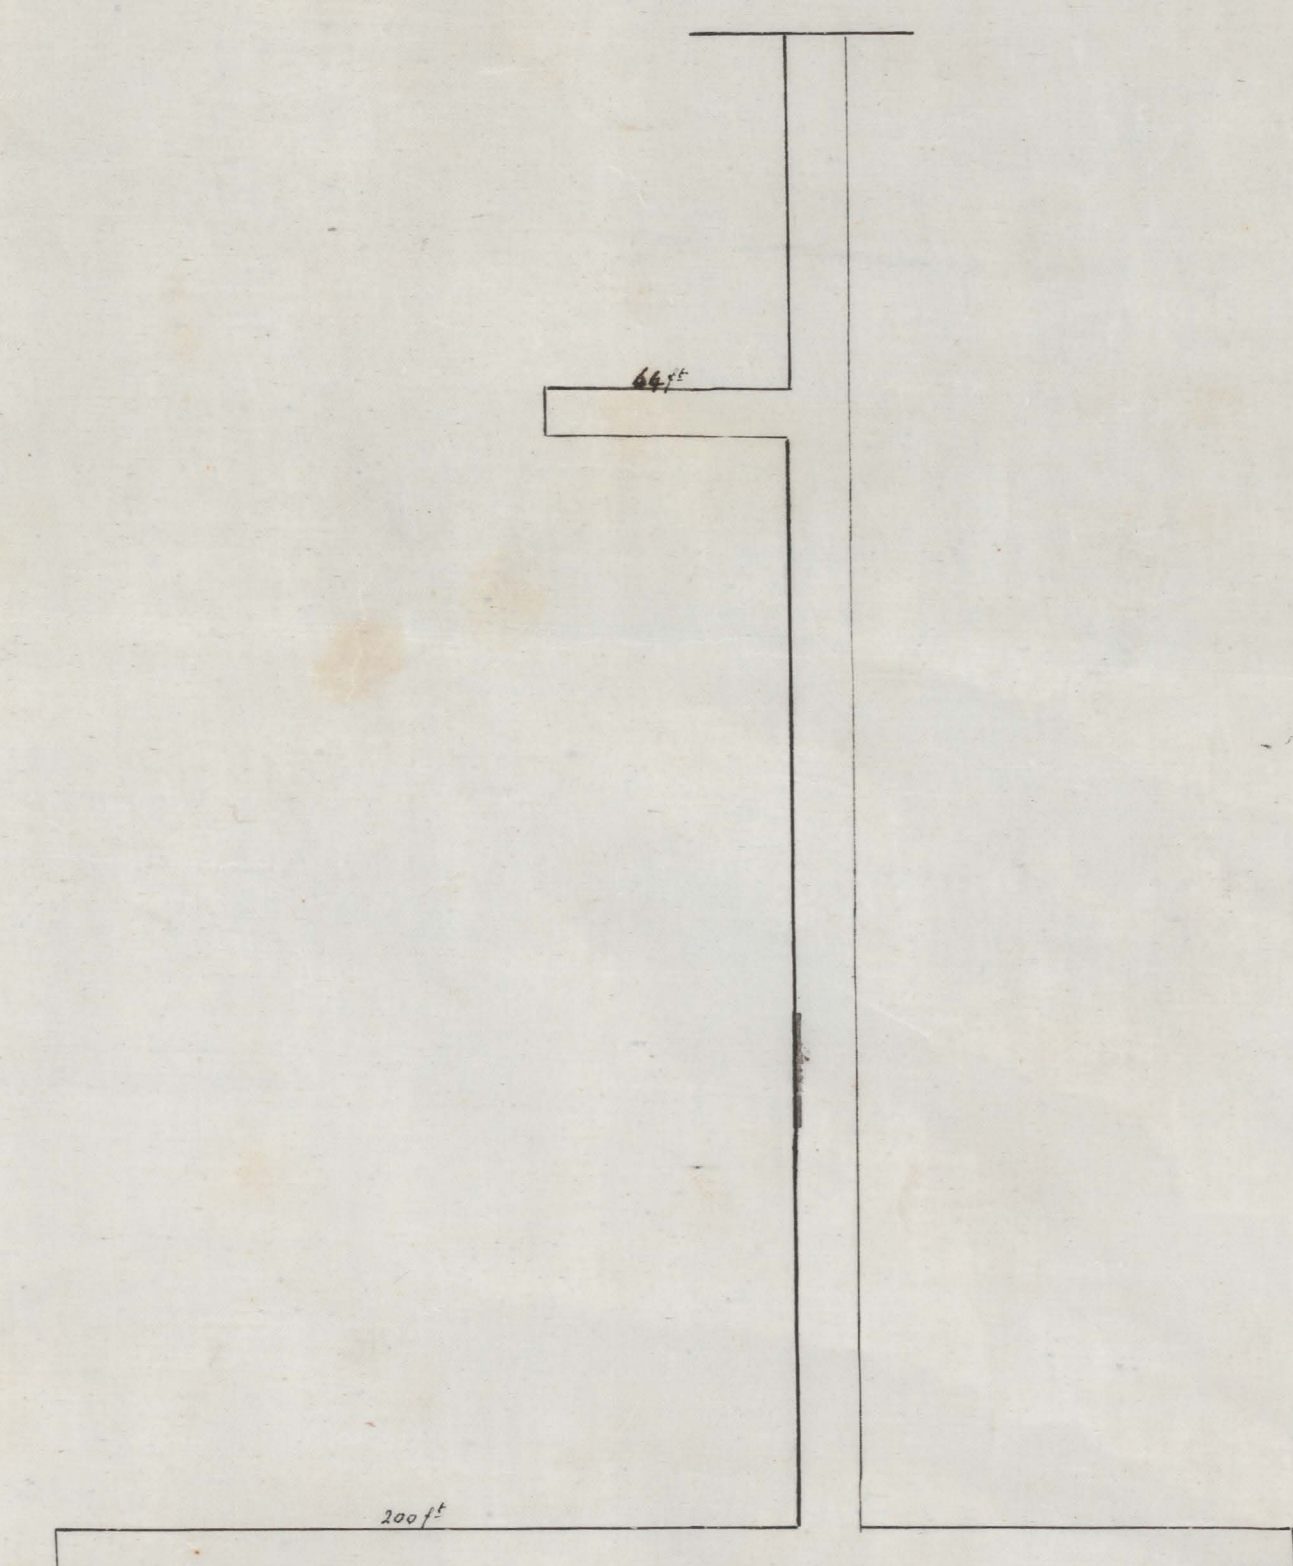

Surveyed and drawn by A Dickinson ARSM
Instrument used Theodolite



BUREAU & TWILIGHT
SHEPHERD COY. LIMITED
MATHURIN, TASMANIA

124-91

124