

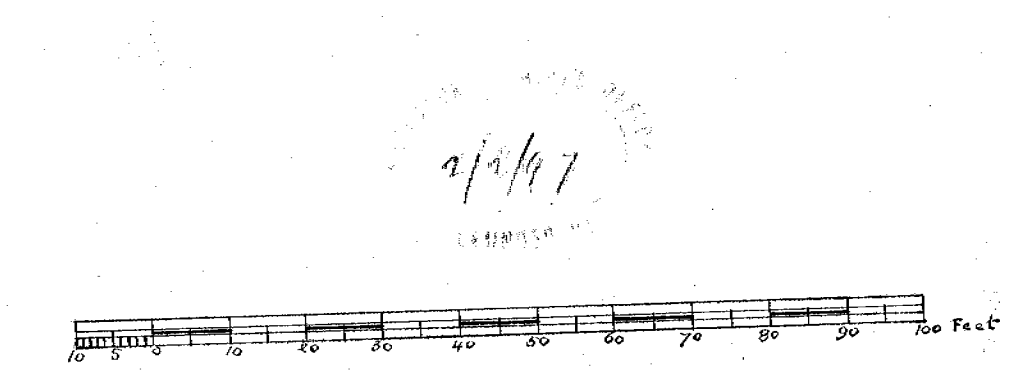
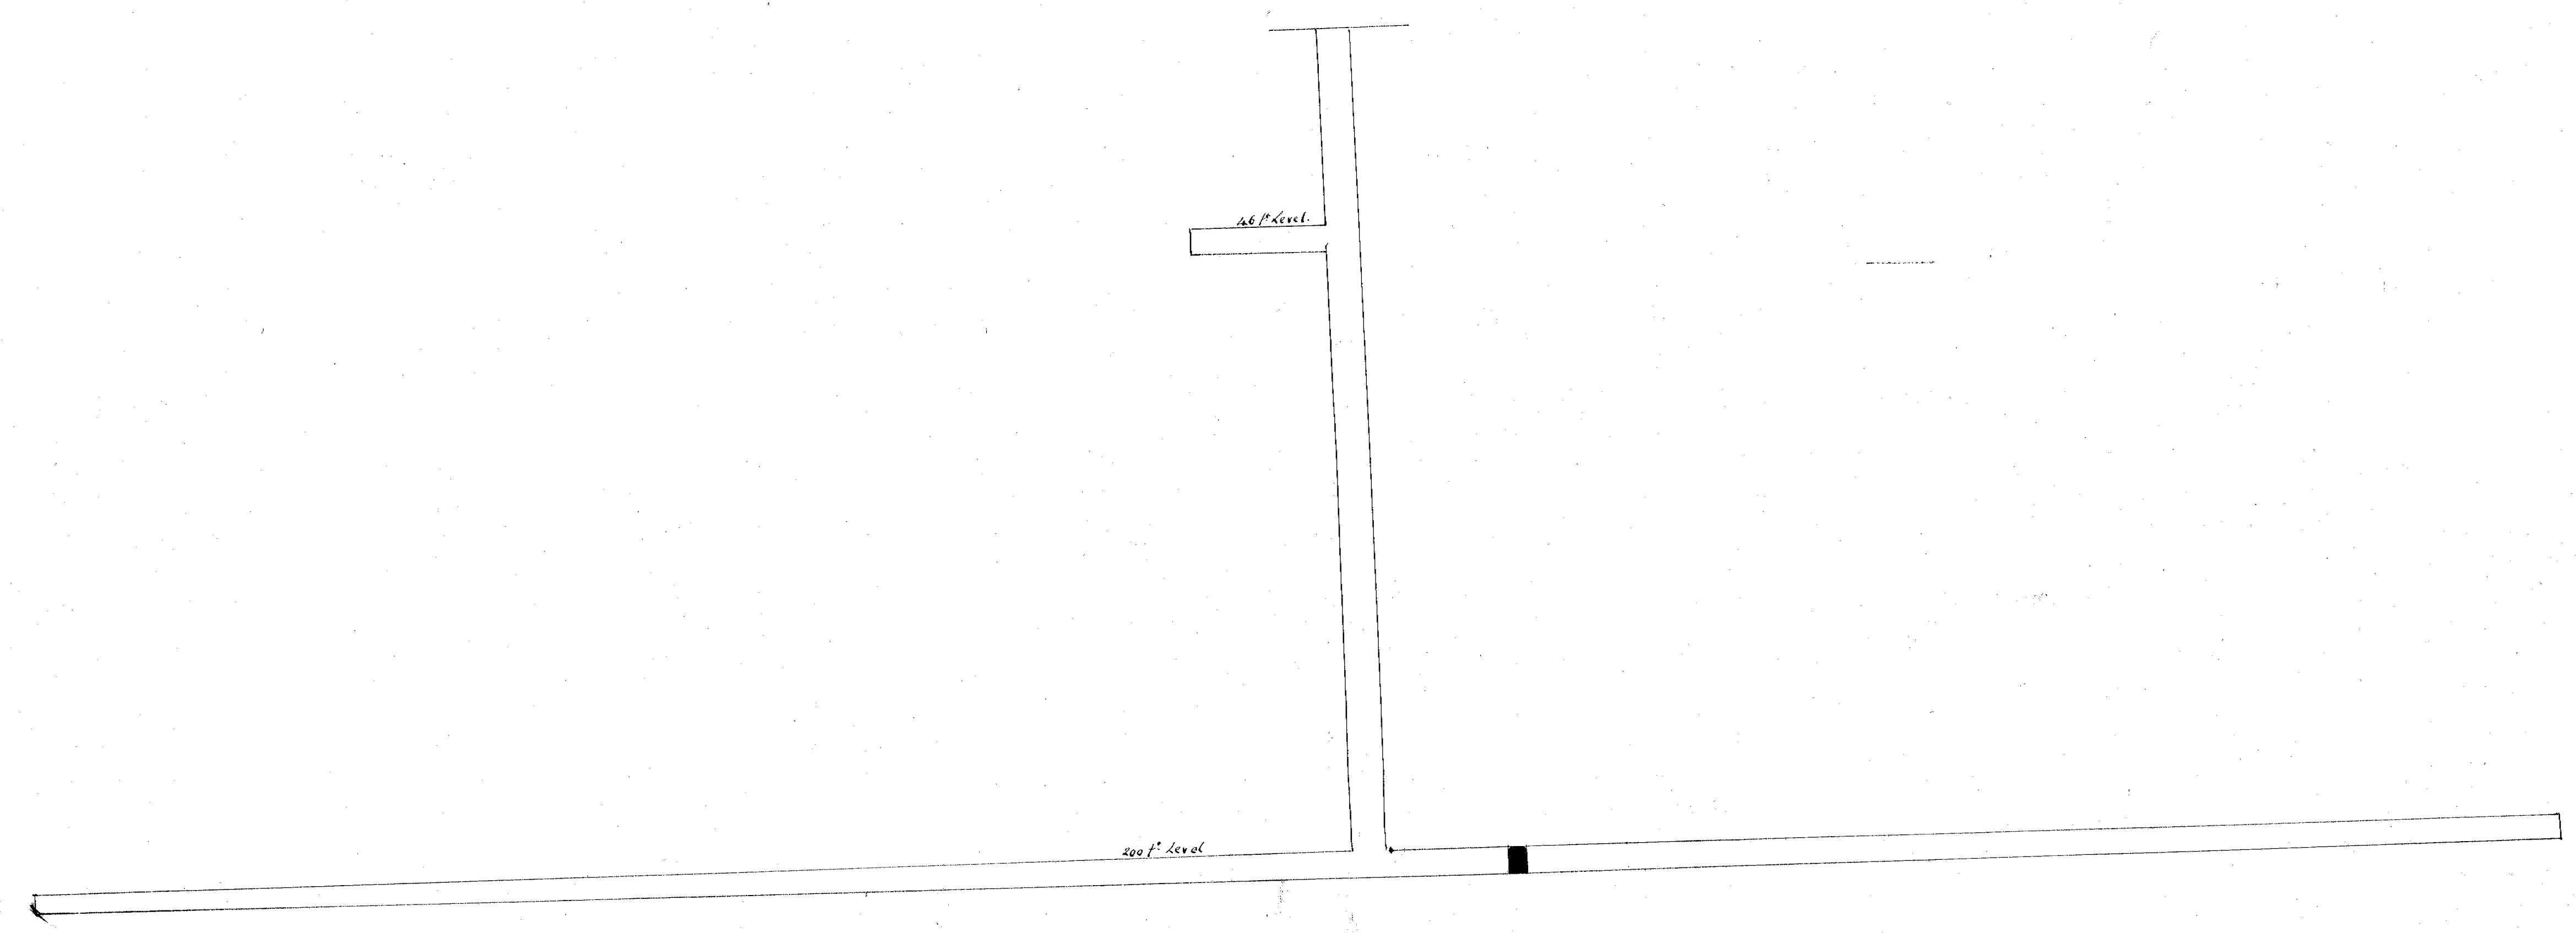


132
Sunbeam

LONGITUDINAL SECTION

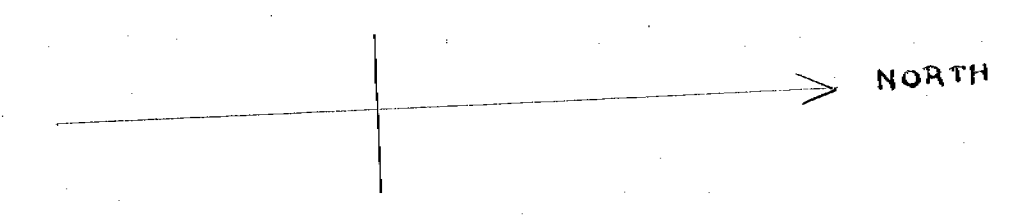

124-02

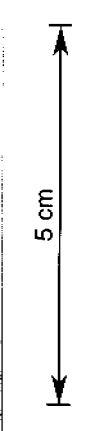

124-02