
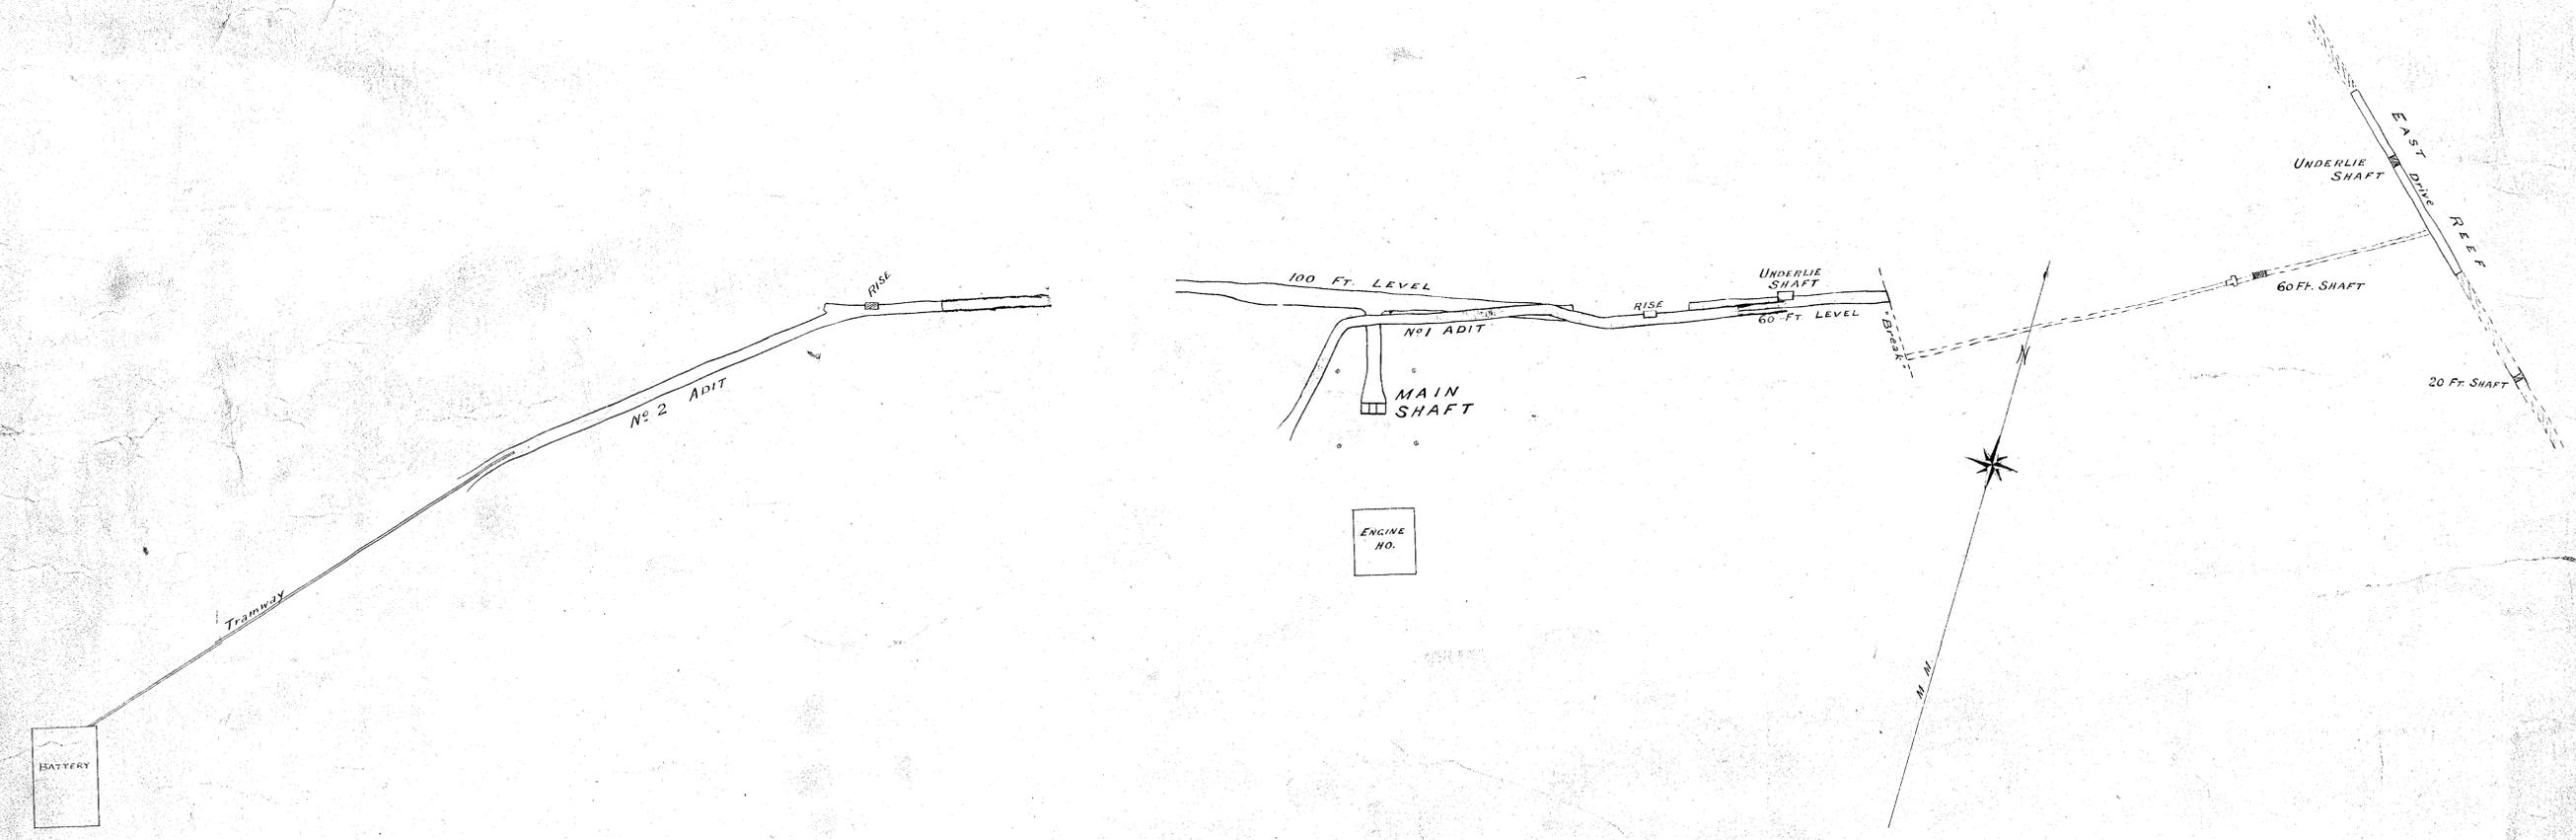


LEBRINA GOLD MINES N.L.

LEBRINA - TASMANIA.

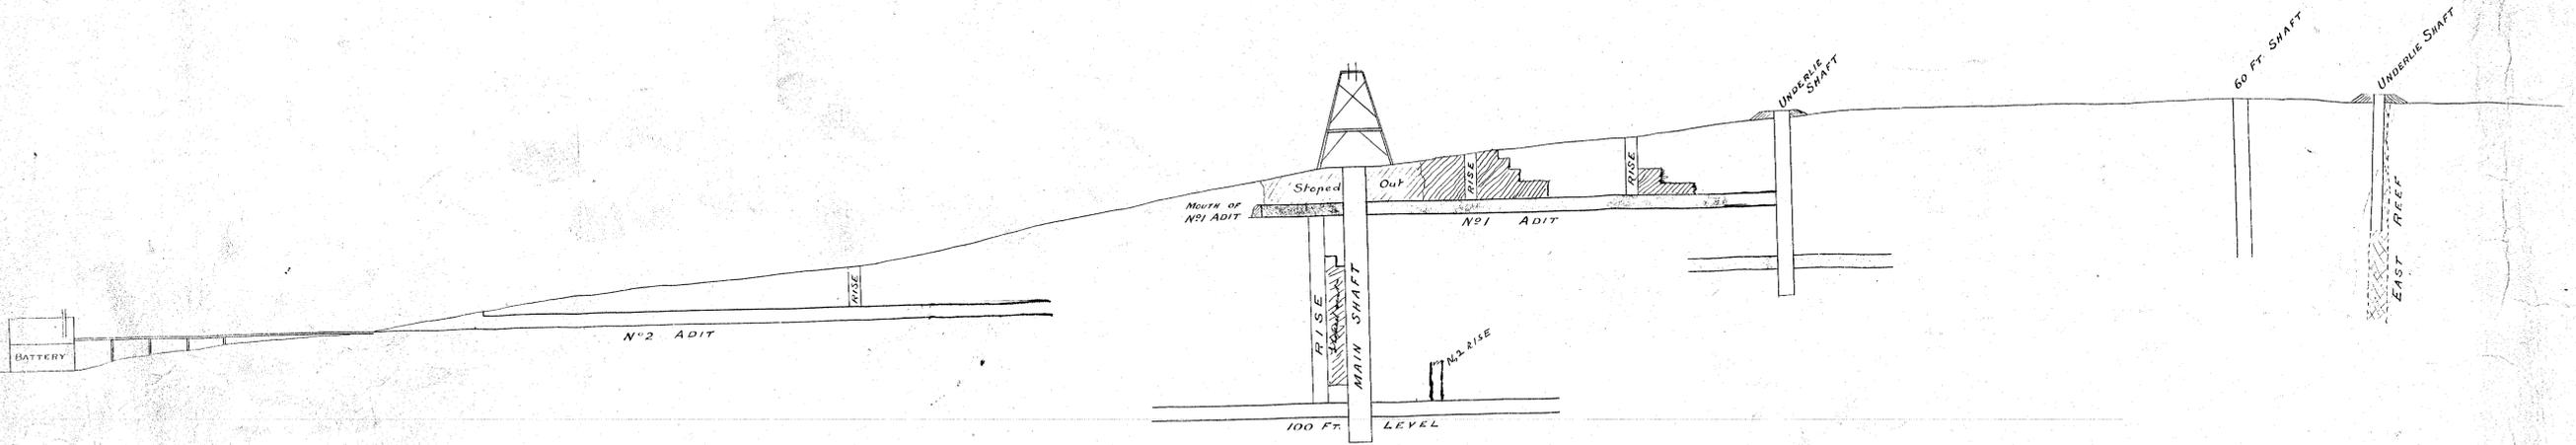

Scale : 30 Feet to 1 Inch.

B. Allen, B.E.
Mining Engineer
MELBOURNE.
12/10/1913

Brought up to Dec 31/1913
J. Allan
Mine Manager



571

125-9