

96

126-01

5 cm




126-01

MERCURY GOLD MINING COMPANY REGISTERED,

NO LIABILITY

Plan of Underground Workings,

Line of level from surface showing 2nd & 3rd.

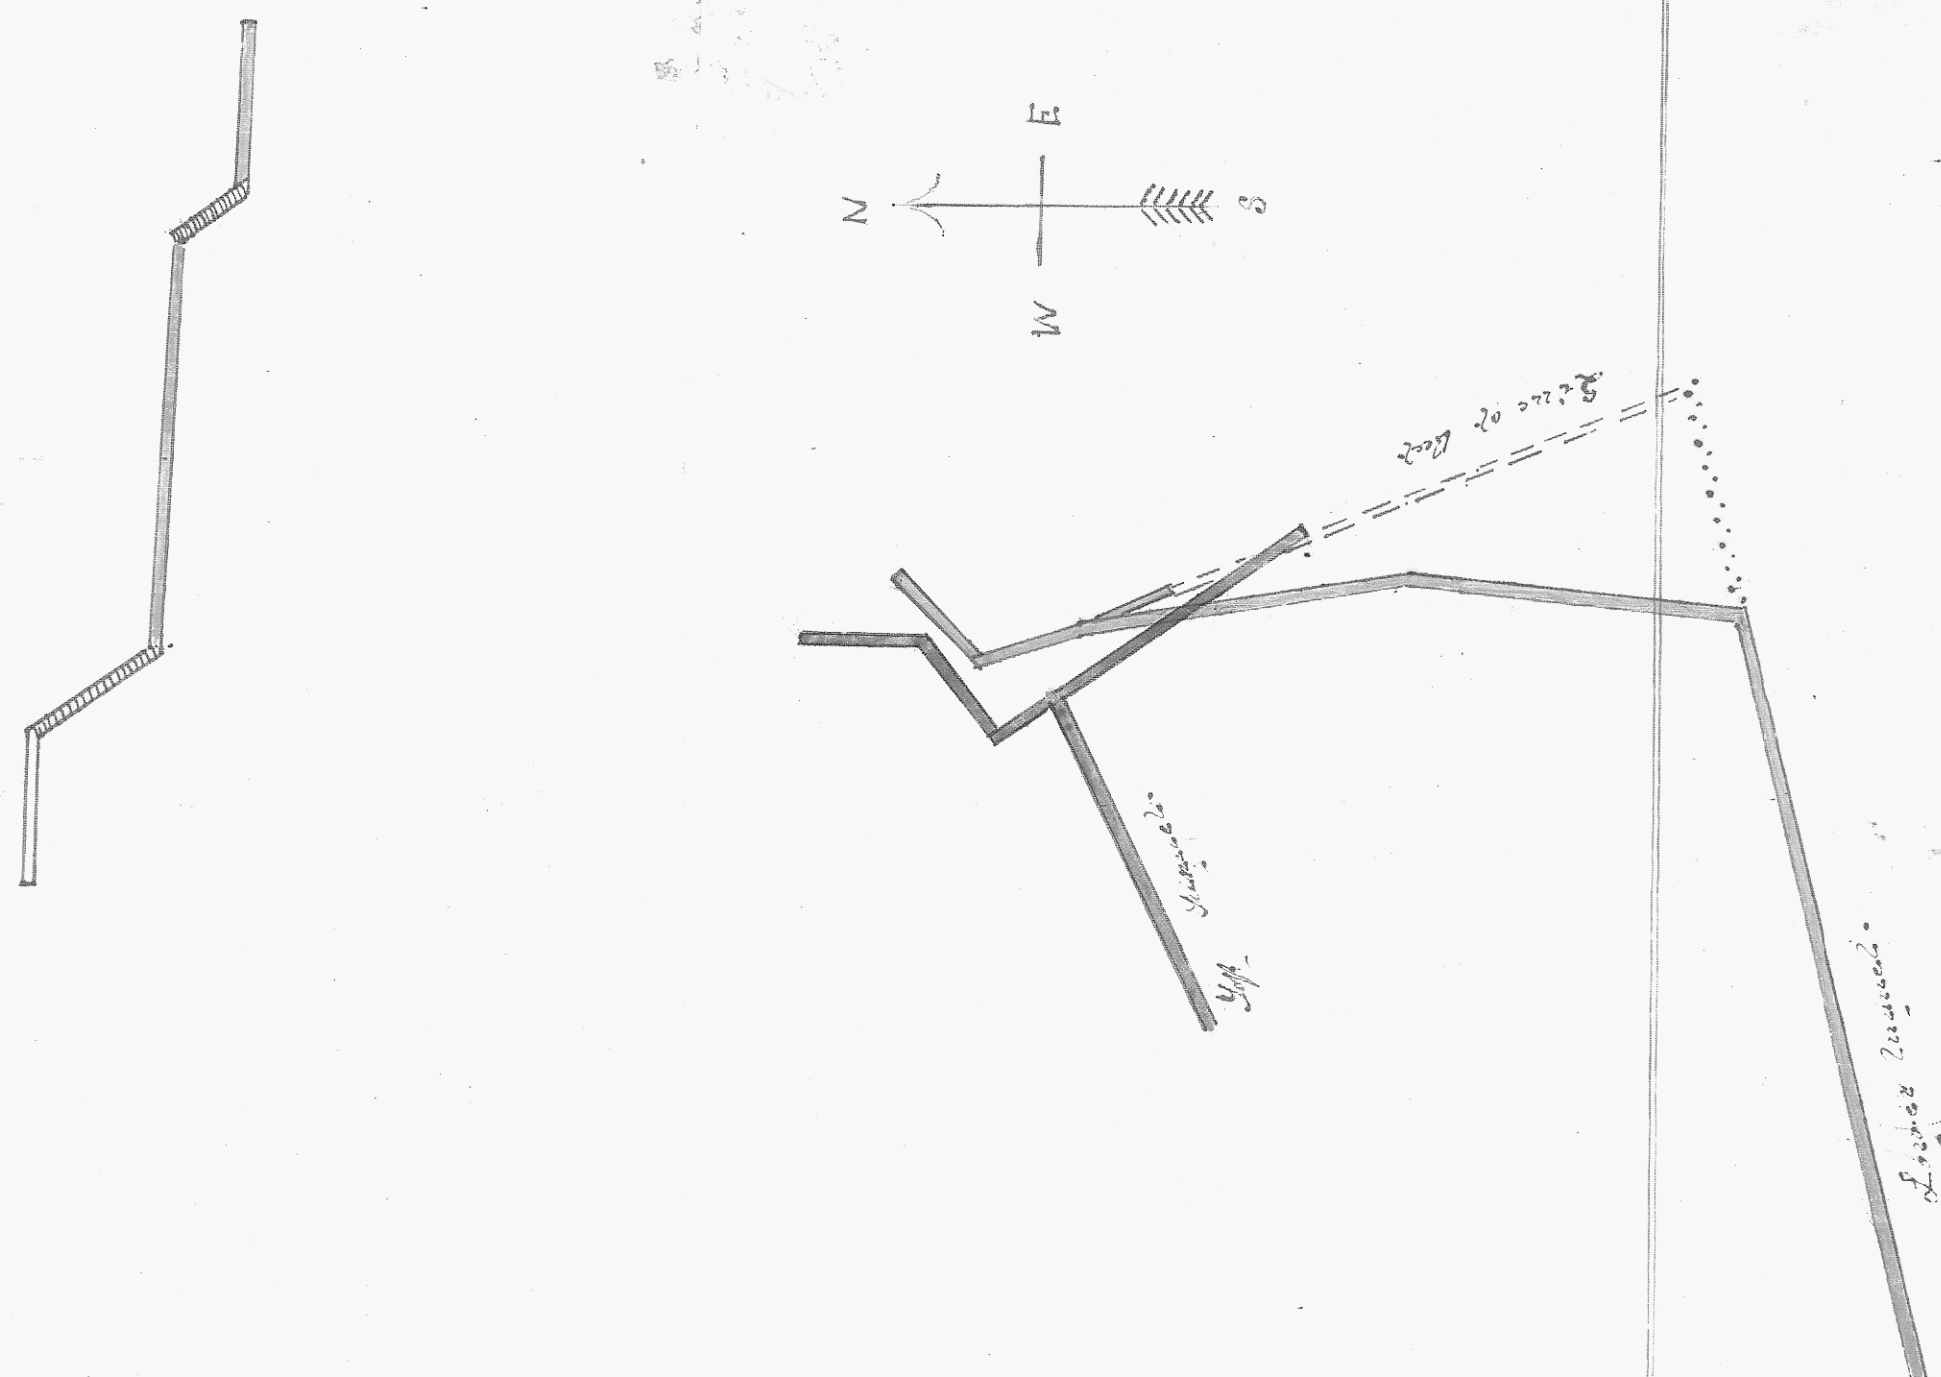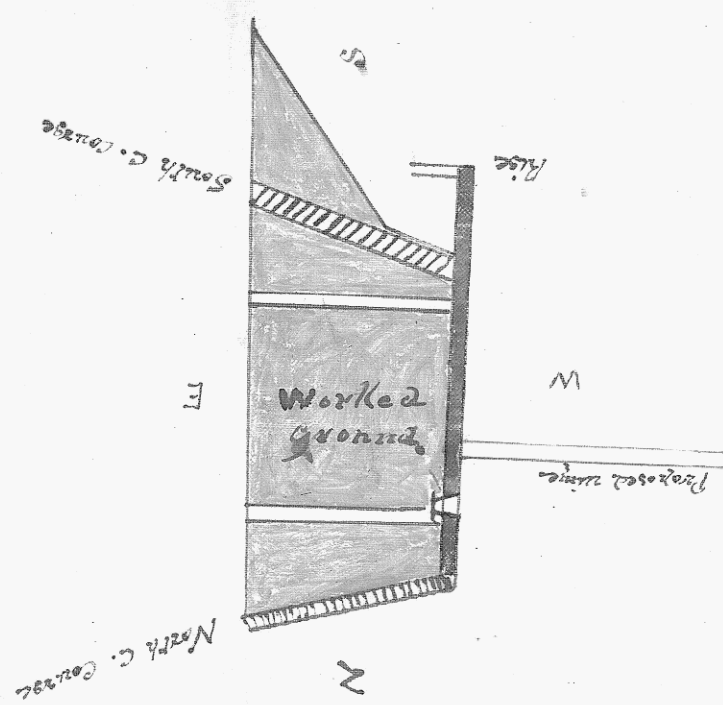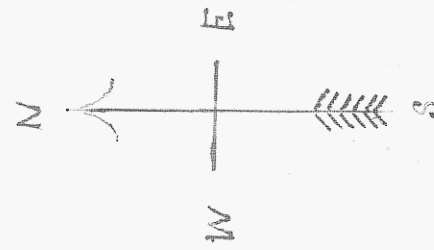

Scale 1 inch = 20 feet



Mine Manager's (Young's) Plan of Underground workings of the Mercury Mine, made about July 1890 showing workings then open. There are a lot of old workings not now in a state to be surveyed of which no plans have been kept. This plan given to me by Mr. Aug. Simson 25th March 1890 and accepted in lieu of the regular surveyor's plan required by the Act, which could not be got in this case no underground workings having been made during 1890.

A. Montgomery
Supt. of Mines
25th March 1890