

PLAN OF UNDERGROUND SURVEY

RINGAROOMA UNITED GOLD MINING COMPANY

NO LIABILITY
ALBERTON

Scale 40 feet to one inch.

Survey made with 5 inch transit theodolite
Donald Fraser
Authd. Surveyor
26th October 1923

1590
G

8ac.

J. C. Matthews

G. L.

1551
G

10ac.

J. W. Mitchell

G. L.

1260
G

20ac.

1616
G

1ac.

J. C. Matthews

G. L.

1443
G


10ac.

Ringarooma United Gold Mining Co. N. L.

G. L.

J. W. Mitchell

G. L.

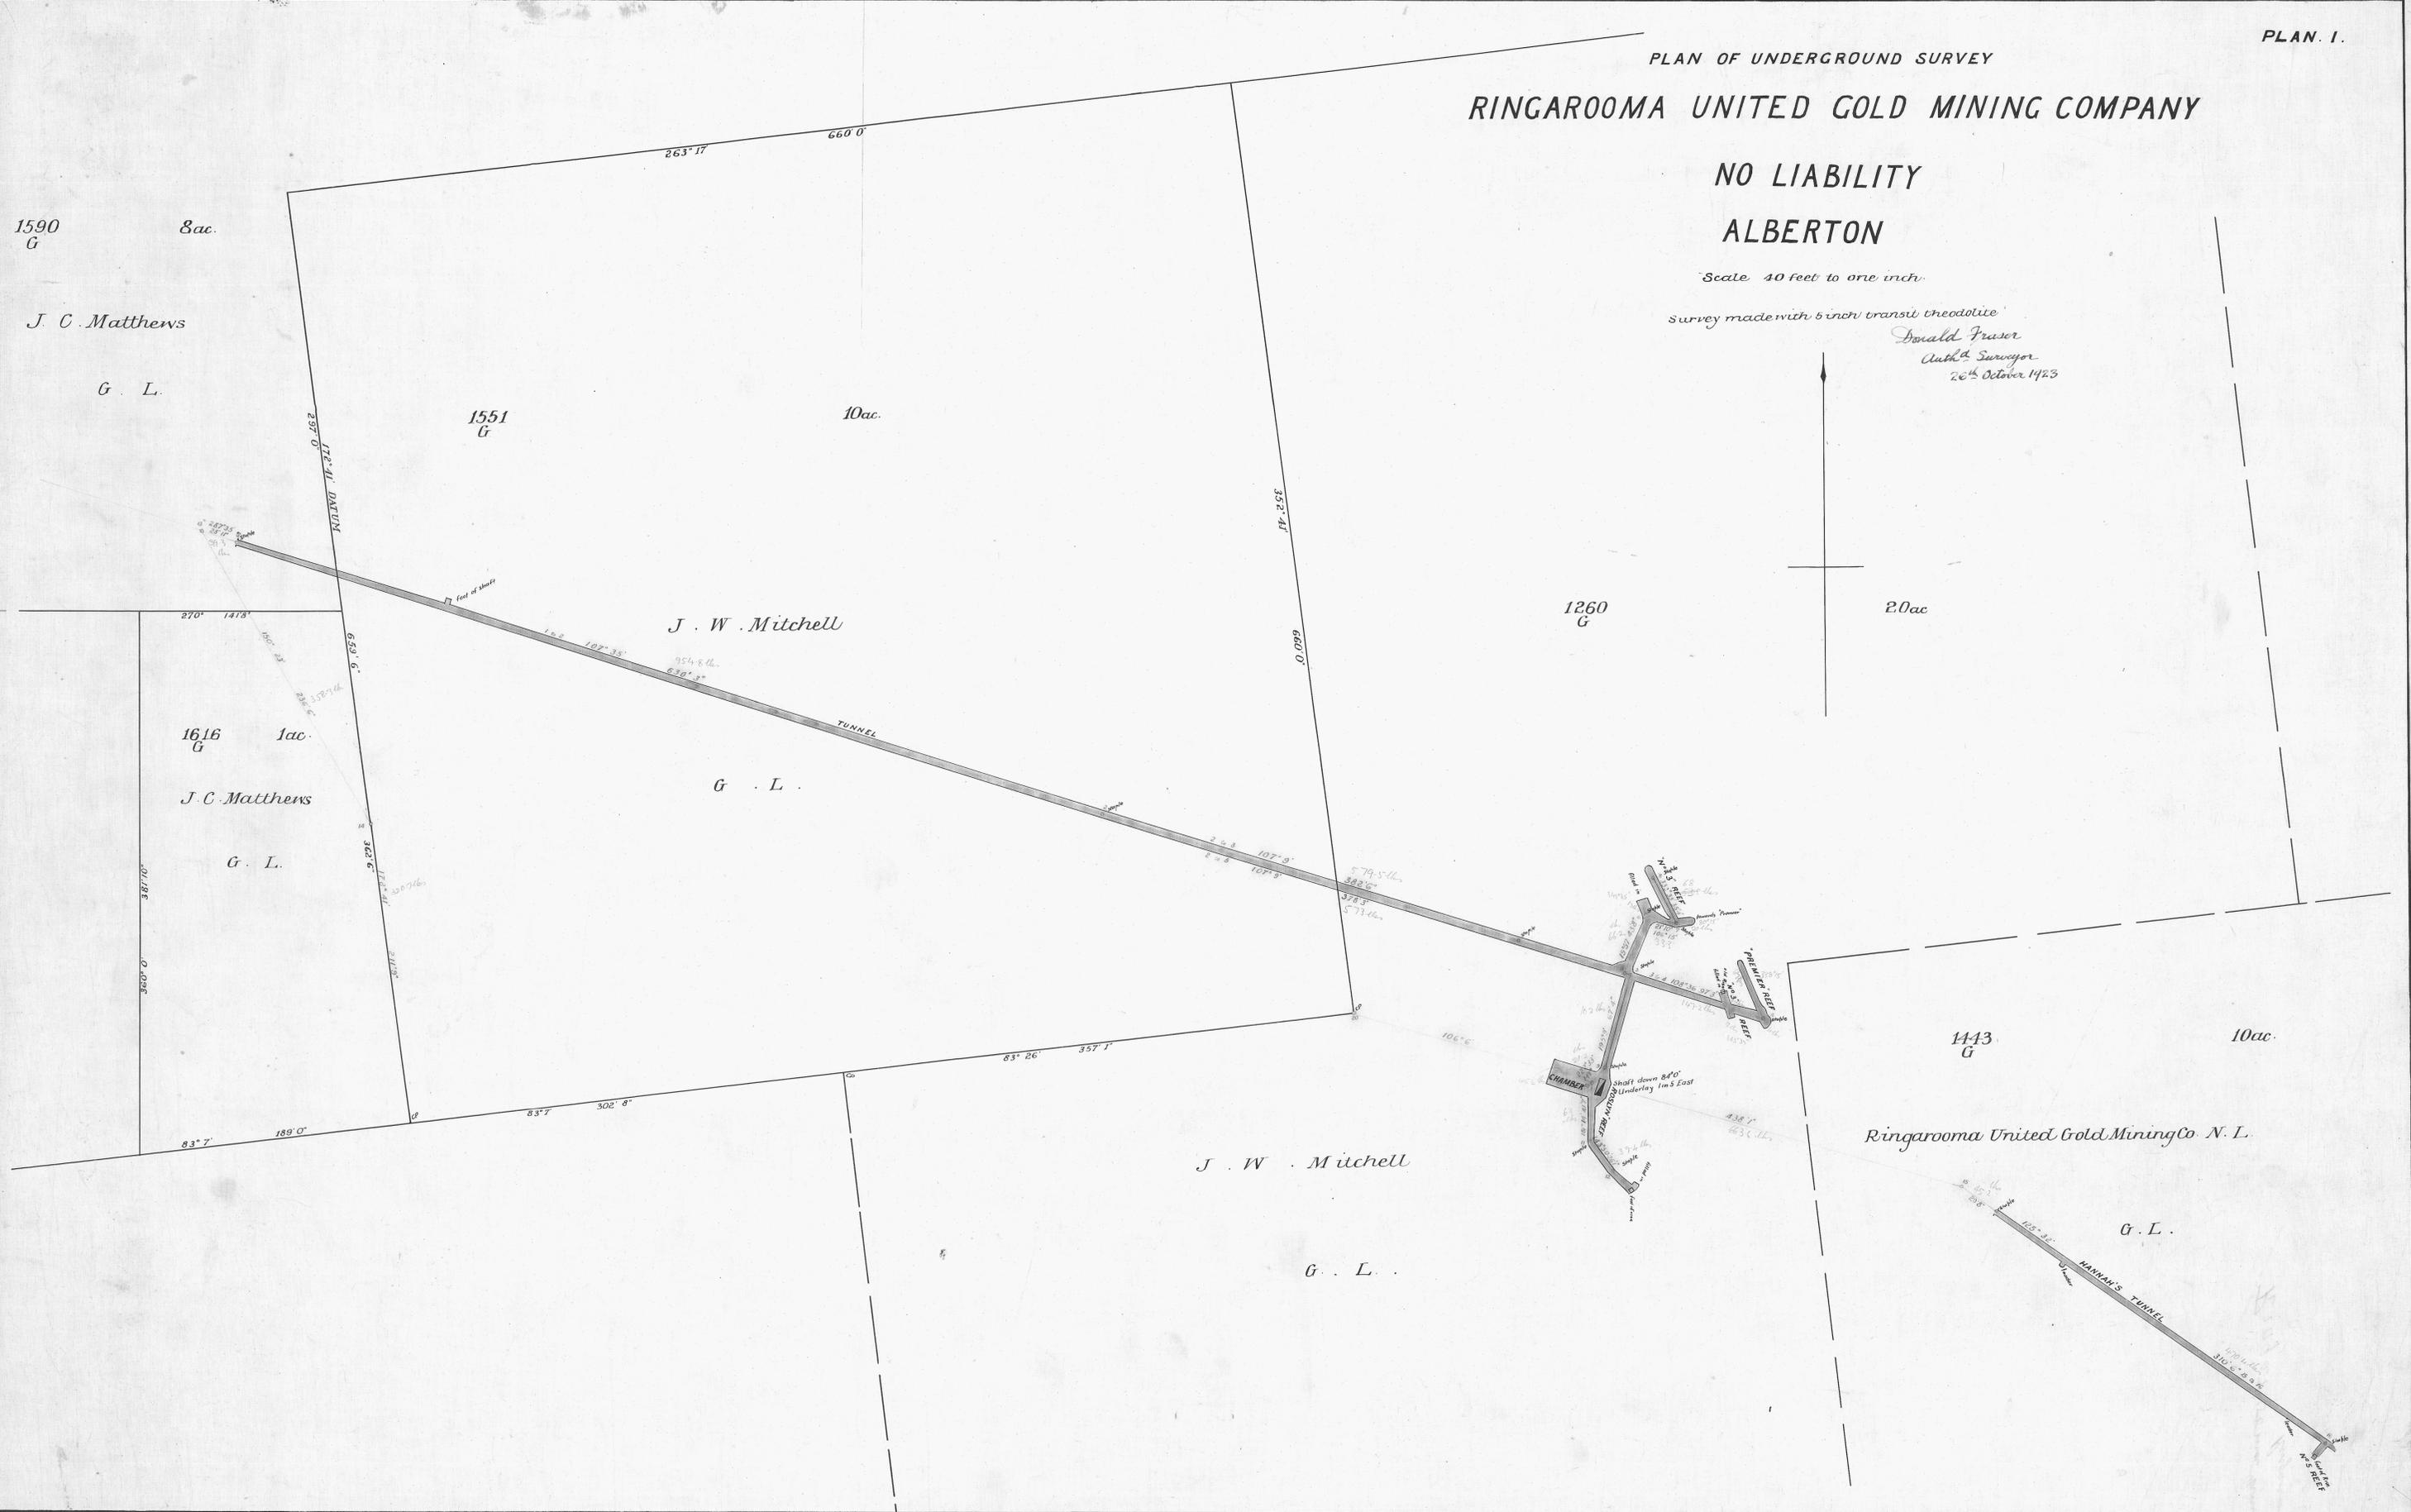

5m

127-01

9/10
22-10-22