
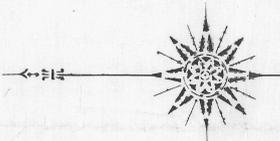


— RINGAROOMA G. M. CO. —
LIMITED


— NEW RIVER MINE WORKINGS —
COUNTY OF DORSET
PARISH OF ALBERTON

SCALE

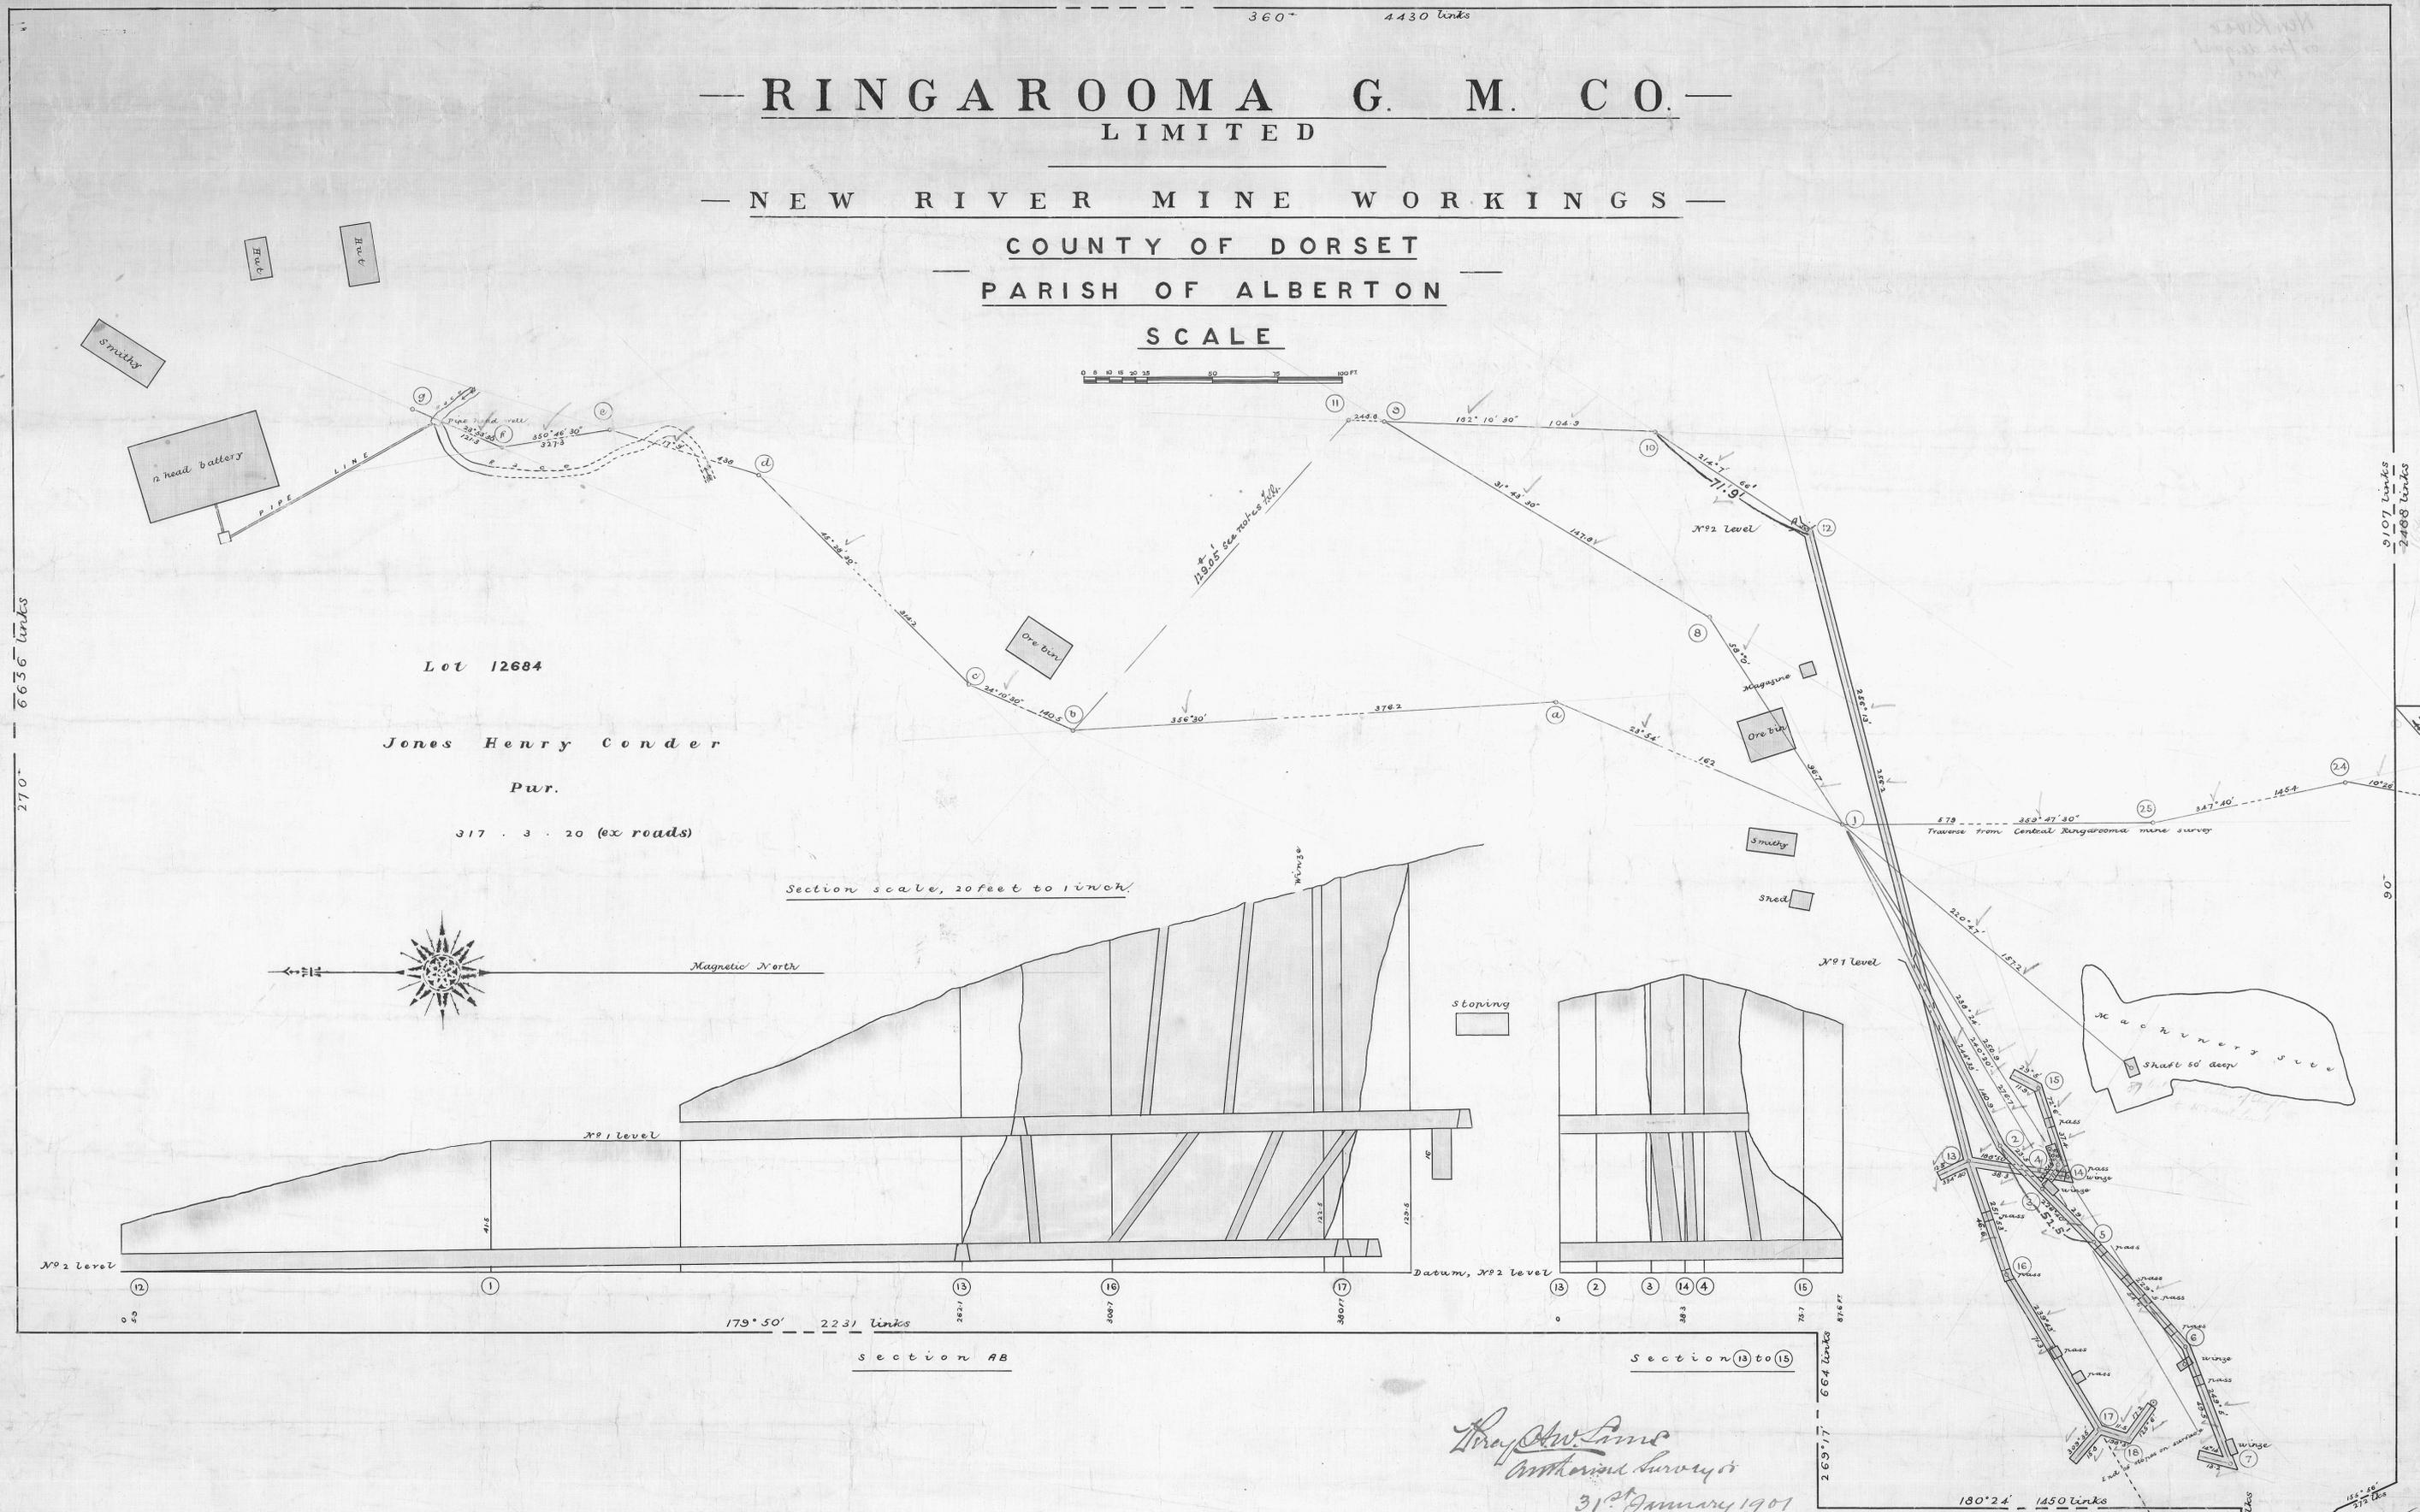

Magnetic North

Section scale, 20 feet to 1 inch.

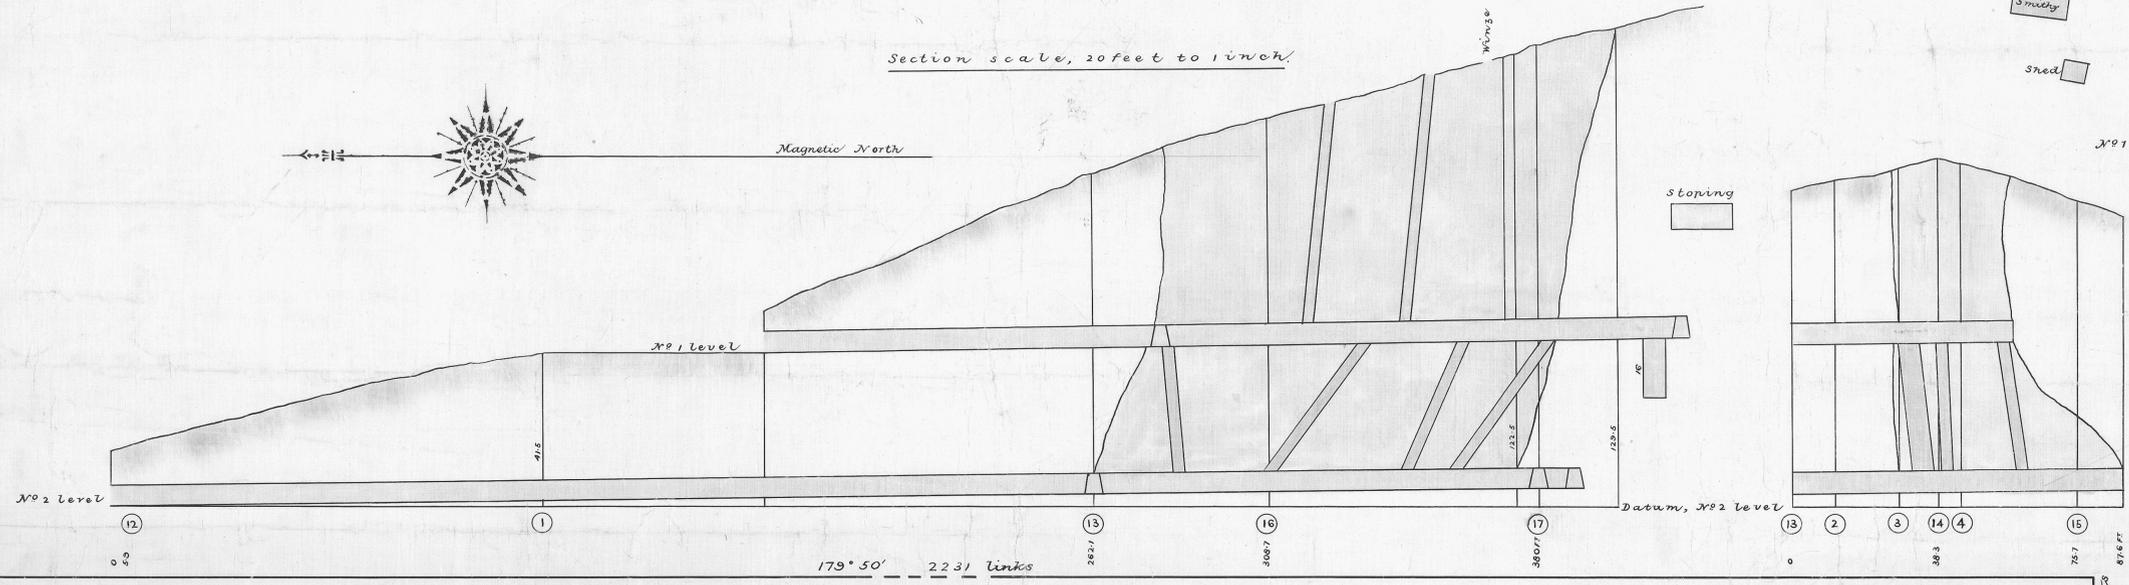

Wray & Sons
Minesurveyors
31st January 1901



127-03

127-03

88