

— RINGAROOMA G. M. CO. —

 
LIMITED

— NEW MERCURY MINE WORKINGS —

COUNTY OF DORSET

PARISH OF ALBERTON

SCALE



631
93C
10

161
93C
5

633
93C
2



634
93C
2

683
93C
10

797
93C
10
Percy A. W. Jarvis
Auth. Surveyor
31st January 1901.

127-04

127-04

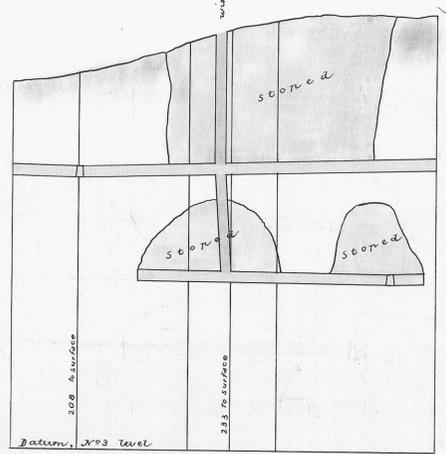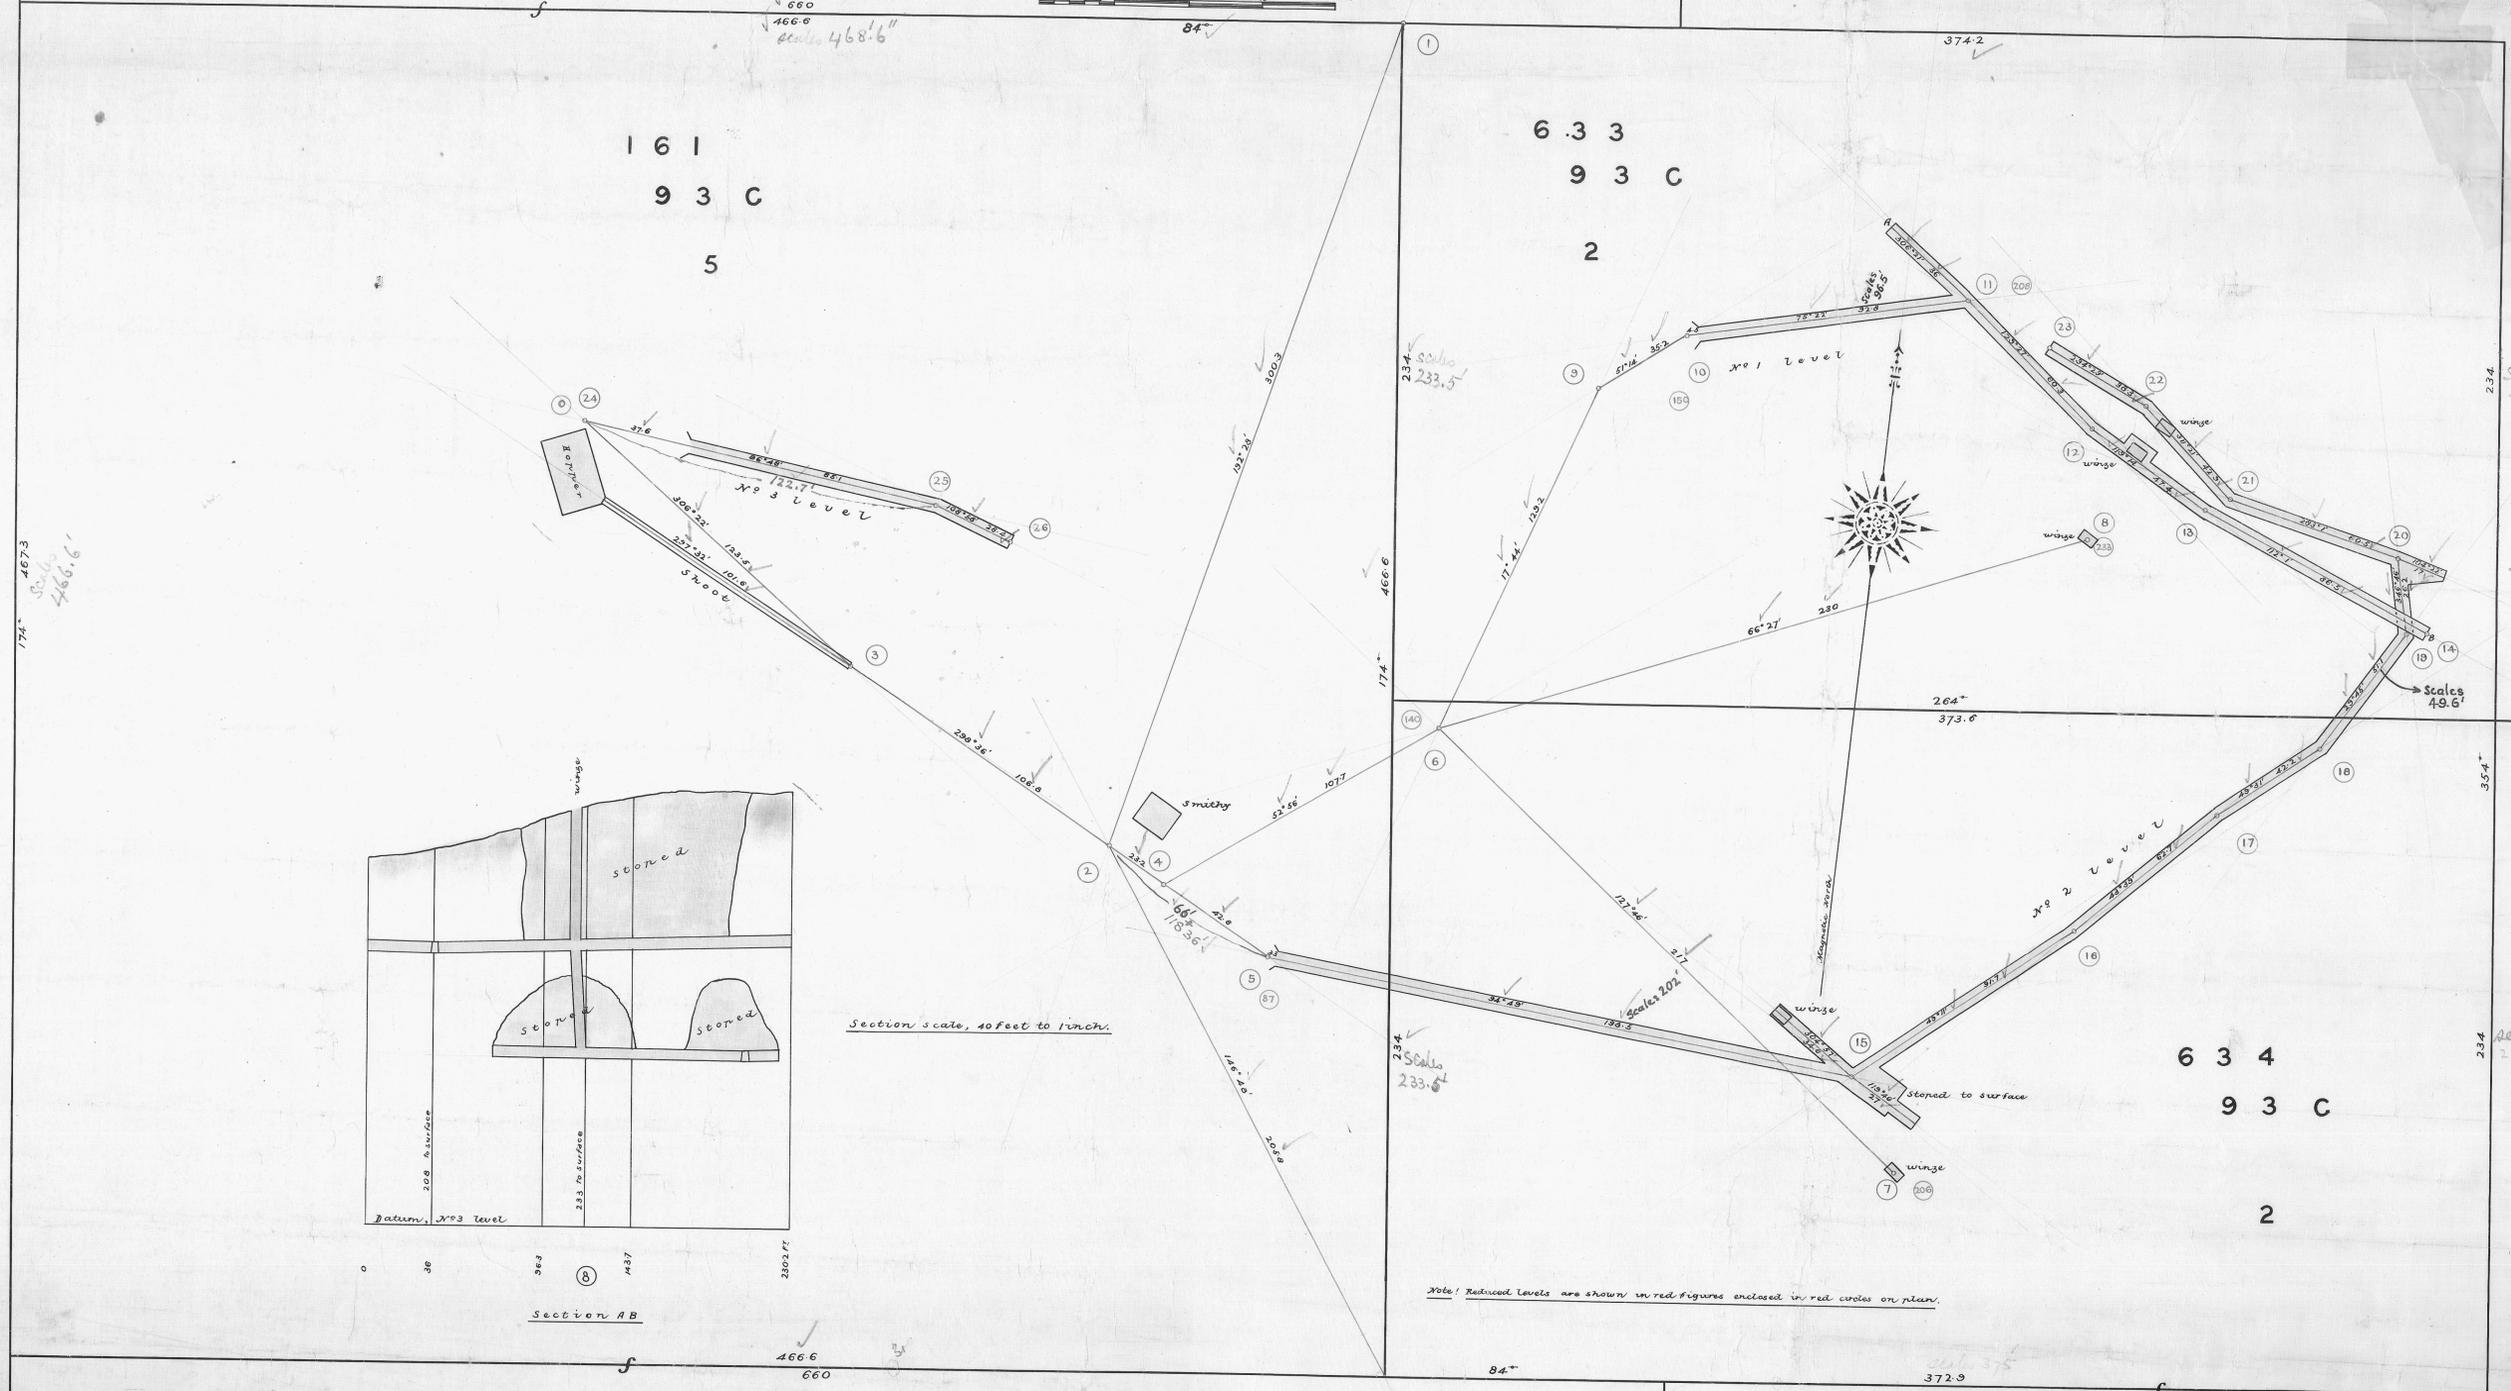

Section scale, 40 feet to inch.

Note! Reduced levels are shown in red figures enclosed in red circles on plan.

Handwritten notes in the top right corner.

Scale 1
233.3

Scale
233.3

174° 46' 73
Scale
466.6'

Scale
466.6
Scale
468.6'

Scale
233.5

Scale
233.6

Scale
372.9

Scale
49.6'