


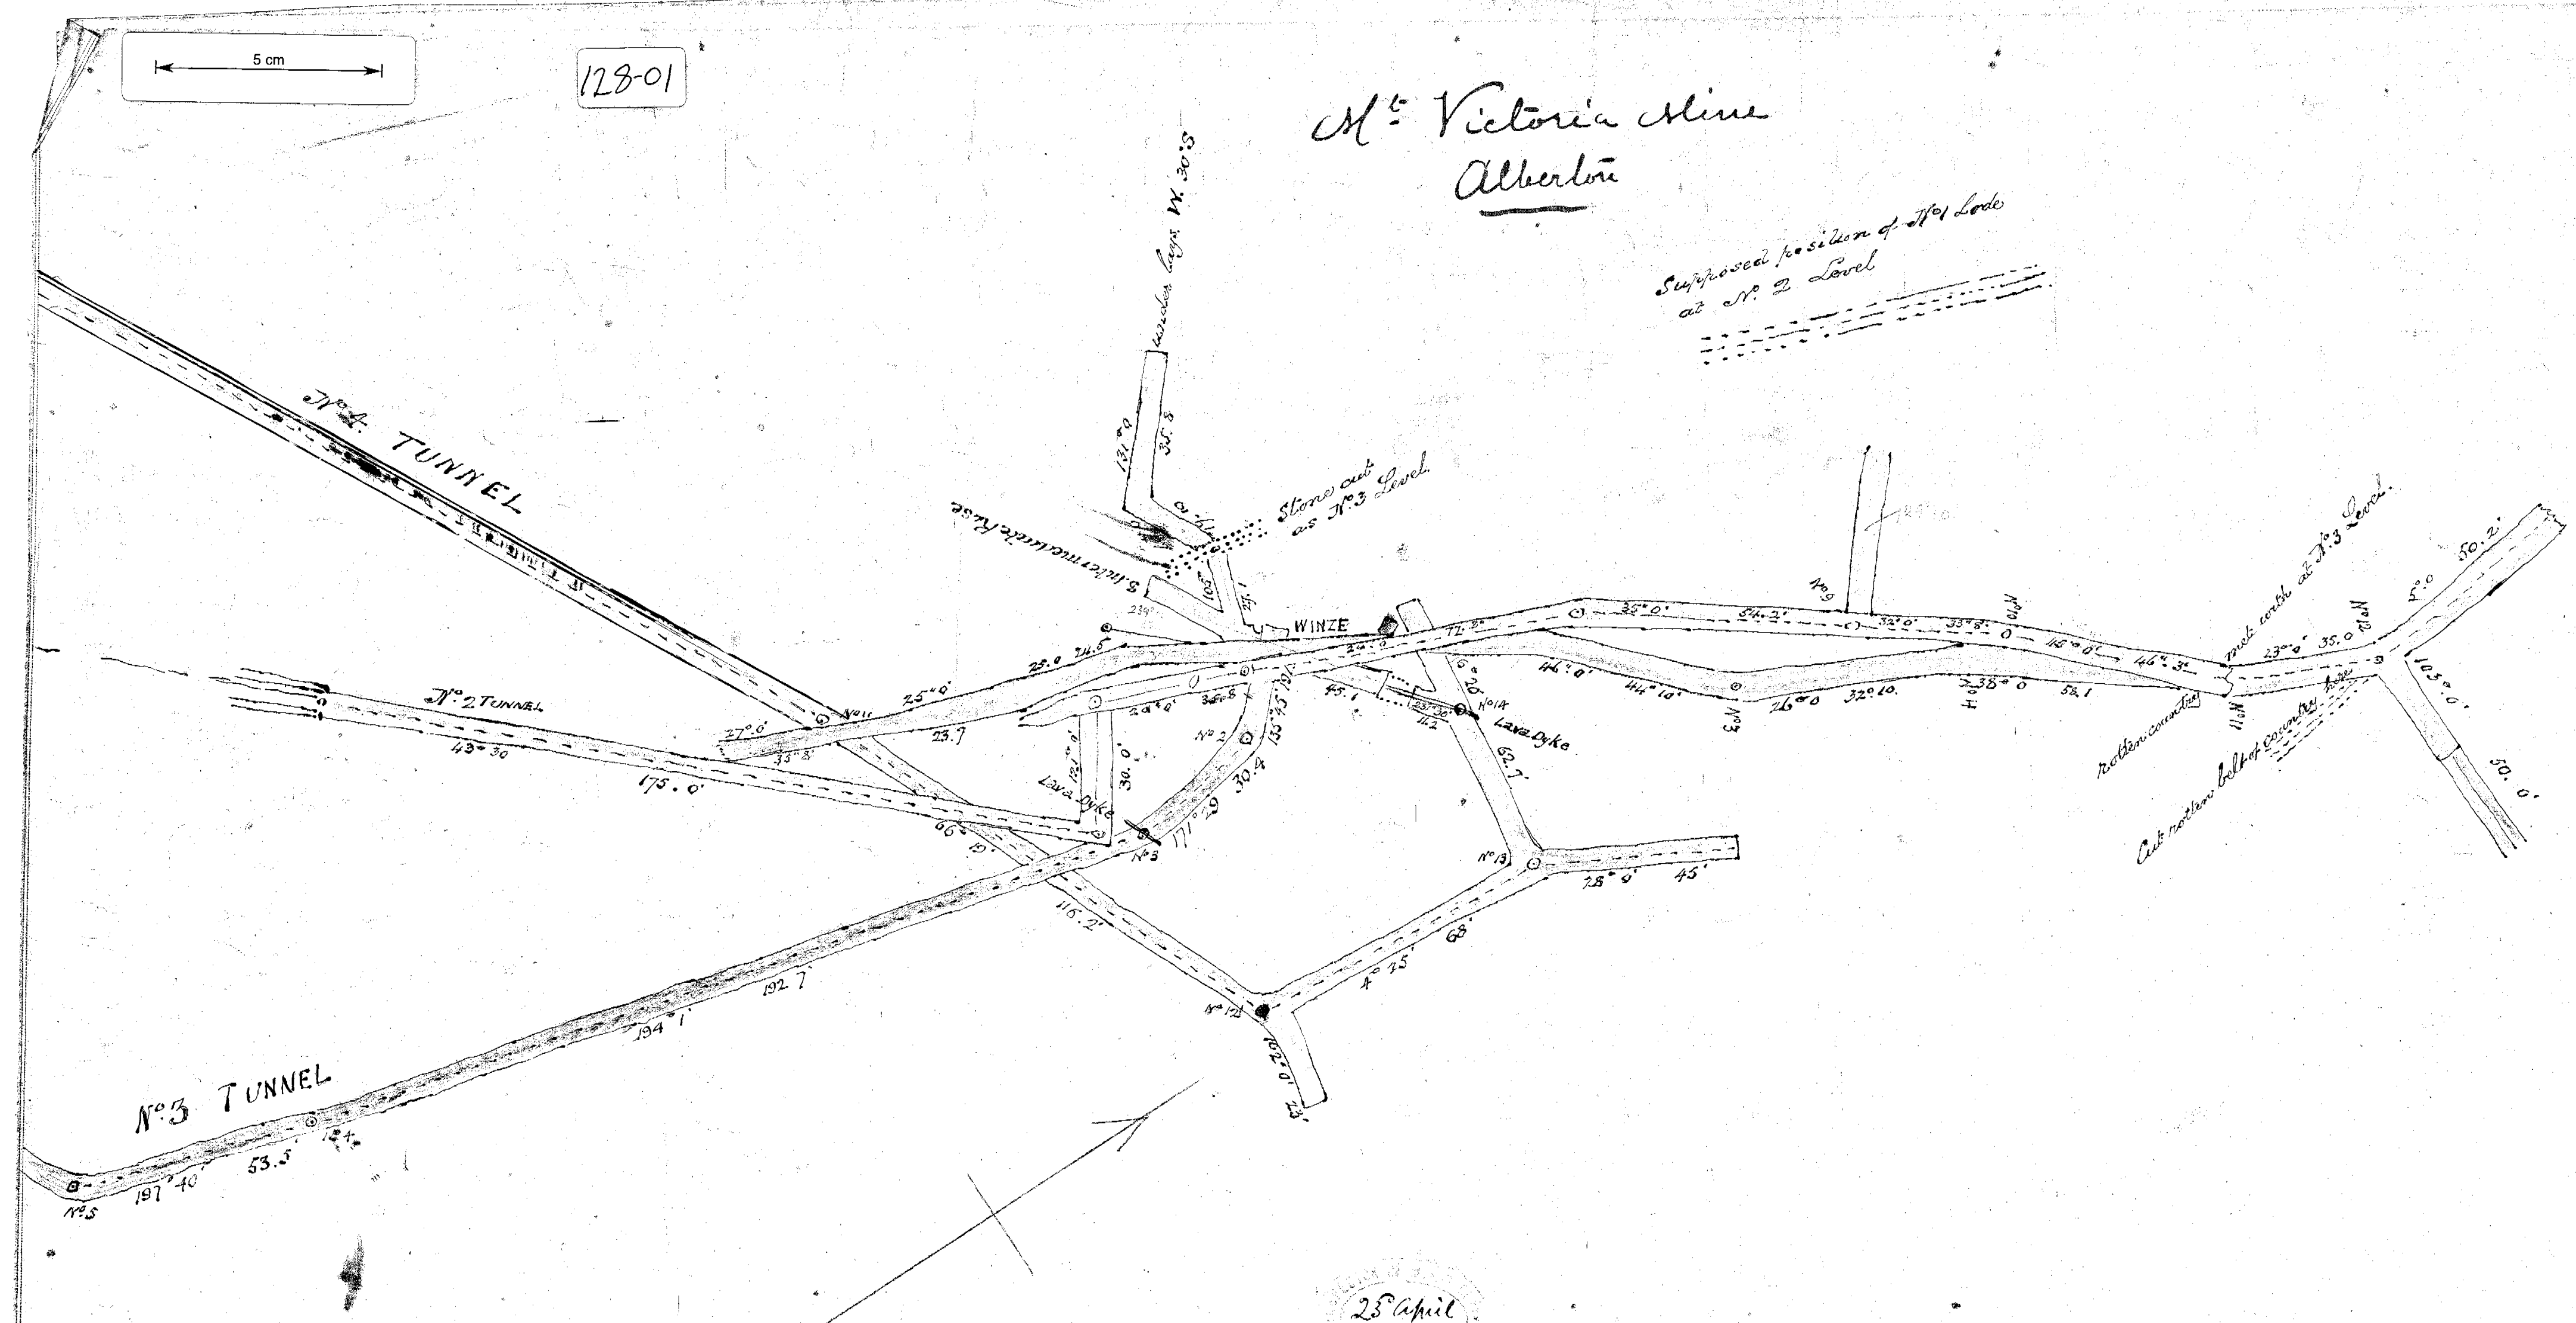

This Copy was given to me by Mr. R. Carter who retains the original map and was accepted as the best procurable under present circumstances -
J. Hartman
Inspector of Mines
23^d April 1895

1874