


M^T VICTORIA G.M.

CROSS-SECTION

Scale 25ft to an inch

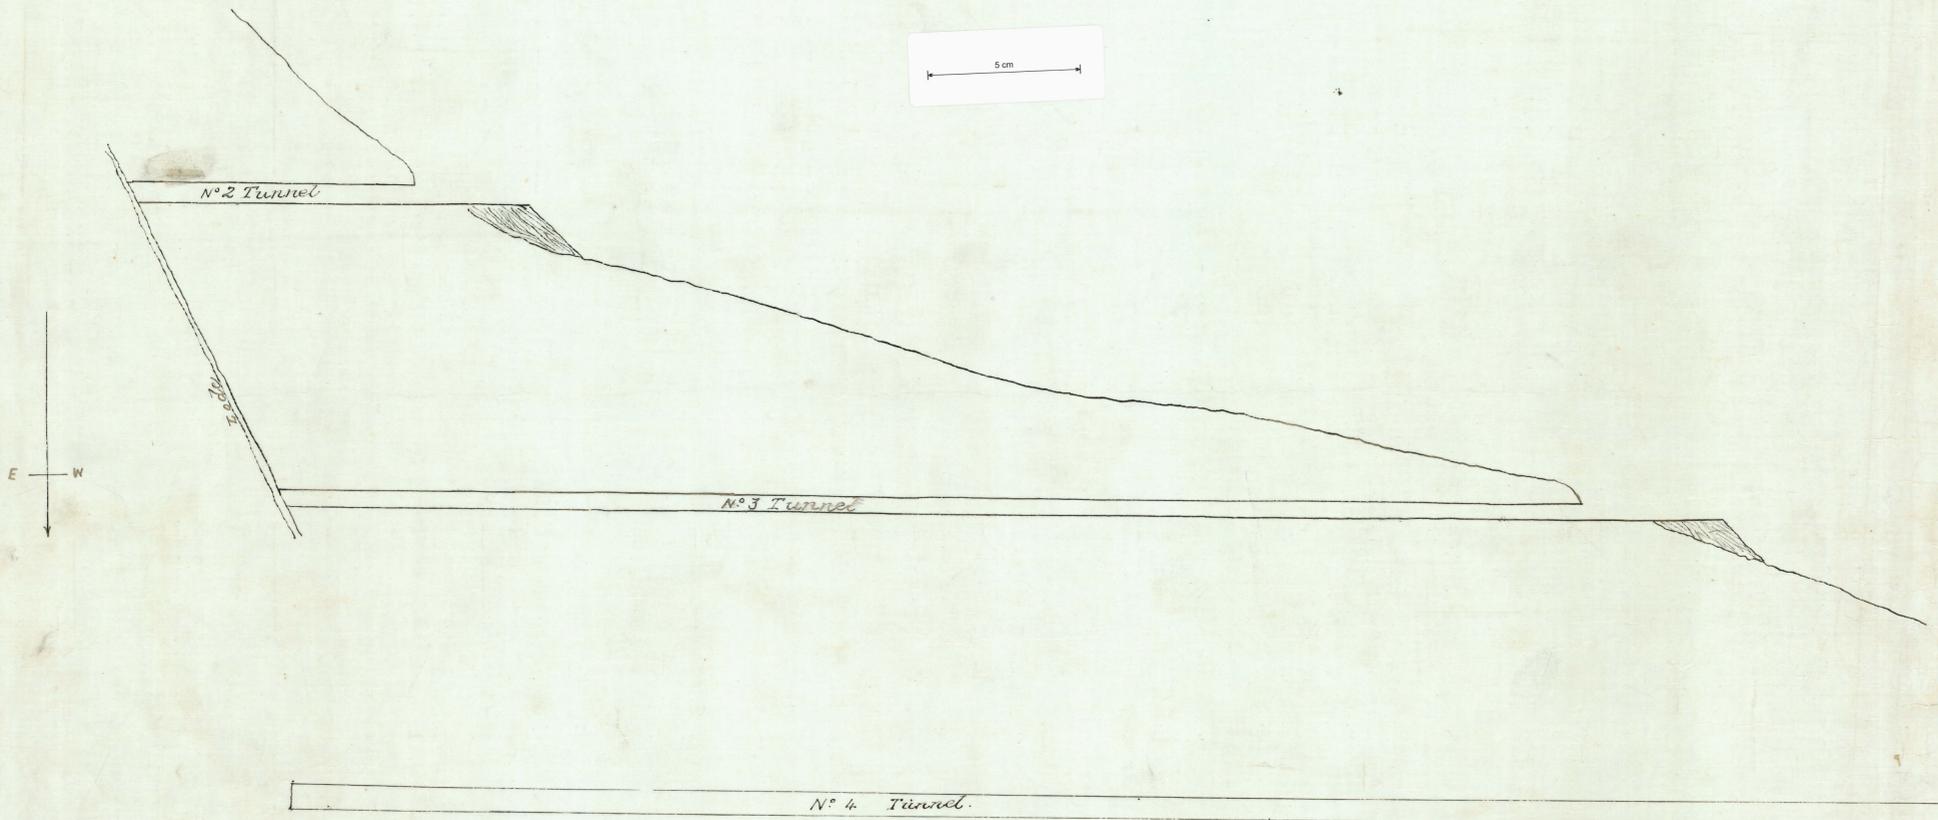

*This is correct copy
of plan of this section to end of year 1911
C. R. W. W. W. W.
R. W. W. W.*