


M^T VICTORIA G.M.

LONGITUDINAL SECTION.

Scale 25 ft. to an inch.

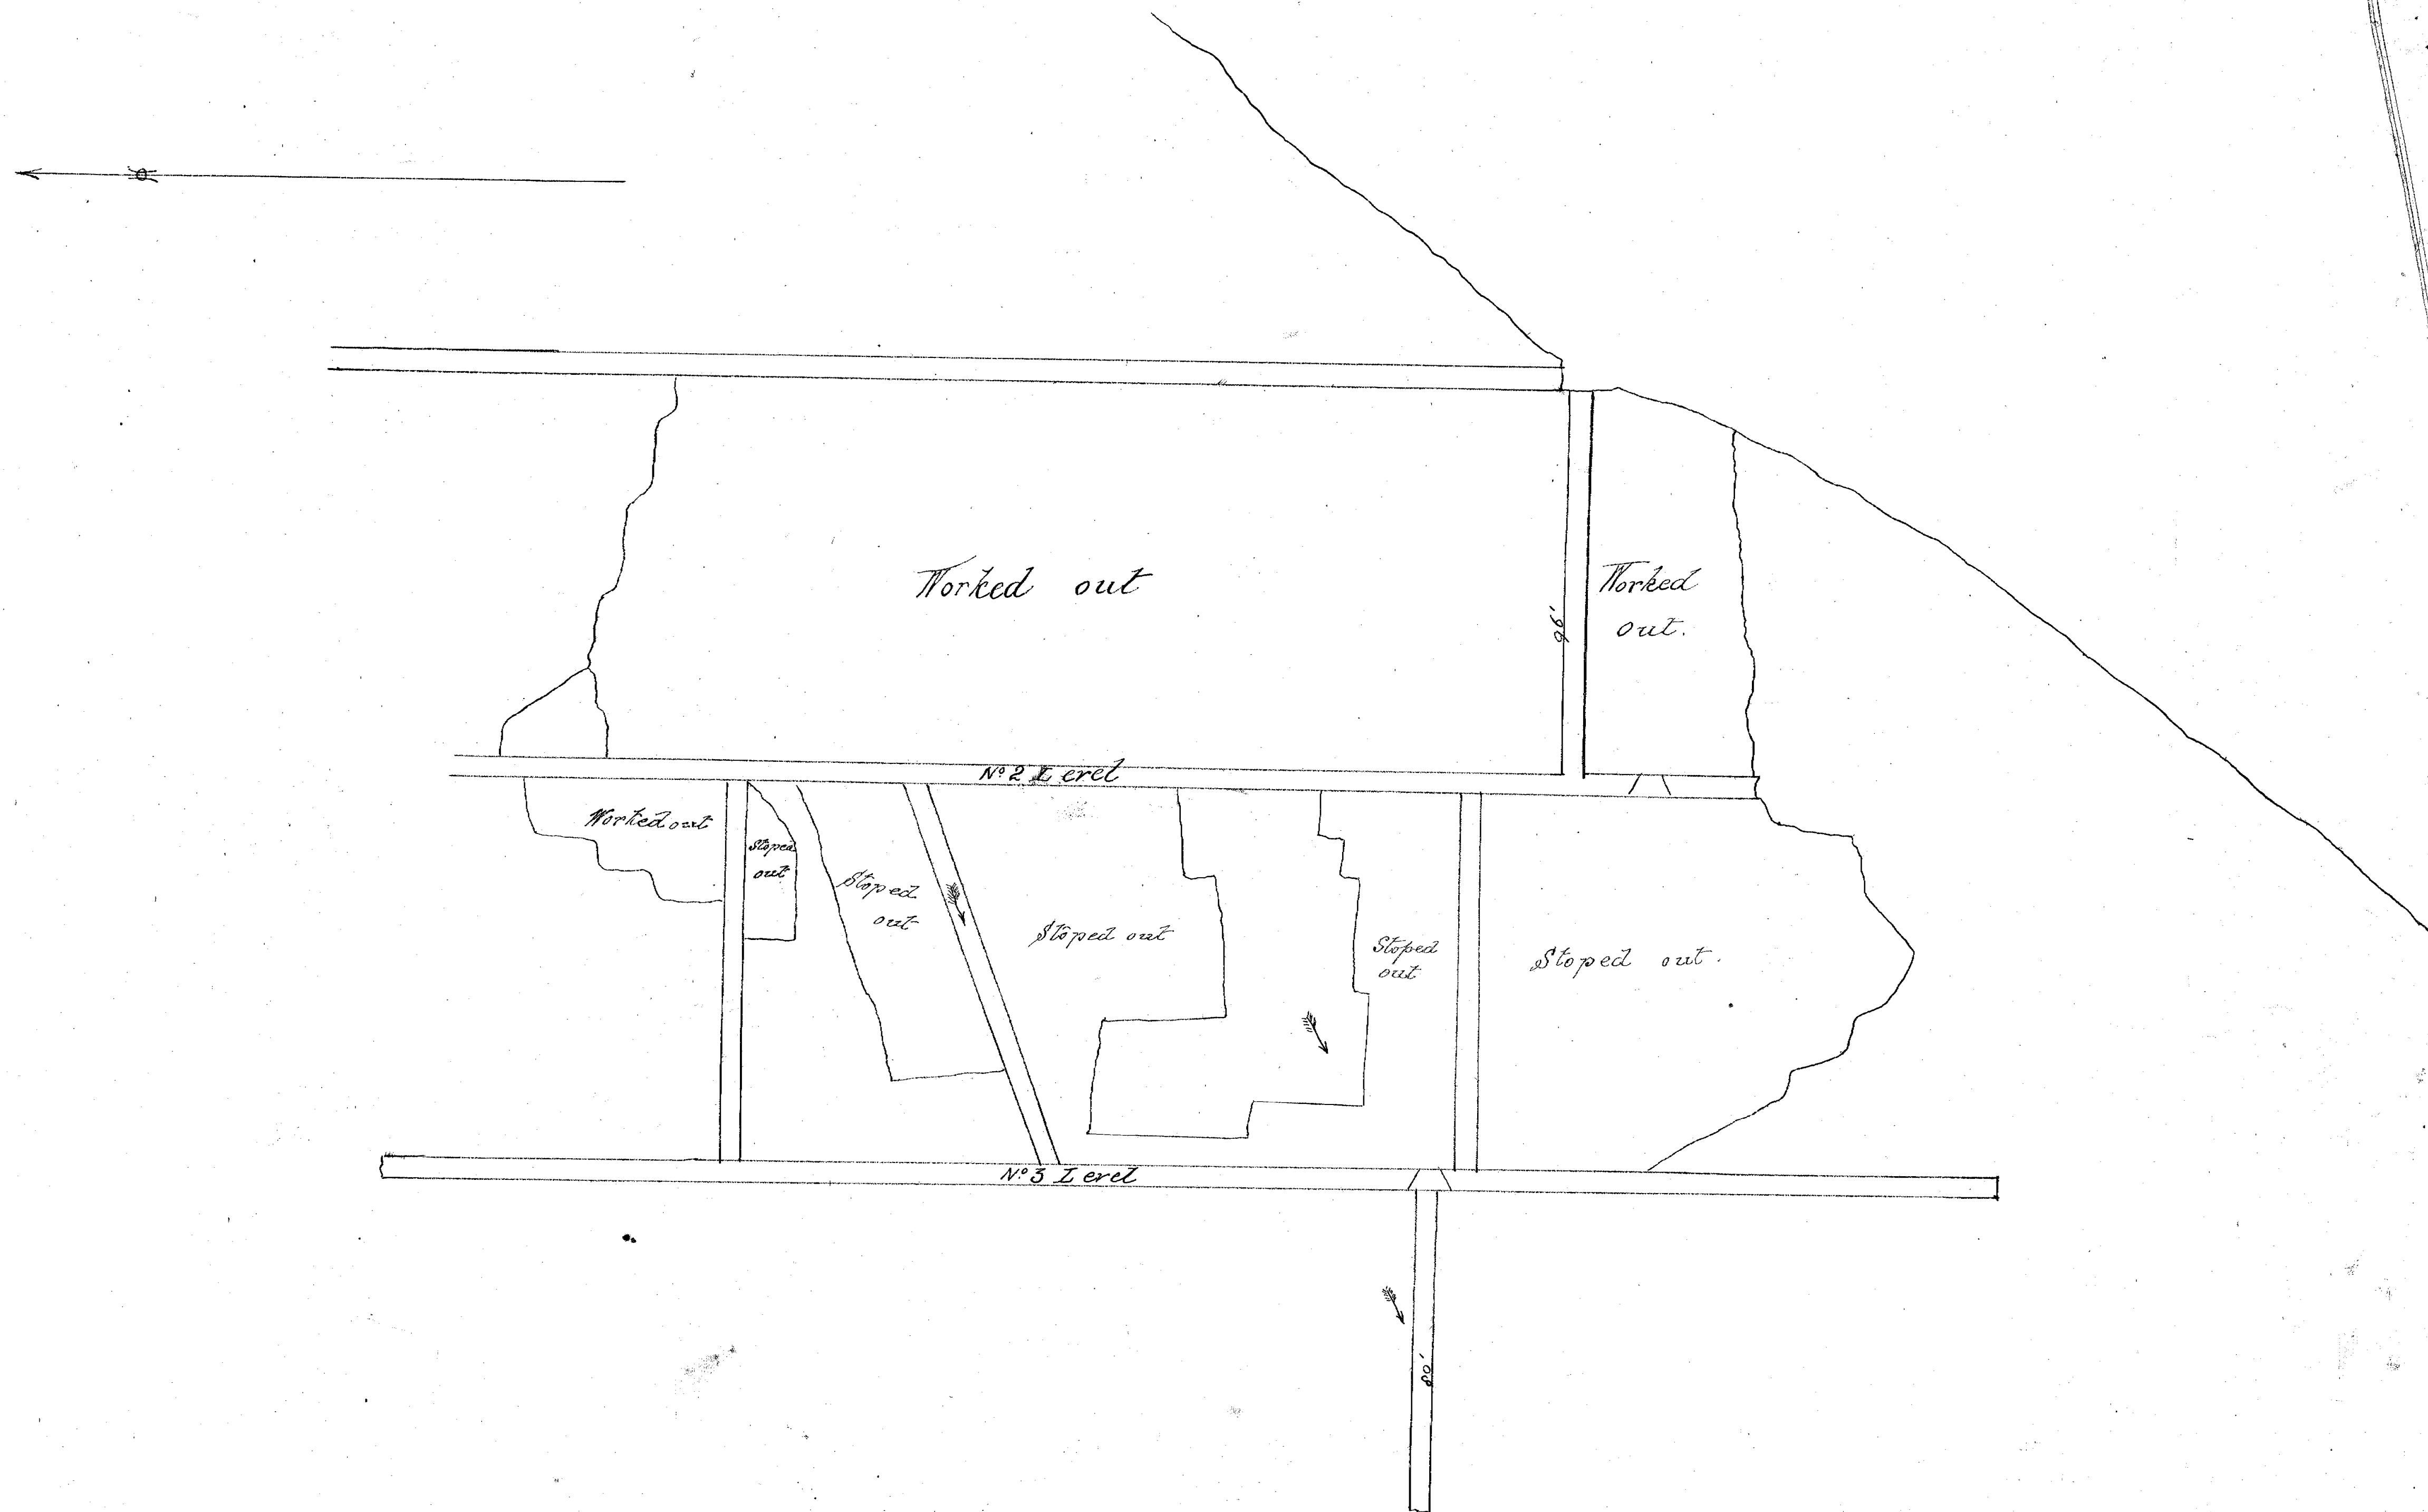

Verified correct copy
of work to end of year 1891.
C. Quincy Watson

C. Shirley Watson